
WIRELESS ACCESS POINT SCHEDULE


AP #	Mac Address	Asset Tag	LOCATION
AHS-H.AP_21	0023688B3A98	36075	RM 70_IDF-H
AHS-M.AP_22	002368931120	40789	Office_in_RM61_Bldg_G2
AHS-V.AP_23	002368930E58	40793	Small_Gym_Bldg_R
AHS-J.AP_24	002368930644	40783	RM42_IDF-J
AHS-X.AP_25	0023689309A8	36201	Girls_Locker_RM Bldg_H
AHS-U.AP_26	002368931144	40790	Boys_Locker_RM Bldg_J
AHS-S.AP_27	002368931400	40791	MPR_IDF-S
AHS-S.AP_28	002368930948	40786	RM 200_Kitchen
AHS-R.AP_30	002368930AF0	40779	RM70_IDF-R
AHS-A.AP_31	002368930B94	40787	Admin_Bldg
AHS-Y.AP_32	0023689313D4	40781	RM91_IDF-Y
AHS-O.AP_33	002368930B4C	40780	RM77_IDF-O
AHS-V.AP_34	002368930B1C	40782	Gym_Bldg_R
AHS-Q.AP_35	002368930C18	40776	RM76_IDF-Q
AHS-T.AP_36	002368931034	40784	RM216_IDF-T
AHS-Q.AP_37	002368931180	40778	RM73_IDF-Q
AHS Y.AP_38	002368931350	40774	RM95_IDF Y
AHS-I.AP_39	002368930AF8	40775	RM40_IDF-I
AHS-Y.AP_41	002368930C38	40807	RM94_Bldg_I
AHS-A.AP_42	0023689313DC	40808	Admin
AHS-W.AP_43	002368930CE0	40803	Portable_IDF-W
AHS-O.AP_45	002368930CBC	40805	RM79_IDF-0
AHS-K.AP_46	002368930C84	40797	RM45_IDF-K
AHS B.AP_47	002368930618	40798	RM2_IDF B
AHS-E.AP_49	002368930660	40800	RM17_Bldg_B
AHS-D.AP_50	002368930AA0	40801	RM 13_BldgB
AHS-F.AP_51	0023689306BC	40799	RM 26_BldgC
AHS-D.AP_52	002368930C54	40812	RM 10_Bldg_B
AHS-V.AP_53	002368930D94	40813	Gym_Bldg_R
AHS-MDF.AP_56	002368930F44	40796	Library
AHS-R.AP_58	002368930E38	40810	RM 72_IDF-R
AHS-H.AP_59	002368931328	36047	RM 33_Bldg_D
AHS-H.AP_60	002368930D20	36048	RM 36_Bldg_D
AHS-J.AP_62	002368930DAC	36053	RM 41_IDF-J
AHS-Y.AP_63	002368930EBC	40811	Woodshop_Bldg_I
AHS-G.AP_64	002368930A30	36046	RM 30_IDF-G
AHS-C.AP_65	002368930E80	36049	RM 7_IDF-C
AHS-F.AP_66	0023689309F0	36043	RM 23_IDF-F
AHS-S.AP_68	002358930BE4	36042	Kitchen Lounge
AHS-CC.AP_69	002368930c94	36086	Career-Center-IDF-CC
AHS-MDF.AP_70	002368930a08	36085	RM 2 IDF-B
AHS-L.AP_71	002368930cb0	40802	RM 62_IDF-L
AHS-L.AP_72	0023688B3F70	36083	RM 64_IDF-L
AHS-N.AP_73	00236893119C	36082	RM 65_IDF-N
AHS-AA.AP_74	0023689309A4	40806	RM 70_IDF-AA
AHS-AA.AP_75	0023688B3AB0	36087	RM 22_IDF-AA
AHS-AA.AP_76	0023684461ED0	36090	RM 23_IDF-AA
AHS-AA.AP_77	002368930CA8	36189	RM 26_IDF-AA
AHS-AA.AP_78	002368930BB4	36091	RM 27_IDF-AA
AHS-AA.AP_79	00236841DC10	36141	RM 29_IDF-AA
AHS-BB.AP_80	002368930DCC	40794	RM 200_IDF-BB
AHS-BB.AP_81	002368930CB4	36196	RM 202_IDF-BB
AHS-BB.AP_82	002368461CF8	36097	RM 203_IDF-BB
AHS-BB.AP_83	00236834F118	41002	RM 206_IDF-BB
AHS-BB.AP_84	00236834F03C	41003	RM 207_IDF-BB
AHS-BB.AP_85	002368930C7C	36199	RM 209_IDF-BB

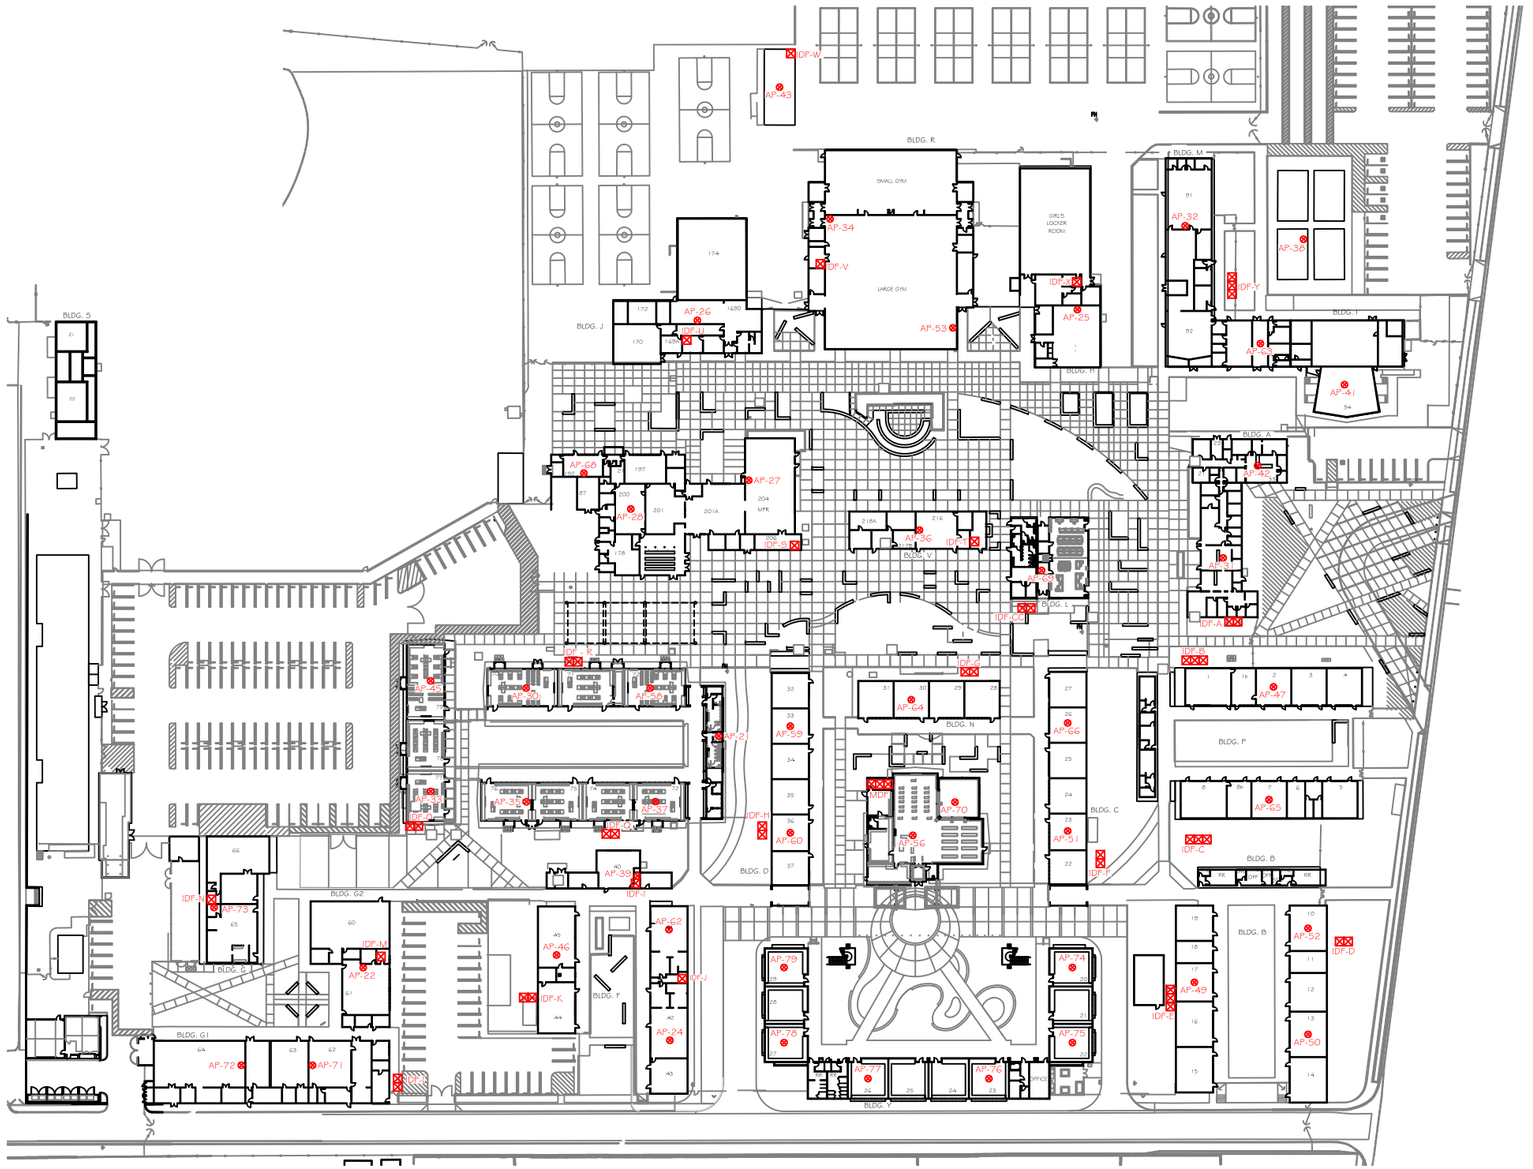

WIRELESS ACCESS POINT PLAN
SCALE: 1" = 120'-0"

LEGEND

WIRELESS ACCESS POINT

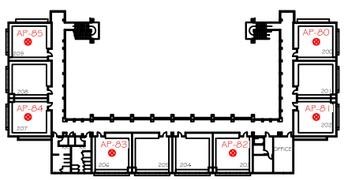

BUILDING Y - SECOND FLOOR

EASYNETWORKS CABLING
3538 SHELLEY WAY
RIVERSIDE, CA. 92503
OFFICE : 951. 742.8119
FAX : 951.742.8125
ST. LIC. # 936770

PREPARED FOR:

EL MONTE UNION HIGH SCHOOL DISTRICT

SITE:

ARROYO HIGH SCHOOL

4921 CEDAR AVENUE
EL MONTE, CA 91732

AS-BUILT
PROJECT NO. 5231

REVISIONS:

	DATE:	DESCRIPTION:

DRAWN BY:
GERARDO MORALES

DATE: 10/9/12
SCALE: AS SHOWN
SIZE: 11x17

TITLE:

WIRELESS ACCESS POINT PLAN


● PROPERTY OF EASY NETWORKS ●
● FOR USE BY EASY NETWORK ONLY ●

SHEET#:

T1

1 OF 29

EASY NETWORKS - 5224, 10/17/2012 5:01:50 PM, 11 x 17

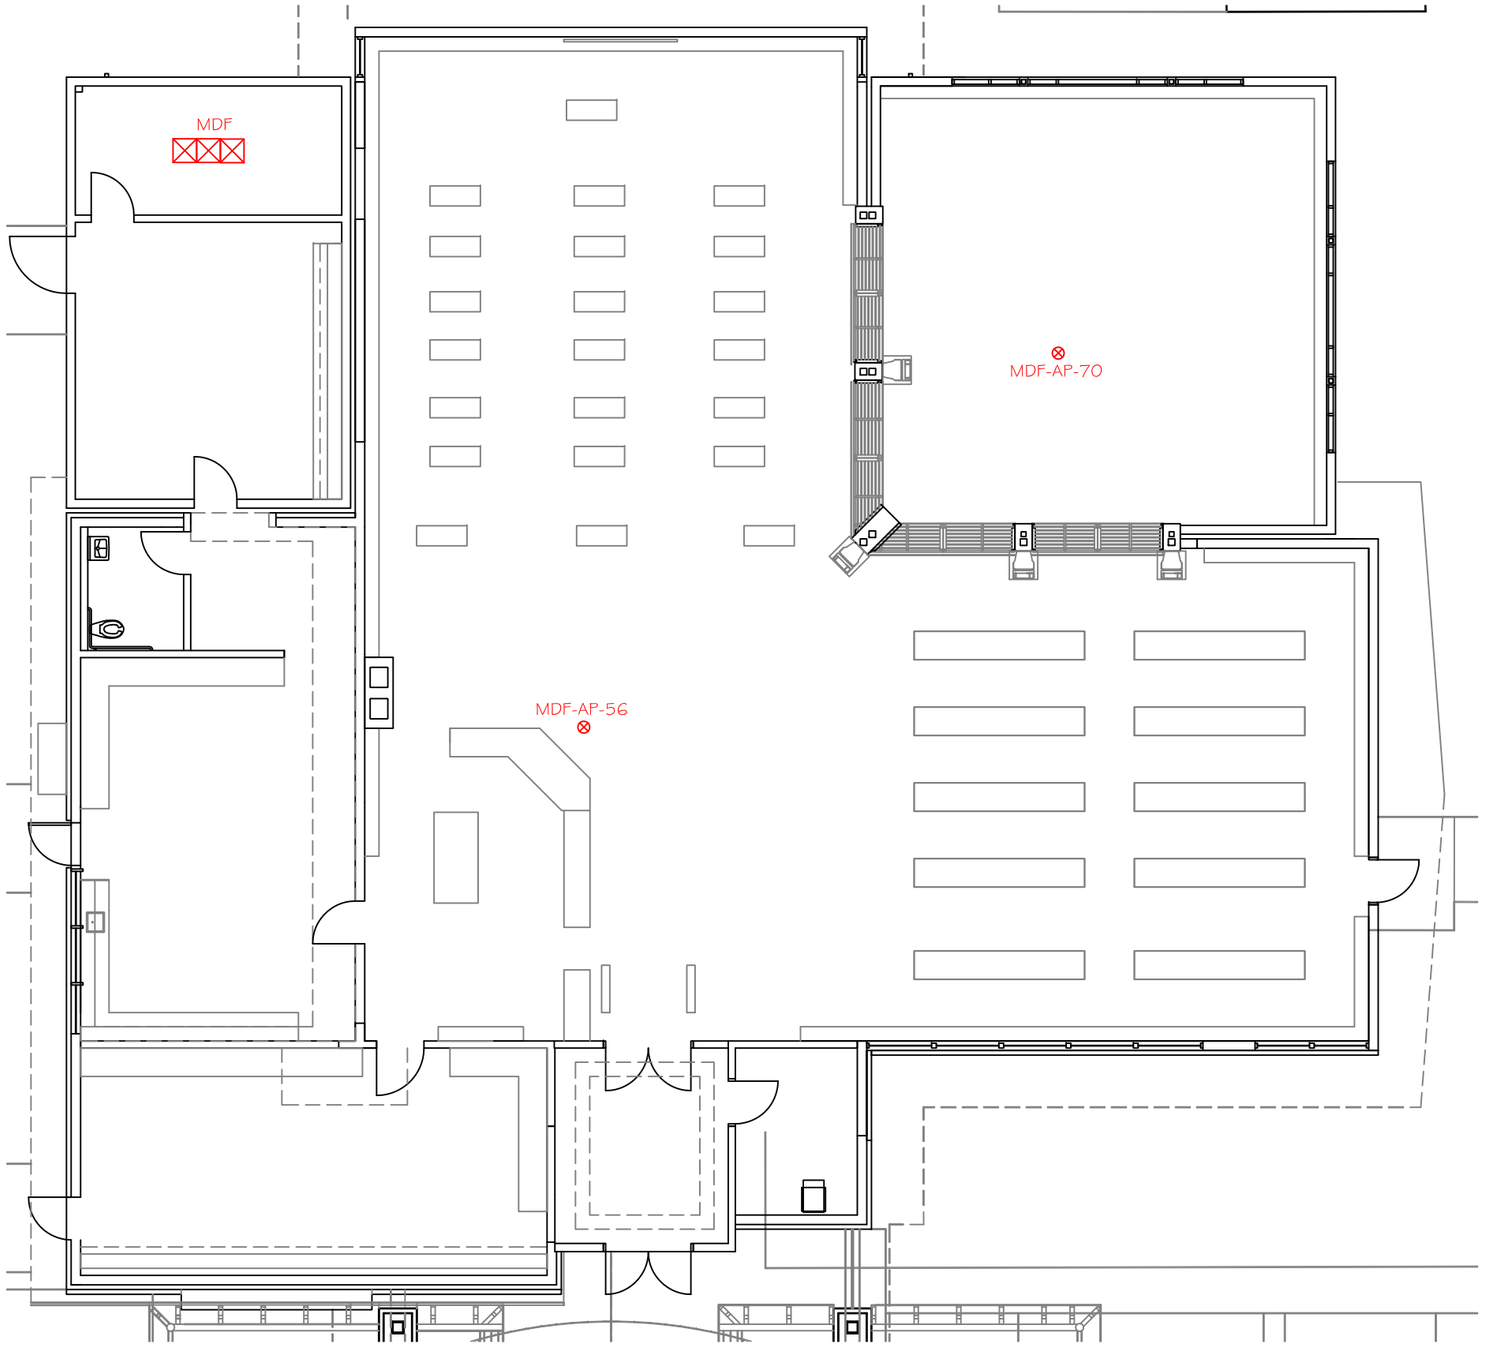


MDF - WIRELESS ACCESS POINT PLAN

SCALE: 3/32" = 1'-0"

LEGEND

⊗ WIRELESS ACCESS POINT

KEYMAP
NTS

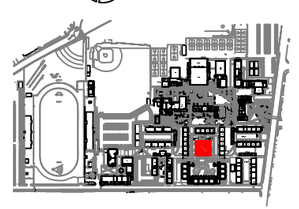

EASYNETWORKS CABLING
3538 SHELLEY WAY
RIVERSIDE, CA. 92503
OFFICE : 951. 742.8119
FAX : 951.742.8125
ST. LIC. # 936770

PREPARED FOR:

EL MONTE UNION HIGH SCHOOL DISTRICT

SITE:

ARROYO HIGH SCHOOL

4921 CEDAR AVENUE
EL MONTE, CA 91732

AS-BUILT
PROJECT NO. 5231

REVISIONS:

#	DATE:	DESCRIPTION:

DRAWN BY:
GERARDO MORALES

DATE: 10/9/12
SCALE: AS SHOWN
SIZE: 11x17

TITLE:

MDF WIRELESS ACCESS POINT PLAN


• PROPERTY OF EASY NETWORKS •
• FOR USE BY EASY NETWORK ONLY •

SHEET#:

T2

2 OF 29

EASY NETWORKS - 5231 MDF, 10/17/2012 5:01:39 PM, 11 x 17

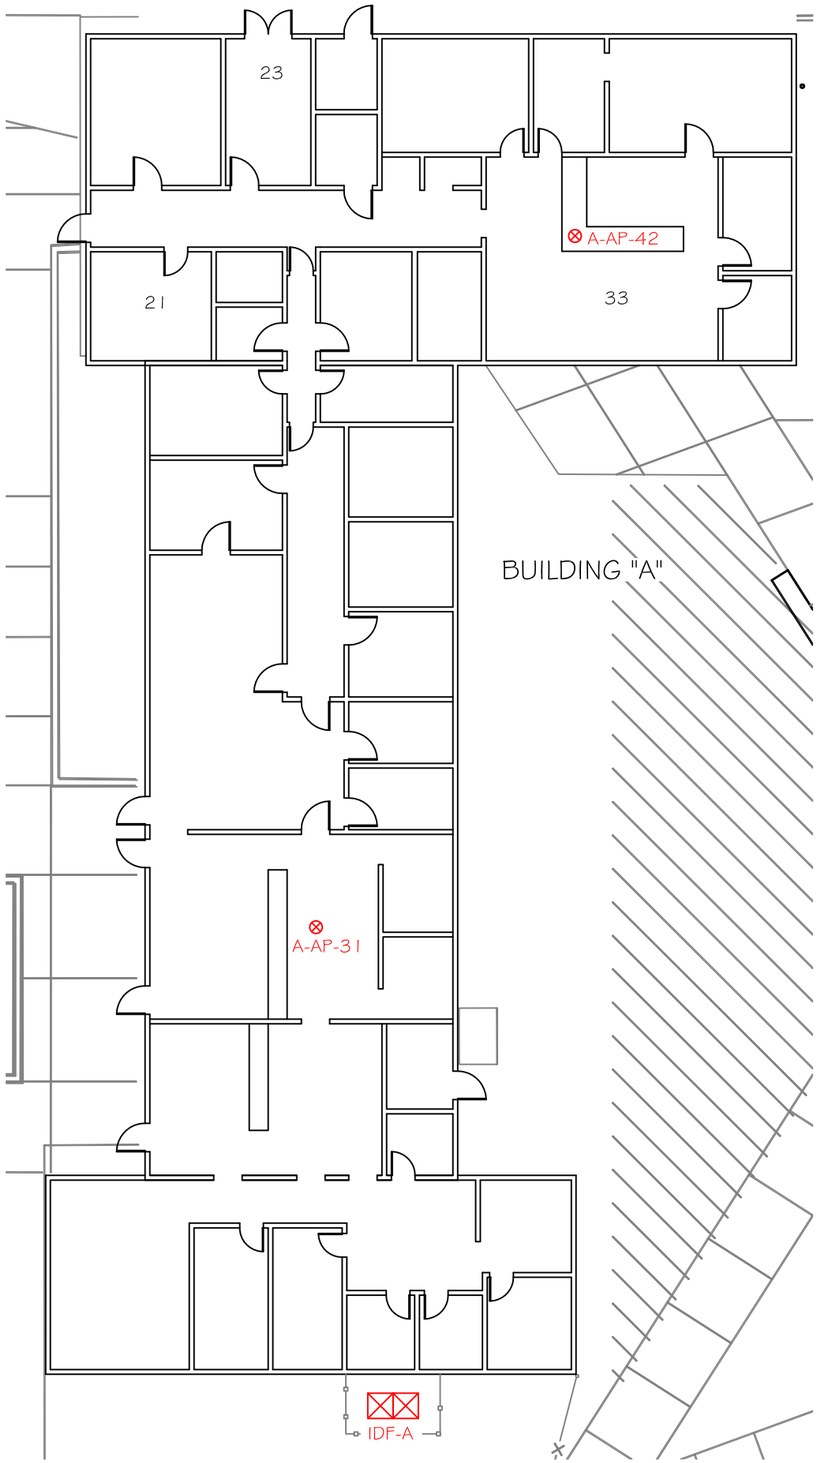

IDF-A - WIRELESS ACCESS POINT PLAN

SCALE: 1/16" = 1'-0"

LEGEND

⊗ WIRELESS ACCESS POINT

KEYMAP
NTS



EASYNETWORKS CABLING
3538 SHELLEY WAY
RIVERSIDE, CA. 92503
OFFICE : 951. 742.8119
FAX : 951.742.8125
ST. LIC. # 936770

PREPARED FOR:

EL MONTE UNION HIGH SCHOOL DISTRICT

SITE:

ARROYO HIGH SCHOOL

4921 CEDAR AVENUE
EL MONTE, CA 91732

AS-BUILT
PROJECT NO. 5231

REVISIONS:

	DATE:	DESCRIPTION:

DRAWN BY: GERARDO MORALES

DATE: 10/9/12
SCALE: AS SHOWN
SIZE: 11x17

TITLE:

IDF-A WIRELESS ACCESS POINT PLAN


● PROPERTY OF EASY NETWORKS ●
● FOR USE BY EASY NETWORK ONLY ●

SHEET#:

T3

3 OF 29

EASY NETWORKS - 5231 IDF A, 10/17/2012 5:01:30 PM, 11 x 17

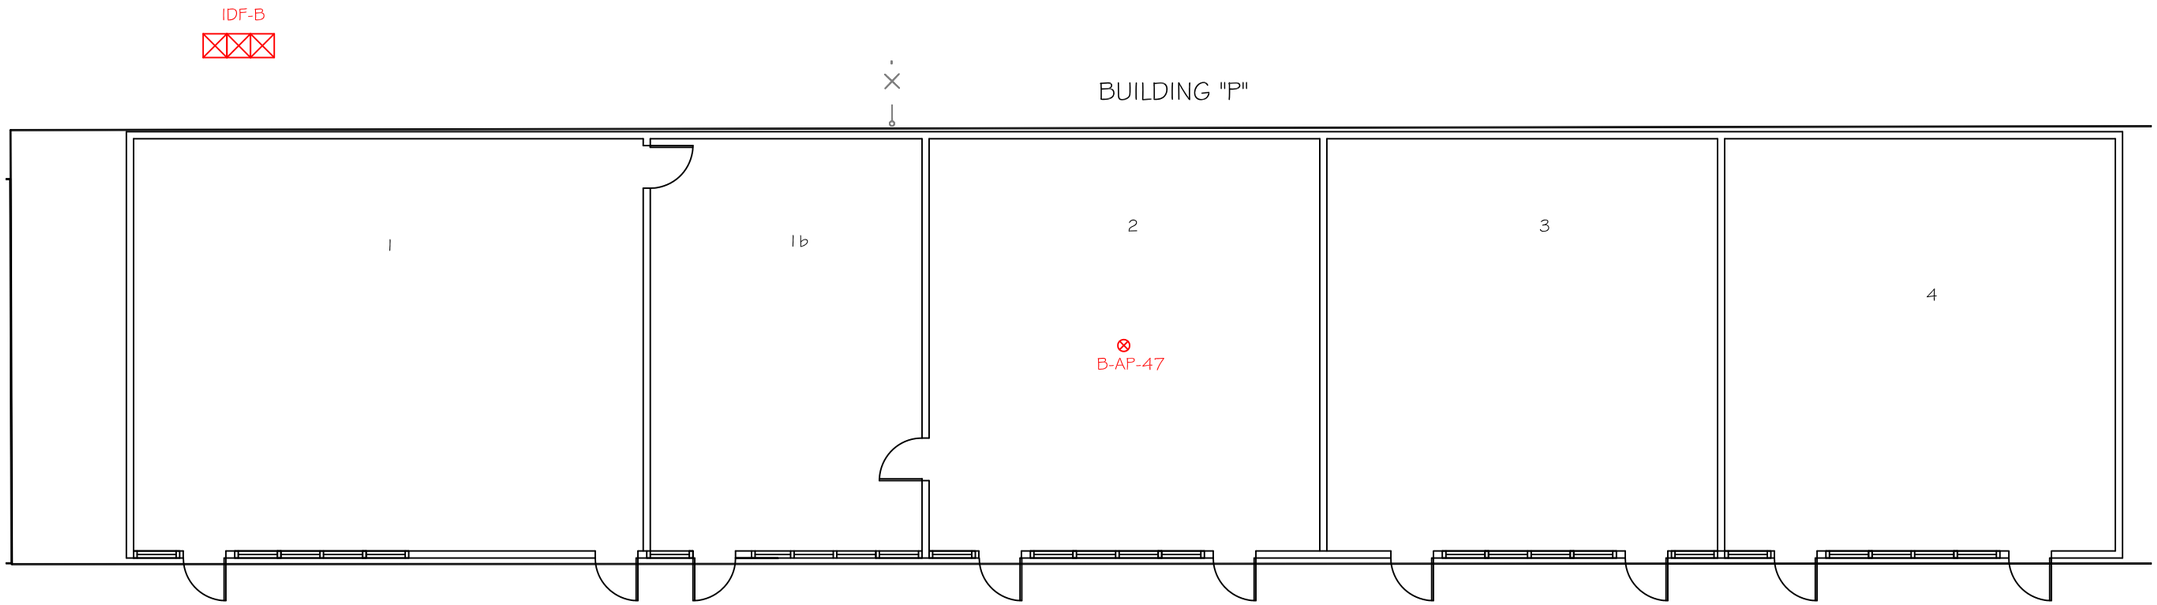


IDF-B - WIRELESS ACCESS POINT PLAN

SCALE: 3/32" = 1'-0"

LEGEND

⊗ WIRELESS ACCESS POINT

KEYMAP
NTS

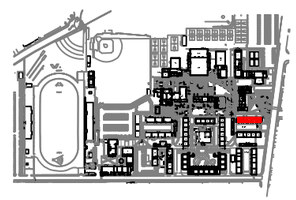

EASYNETWORKS CABLING
3538 SHELLEY WAY
RIVERSIDE, CA. 92503
OFFICE : 951. 742.8119
FAX : 951.742.8125
ST. LIC. # 936770

PREPARED FOR:

EL MONTE UNION HIGH SCHOOL DISTRICT

SITE:

ARROYO HIGH SCHOOL

4921 CEDAR AVENUE
EL MONTE, CA 91732

AS-BUILT
PROJECT NO. 5231

REVISIONS:

	DATE:	DESCRIPTION:
1		

DRAWN BY: GERARDO MORALES

DATE: 10/9/12
SCALE: AS SHOWN
SIZE: 11x17

TITLE:


IDF-B WIRELESS ACCESS POINT PLAN

● PROPERTY OF EASY NETWORKS ●
● FOR USE BY EASY NETWORK ONLY ●

SHEET#:

T4

EASY NETWORKS - 5231 IDF B, 10/17/2012 5:01:20 PM, 11 x 17

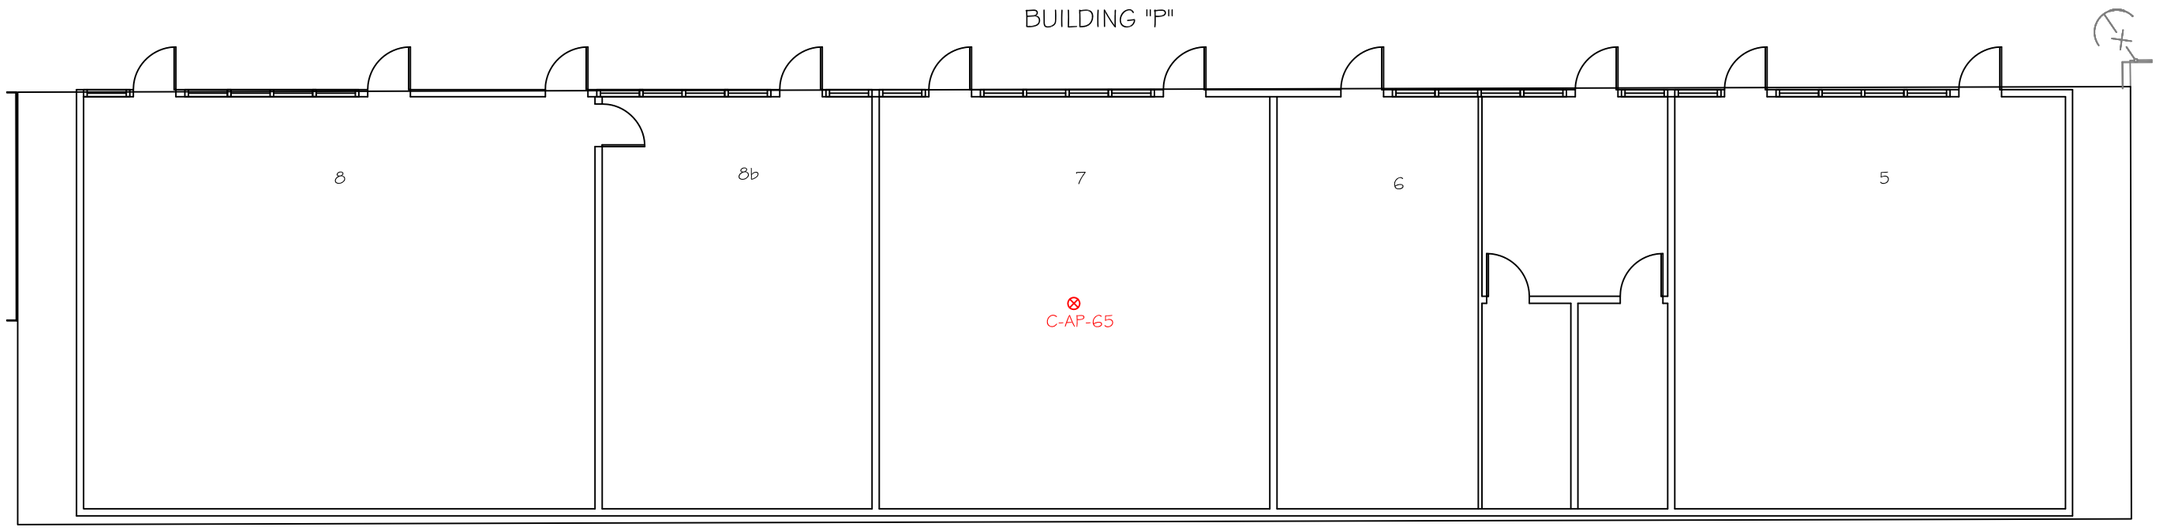

IDF-C - WIRELESS ACCESS POINT PLAN


SCALE: 3/32" = 1'-0"

IDF-C

LEGEND

⊗ WIRELESS ACCESS POINT

KEYMAP
NTS

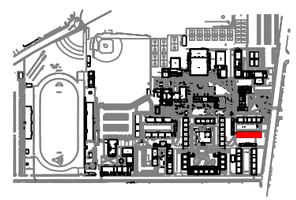

EASYNETWORKS CABLING
3538 SHELLEY WAY
RIVERSIDE, CA. 92503
OFFICE : 951. 742.8119
FAX : 951.742.8125
ST. LIC. # 936770

PREPARED FOR:

EL MONTE UNION HIGH SCHOOL DISTRICT

SITE:

ARROYO HIGH SCHOOL

4921 CEDAR AVENUE
EL MONTE, CA 91732

AS-BUILT
PROJECT NO. 5231

REVISIONS:

	DATE:	DESCRIPTION:
1		

DRAWN BY: GERARDO MORALES

DATE: 10/9/12
SCALE: AS SHOWN
SIZE: 11x17

TITLE:

IDF-C WIRELESS ACCESS POINT PLAN


● PROPERTY OF EASY NETWORKS ●
● FOR USE BY EASY NETWORK ONLY ●

SHEET#:

T5

5 OF 29

EASY NETWORKS - 5231 IDF C, 10/17/2012 5:01:09 PM, 11 x 17

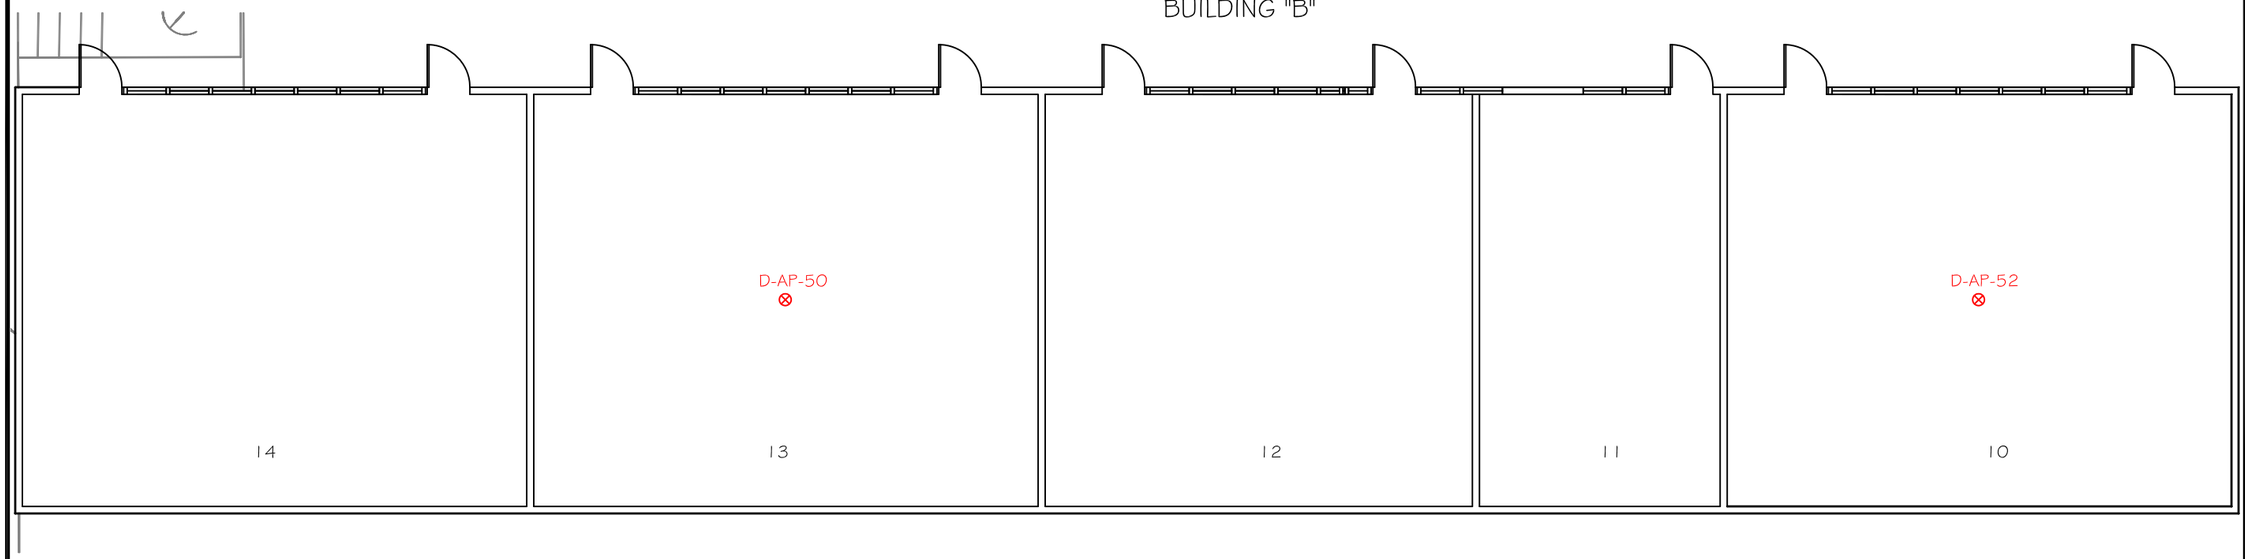

IDF-D - WIRELESS ACCESS POINT PLAN


SCALE: 3/32" = 1'-0"

IDF-D

LEGEND

⊗ WIRELESS ACCESS POINT

KEYMAP
NTS

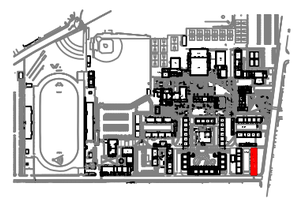

EASYNETWORKS CABLING
3538 SHELLEY WAY
RIVERSIDE, CA. 92503
OFFICE : 951.742.8119
FAX : 951.742.8125
ST. LIC. # 936770

PREPARED FOR:

EL MONTE UNION HIGH SCHOOL DISTRICT

SITE:

ARROYO HIGH SCHOOL

4921 CEDAR AVENUE
EL MONTE, CA 91732

AS-BUILT
PROJECT NO. 5231

REVISIONS:

	DATE:	DESCRIPTION:

DRAWN BY: GERARDO MORALES

DATE: 10/9/12
SCALE: AS SHOWN
SIZE: 11x17

TITLE:

IDF-D WIRELESS ACCESS POINT PLAN


● PROPERTY OF EASY NETWORKS ●
● FOR USE BY EASY NETWORK ONLY ●

SHEET#:

T6

6 OF 29

EASY NETWORKS - 5231 IDF D, 10/17/2012 5:00:59 PM, 11 x 17

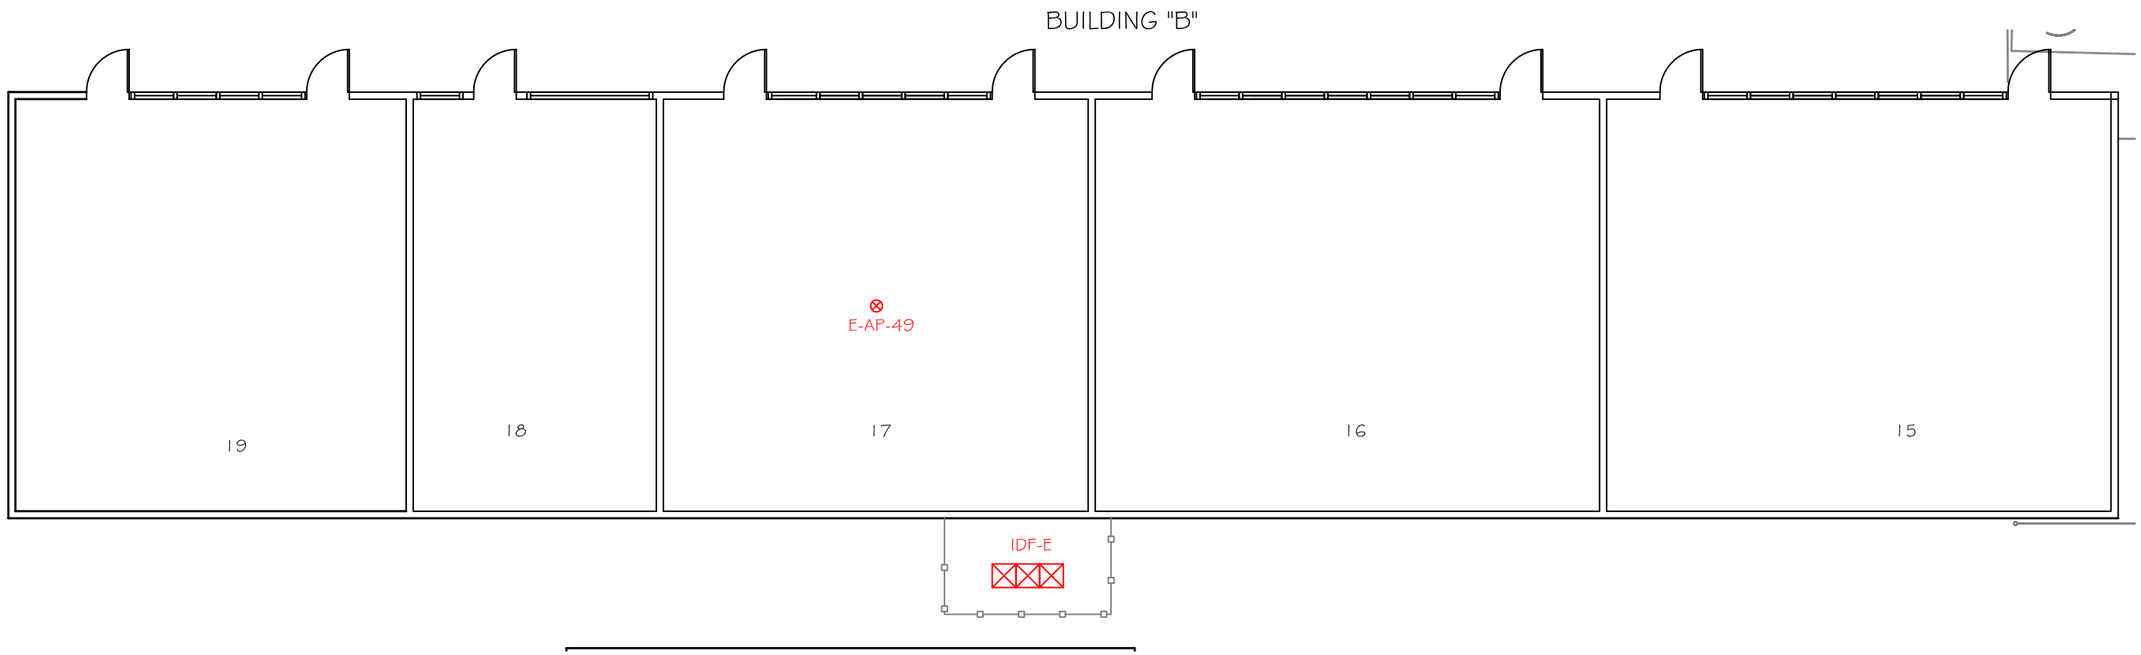


IDF-E - WIRELESS ACCESS POINT PLAN

SCALE: 3/32" = 1'-0"

LEGEND

⊗ WIRELESS ACCESS POINT

KEYMAP
NTS

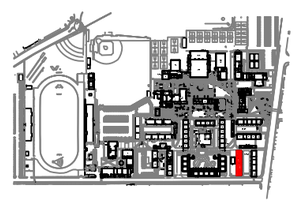

EASYNETWORKS CABLING
3538 SHELLEY WAY
RIVERSIDE, CA. 92503
OFFICE : 951. 742.8119
FAX : 951.742.8125
ST. LIC. # 936770

PREPARED FOR:

EL MONTE UNION HIGH SCHOOL DISTRICT

SITE:

ARROYO HIGH SCHOOL

4921 CEDAR AVENUE
EL MONTE, CA 91732

AS-BUILT
PROJECT NO. 5231

REVISIONS:

#	DATE:	DESCRIPTION:

DRAWN BY:
GERARDO MORALES

DATE: 10/9/12
SCALE: AS SHOWN
SIZE: 11x17

TITLE:

IDF-E WIRELESS ACCESS POINT PLAN


● PROPERTY OF EASY NETWORKS ●
● FOR USE BY EASY NETWORK ONLY ●

SHEET#:

T7

7 OF 29

EASY NETWORKS - 5231 IDF E, 10/17/2012 5:00:44 PM, 11 x 17

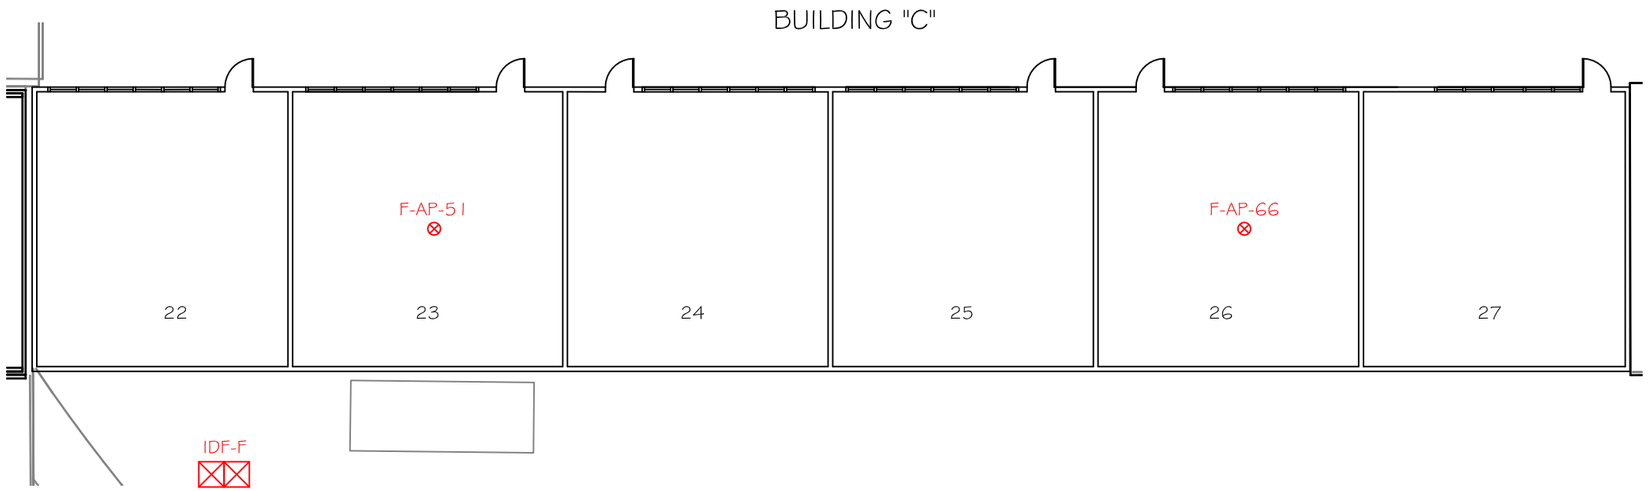


IDF-F - WIRELESS ACCESS POINT PLAN

SCALE: 1/16" = 1'-0"

LEGEND

⊗ WIRELESS ACCESS POINT

KEYMAP
NTS

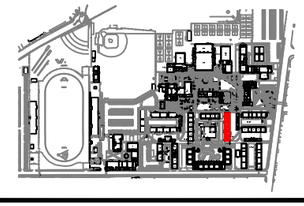

EASYNETWORKS CABLING
3538 SHELLEY WAY
RIVERSIDE, CA. 92503
OFFICE : 951. 742.8119
FAX : 951.742.8125
ST. LIC. # 936770

PREPARED FOR:

EL MONTE UNION HIGH SCHOOL DISTRICT

SITE:

ARROYO HIGH SCHOOL

4921 CEDAR AVENUE
EL MONTE, CA 91732

AS-BUILT
PROJECT NO. 5231

REVISIONS:

	DATE:	DESCRIPTION:
1		

DRAWN BY:
GERARDO MORALES

DATE: 10/9/12
SCALE: AS SHOWN
SIZE: 11x17

TITLE:

IDF-F WIRELESS ACCESS POINT PLAN


● PROPERTY OF EASY NETWORKS ●
● FOR USE BY EASY NETWORK ONLY ●

SHEET#:

T8

8 OF 29

EASY NETWORKS - 5231 IDF F., 10/17/2012 5:00:37 PM, 11 x 17

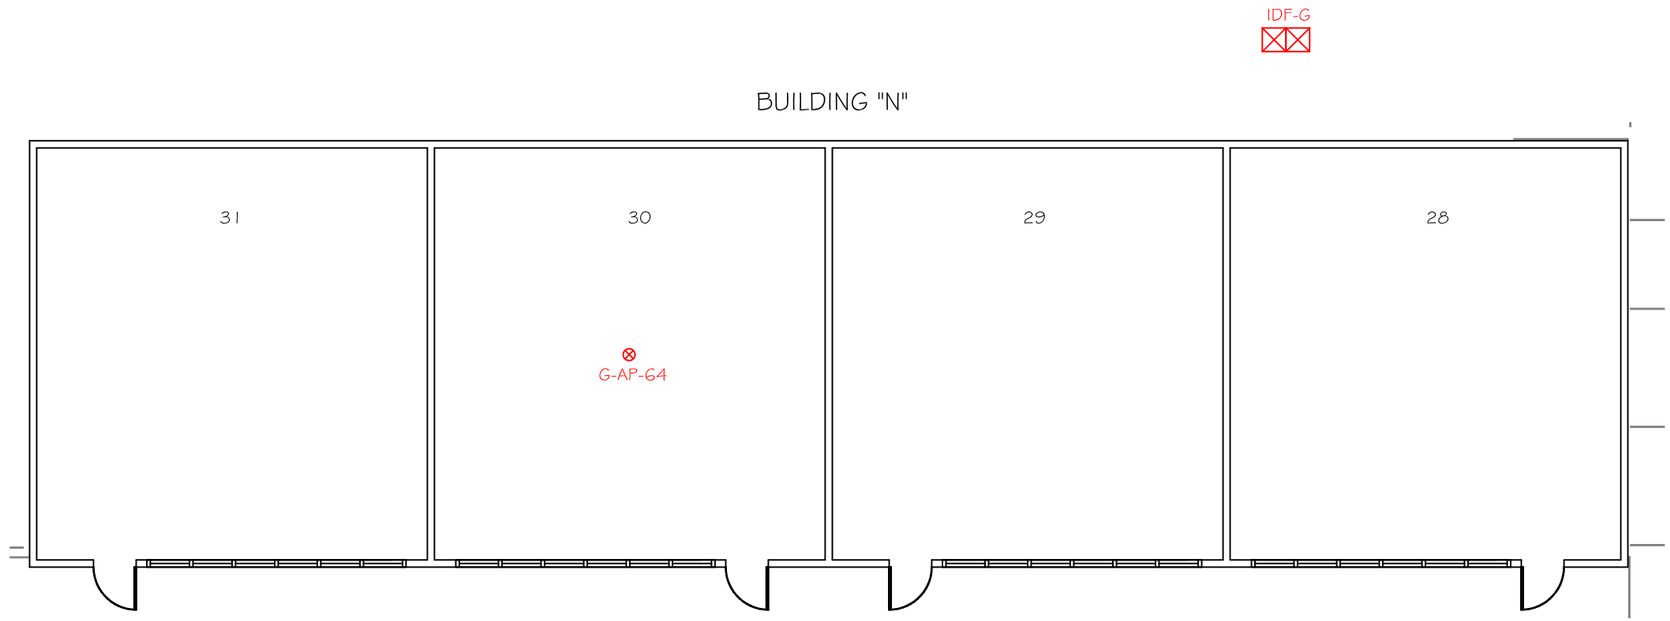


IDF-G - WIRELESS ACCESS POINT PLAN

SCALE: 1/16" = 1'-0"

LEGEND

⊗ WIRELESS ACCESS POINT

KEYMAP
NTS

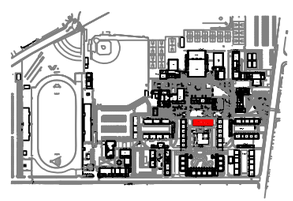

EASYNETWORKS CABLING
3538 SHELLEY WAY
RIVERSIDE, CA. 92503
OFFICE : 951. 742.8119
FAX : 951.742.8125
ST. LIC. # 936770

PREPARED FOR:

EL MONTE UNION HIGH SCHOOL DISTRICT

SITE:

ARROYO HIGH SCHOOL

4921 CEDAR AVENUE
EL MONTE, CA 91732

AS-BUILT
PROJECT NO. 5231

REVISIONS:

	DATE:	DESCRIPTION:

DRAWN BY:
GERARDO MORALES

DATE: 10/9/12
SCALE: AS SHOWN
SIZE: 11x17

TITLE:

IDF-G WIRELESS ACCESS POINT PLAN


● PROPERTY OF EASY NETWORKS ●
● FOR USE BY EASY NETWORK ONLY ●

SHEET#:

T9

9 OF 29

EASY NETWORKS - 5231 IDF G, 10/17/2012 5:00:27 PM, 11 x 17

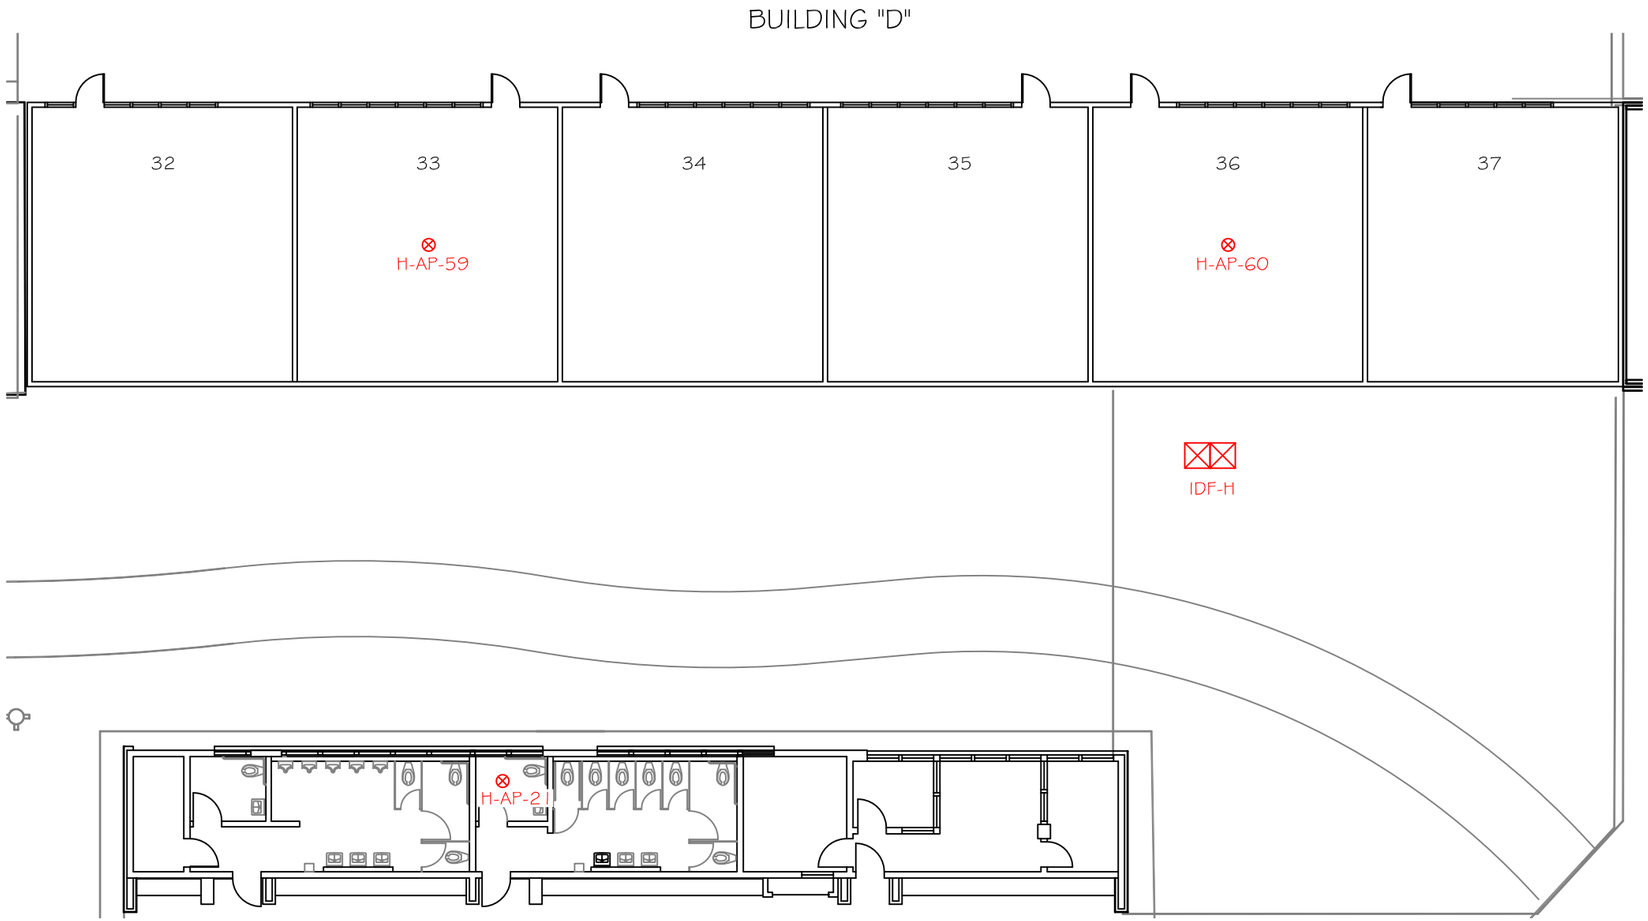


IDF-H - WIRELESS ACCESS POINT PLAN

SCALE: 1/16" = 1'-0"

LEGEND

⊗ WIRELESS ACCESS POINT

KEYMAP
NTS

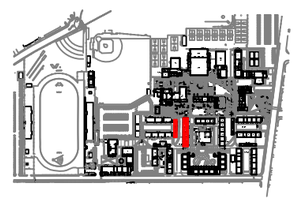

EASYNETWORKS CABLING
3538 SHELLEY WAY
RIVERSIDE, CA. 92503
OFFICE : 951. 742.8119
FAX : 951.742.8125
ST. LIC. # 936770

PREPARED FOR:

EL MONTE UNION HIGH SCHOOL DISTRICT

SITE:

ARROYO HIGH SCHOOL

4921 CEDAR AVENUE
EL MONTE, CA 91732

AS-BUILT
PROJECT NO. 5231

REVISIONS:

	DATE:	DESCRIPTION:

DRAWN BY: GERARDO MORALES

DATE: 10/9/12
SCALE: AS SHOWN
SIZE: 11x17

TITLE:

IDF-H WIRELESS ACCESS POINT PLAN


● PROPERTY OF EASY NETWORKS ●
● FOR USE BY EASY NETWORK ONLY ●

SHEET#:

T10

10 OF 29

EASY NETWORKS - 5231 IDF H, 10/17/2012 5:00:19 PM, 11 x 17

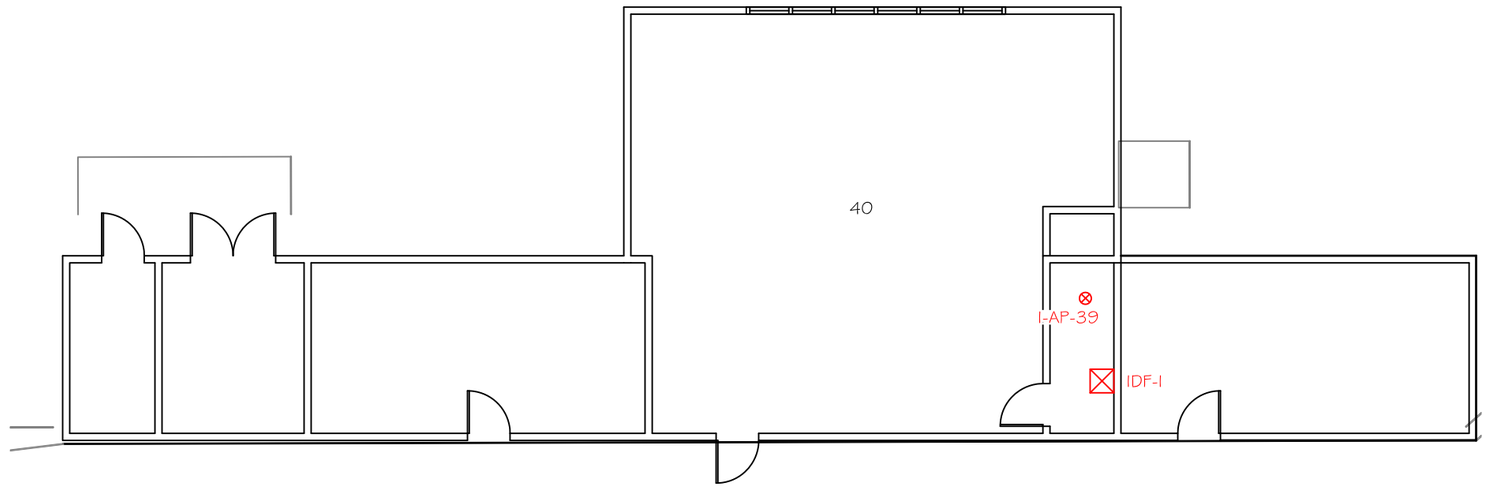


IDF- I - WIRELESS ACCESS POINT PLAN

SCALE: 3/32" = 1'-0"

LEGEND

⊗ WIRELESS ACCESS POINT

KEYMAP
NTS

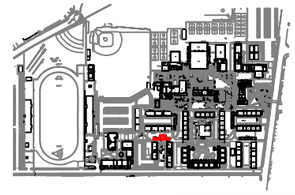

EASYNETWORKS CABLING
3538 SHELLEY WAY
RIVERSIDE, CA. 92503
OFFICE : 951. 742.8119
FAX : 951.742.8125
ST. LIC. # 936770

PREPARED FOR:

EL MONTE UNION HIGH SCHOOL DISTRICT

SITE:

ARROYO HIGH SCHOOL

4921 CEDAR AVENUE
EL MONTE, CA 91732

AS-BUILT
PROJECT NO. 5231

REVISIONS:

	DATE:	DESCRIPTION:
1		

DRAWN BY:
GERARDO MORALES

DATE: 10/9/12
SCALE: AS SHOWN
SIZE: 11x17

TITLE:

IDF-I WIRELESS ACCESS POINT PLAN


●PROPERTY OF EASY NETWORKS●
●FOR USE BY EASY NETWORK ONLY●

SHEET#:

T11

11 OF 29

EASY NETWORKS - 5231 IDF I, 10/17/2012 4:58:45 PM, 11 x 17

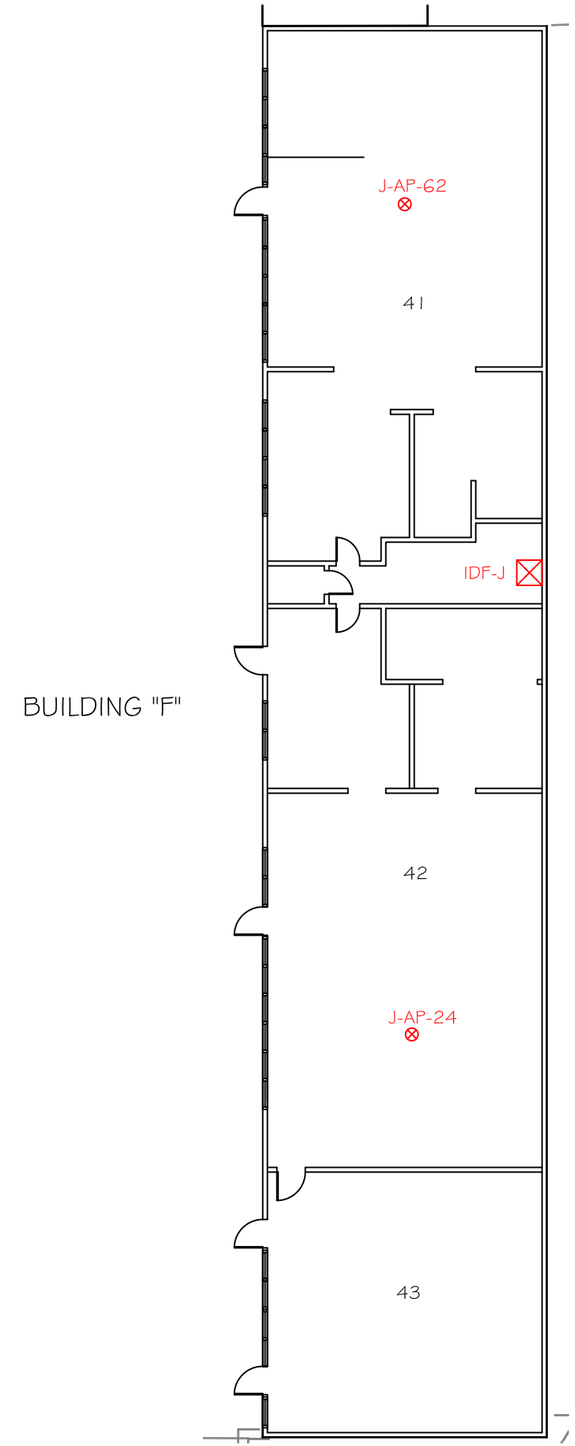


IDF-J - WIRELESS ACCESS POINT PLAN

SCALE: 1/16" = 1'-0"

LEGEND

⊗ WIRELESS ACCESS POINT

KEYMAP
NTS

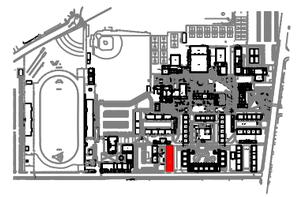

EASYNETWORKS CABLING
3538 SHELLEY WAY
RIVERSIDE, CA. 92503
OFFICE : 951.742.8119
FAX : 951.742.8125
ST. LIC. # 936770

PREPARED FOR:

EL MONTE UNION HIGH SCHOOL DISTRICT

SITE:

ARROYO HIGH SCHOOL

4921 CEDAR AVENUE
EL MONTE, CA 91732

AS-BUILT
PROJECT NO. 5231

REVISIONS:

	DATE:	DESCRIPTION:

DRAWN BY: GERARDO MORALES

DATE: 10/9/12
SCALE: AS SHOWN
SIZE: 11x17

TITLE:

IDF-J WIRELESS ACCESS POINT PLAN


• PROPERTY OF EASY NETWORKS •
• FOR USE BY EASY NETWORK ONLY •

SHEET#:

T12

12 OF 29

EASY NETWORKS - 5231 IDF J, 10/17/2012 4:58:37 PM, 11 x 17

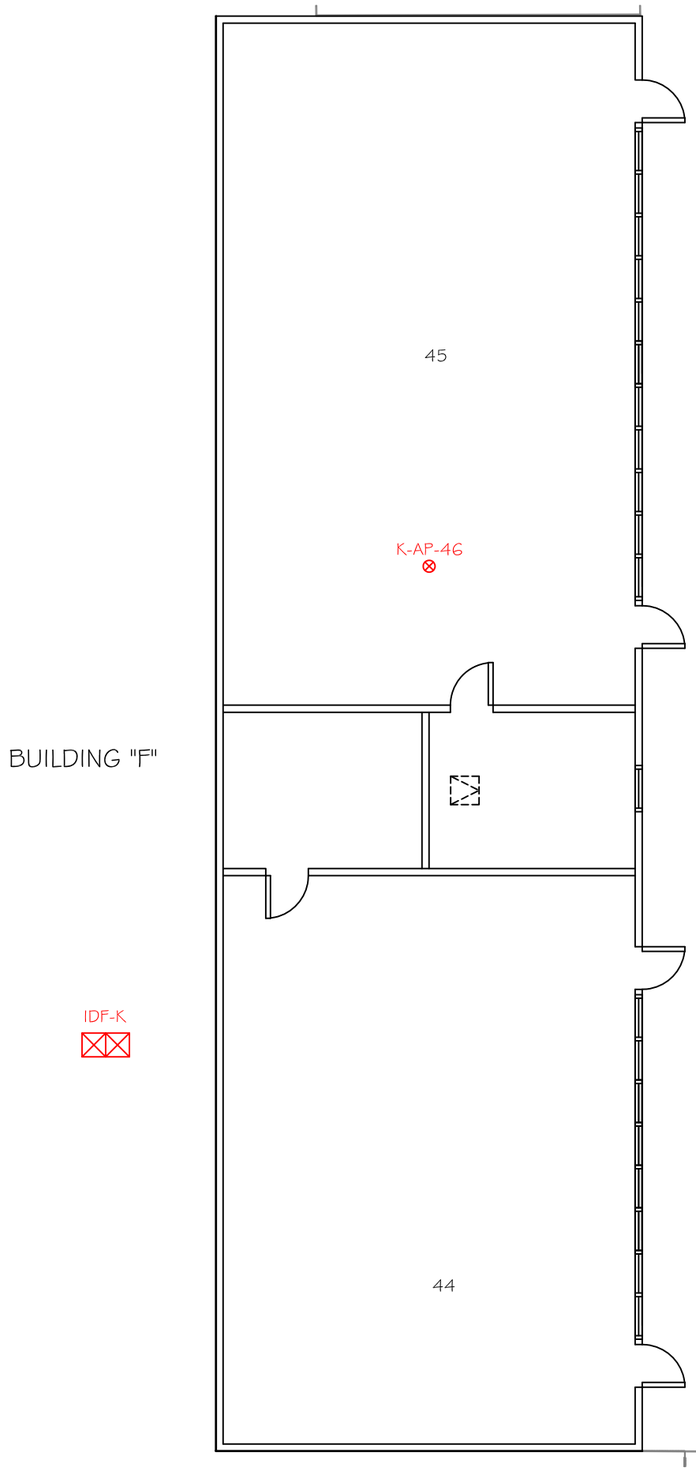

BUILDING "F"

IDF-K


IDF-K - WIRELESS ACCESS POINT PLAN

SCALE: 3/32" = 1'-0"

LEGEND

⊗ WIRELESS ACCESS POINT

KEYMAP
NTS

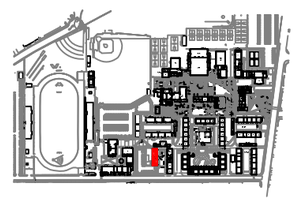

EASYNETWORKS CABLING
3538 SHELLEY WAY
RIVERSIDE, CA. 92503
OFFICE : 951. 742.8119
FAX : 951.742.8125
ST. LIC. # 936770

PREPARED FOR:

EL MONTE UNION HIGH SCHOOL DISTRICT

SITE:

ARROYO HIGH SCHOOL

4921 CEDAR AVENUE
EL MONTE, CA 91732

AS-BUILT
PROJECT NO. 5231

REVISIONS:

	DATE:	DESCRIPTION:

DRAWN BY: GERARDO MORALES

DATE: 10/9/12
SCALE: AS SHOWN
SIZE: 11x17

TITLE:

IDF-K WIRELESS ACCESS POINT PLAN


● PROPERTY OF EASY NETWORKS ●
● FOR USE BY EASY NETWORK ONLY ●

SHEET#:

T13

13 OF 29

EASY NETWORKS - 5231 IDF K, 10/17/2012 4:58:23 PM, 11 x 17

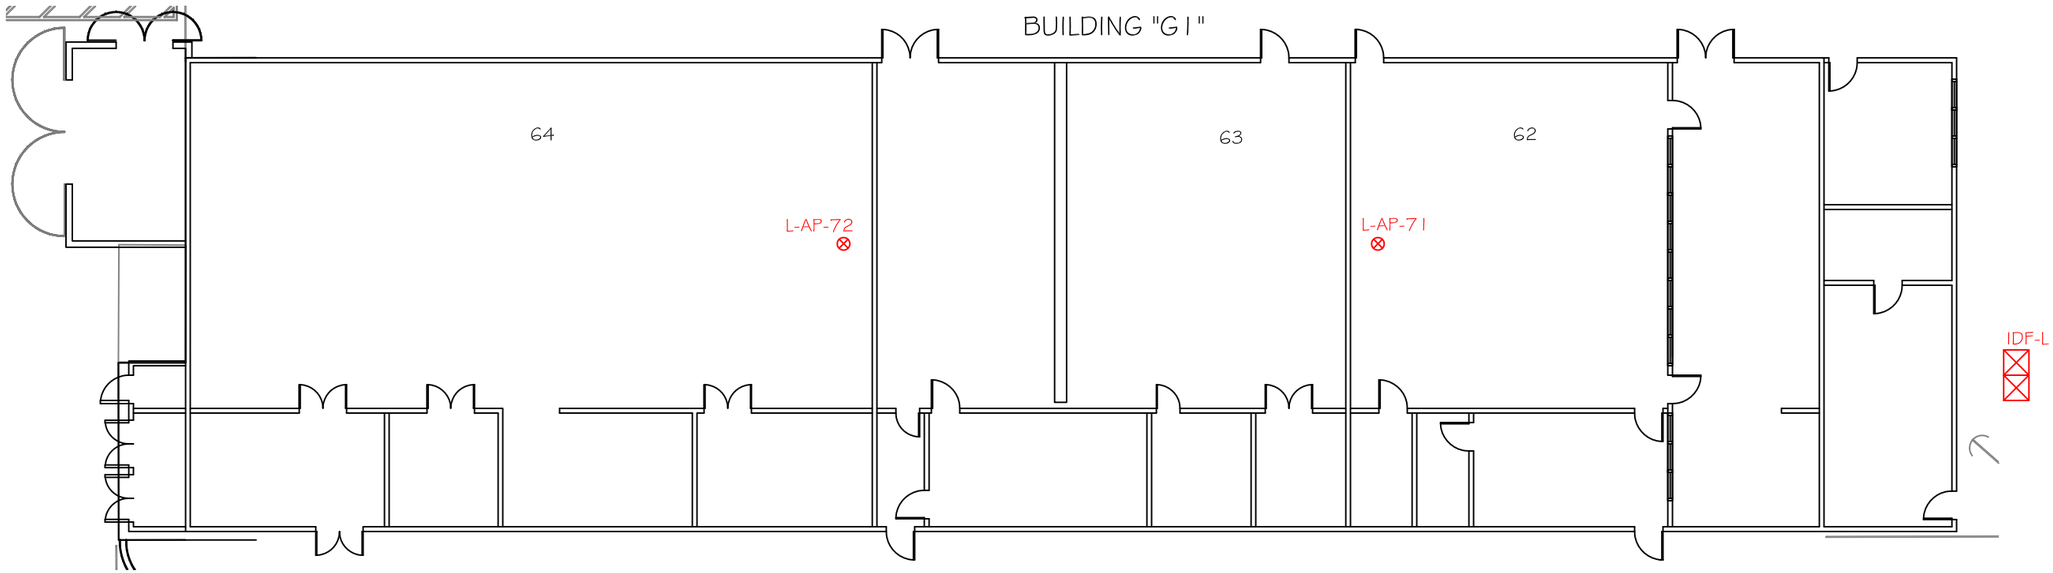


IDF- L - WIRELESS ACCESS POINT PLAN

SCALE: 1/16" = 1'-0"

LEGEND

⊗ WIRELESS ACCESS POINT

KEYMAP
NTS

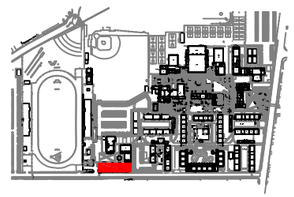

EASYNETWORKS CABLING
3538 SHELLEY WAY
RIVERSIDE, CA. 92503
OFFICE : 951. 742.8119
FAX : 951.742.8125
ST. LIC. # 936770

PREPARED FOR:

EL MONTE UNION HIGH SCHOOL DISTRICT

SITE:

ARROYO HIGH SCHOOL

4921 CEDAR AVENUE
EL MONTE, CA 91732

AS-BUILT
PROJECT NO. 5231

REVISIONS:

	DATE:	DESCRIPTION:

DRAWN BY: GERARDO MORALES

DATE: 10/9/12
SCALE: AS SHOWN
SIZE: 11x17

TITLE:

IDF-L WIRELESS ACCESS POINT PLAN


• PROPERTY OF EASY NETWORKS •
• FOR USE BY EASY NETWORK ONLY •

SHEET#:

T14

14 OF 29

EASY NETWORKS - 5231 IDF L, 10/17/2012 4:58:12 PM, 11 x 17

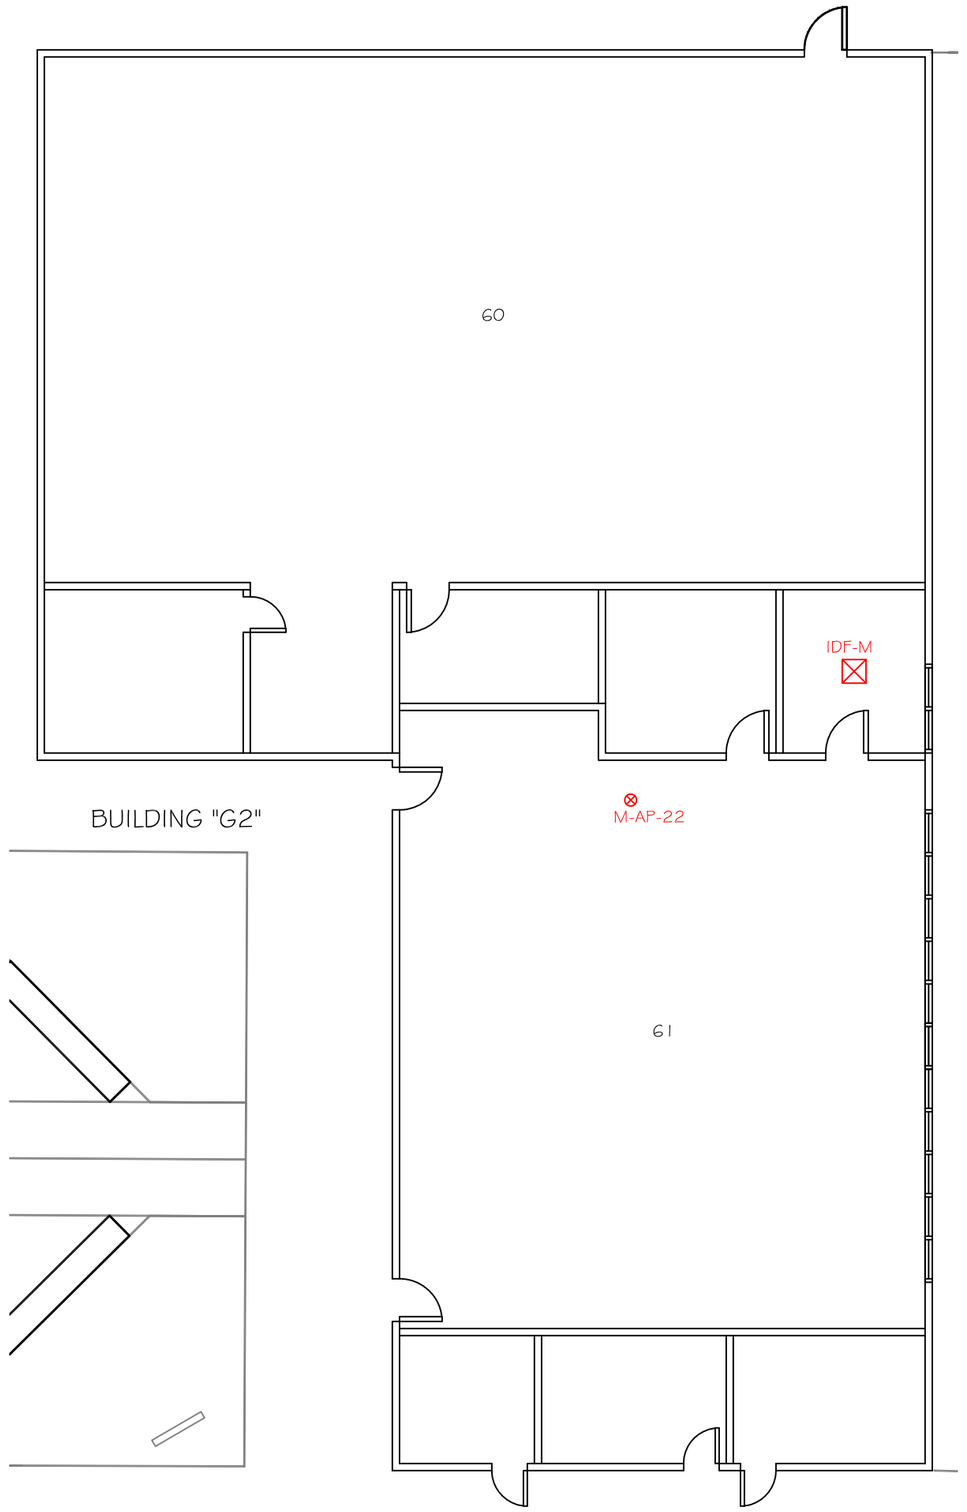


IDF-M - WIRELESS ACCESS POINT PLAN

SCALE: 3/32" = 1'-0"

LEGEND

⊗ WIRELESS ACCESS POINT

KEYMAP
NTS

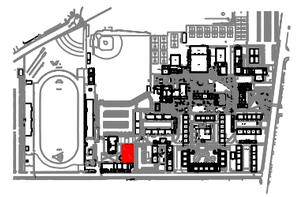

EASYNETWORKS CABLING

3538 SHELLEY WAY
RIVERSIDE, CA. 92503
OFFICE : 951. 742.8119
FAX : 951.742.8125
ST. LIC. # 936770

PREPARED FOR:

EL MONTE UNION HIGH SCHOOL DISTRICT

SITE:

ARROYO HIGH SCHOOL

4921 CEDAR AVENUE
EL MONTE, CA 91732

AS-BUILT
PROJECT NO. 5231

REVISIONS:

#	DATE:	DESCRIPTION:

DRAWN BY:
GERARDO MORALES

DATE: 10/9/12
SCALE: AS SHOWN
SIZE: 11x17

TITLE:

IDF-M WIRELESS ACCESS POINT PLAN


● PROPERTY OF EASY NETWORKS ●
● FOR USE BY EASY NETWORK ONLY ●

SHEET#:

T15

15 OF 29

EASY NETWORKS - 5231 IDF M, 10/17/2012 4:58:02 PM, 11 x 17

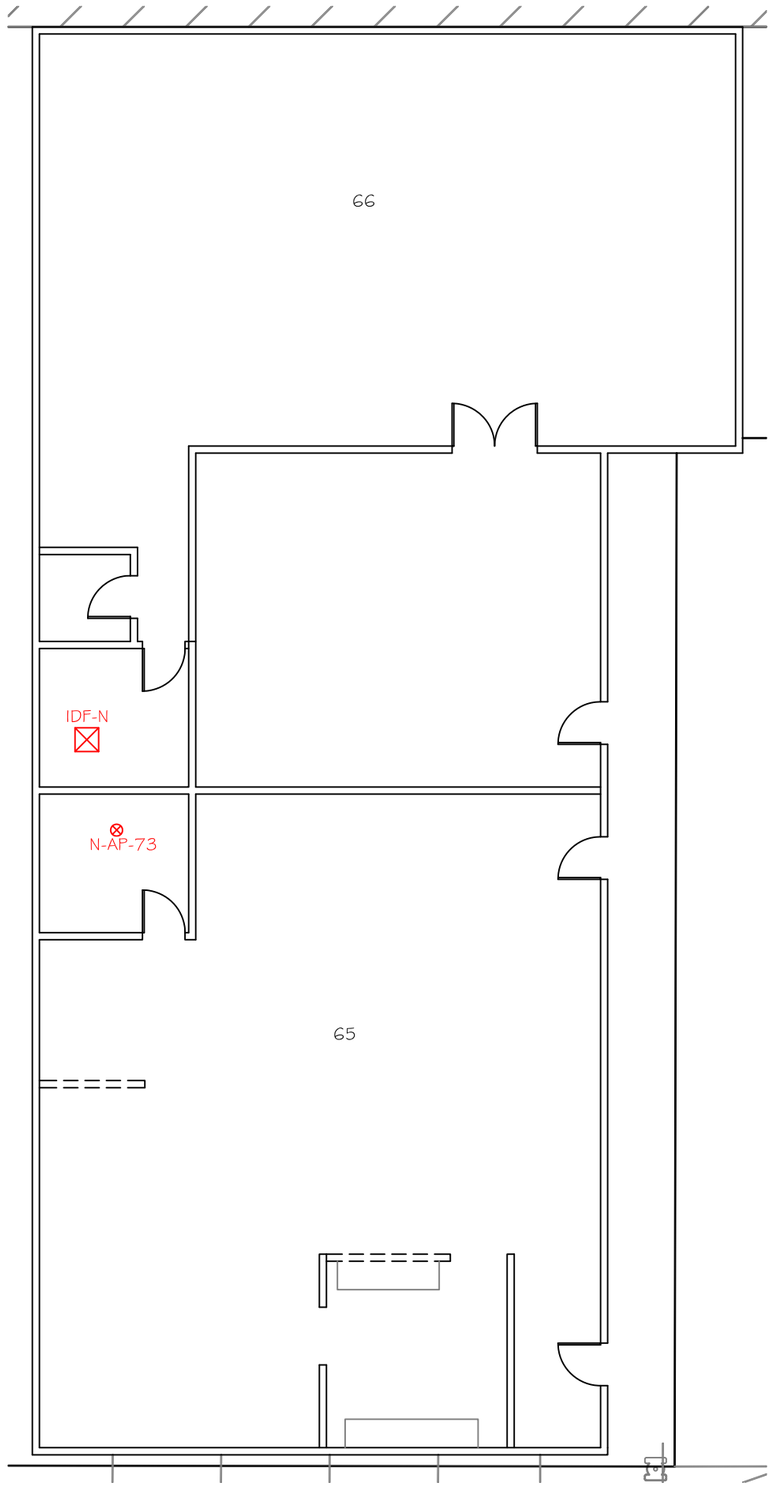


IDF-N - WIRELESS ACCESS POINT PLAN

SCALE: 3/32" = 1'-0"

LEGEND

⊗ WIRELESS ACCESS POINT

KEYMAP
NTS

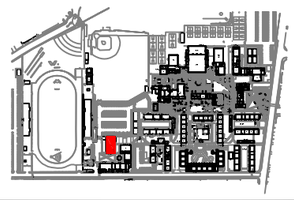

EASYNETWORKS CABLING
3538 SHELLEY WAY
RIVERSIDE, CA. 92503
OFFICE : 951. 742.8119
FAX : 951.742.8125
ST. LIC. # 936770

PREPARED FOR:

EL MONTE UNION HIGH SCHOOL DISTRICT

SITE:

ARROYO HIGH SCHOOL

4921 CEDAR AVENUE
EL MONTE, CA 91732

AS-BUILT
PROJECT NO. 5231

REVISIONS:

	DATE:	DESCRIPTION:

DRAWN BY: GERARDO MORALES

DATE: 10/9/12
SCALE: AS SHOWN
SIZE: 11x17

TITLE:

IDF-N WIRELESS ACCESS POINT PLAN


• PROPERTY OF EASY NETWORKS •
• FOR USE BY EASY NETWORK ONLY •

SHEET#:

T16

16 OF 29

EASY NETWORKS - 5231 IDF N, 10/17/2012 4:57:52 PM, 11 x 17

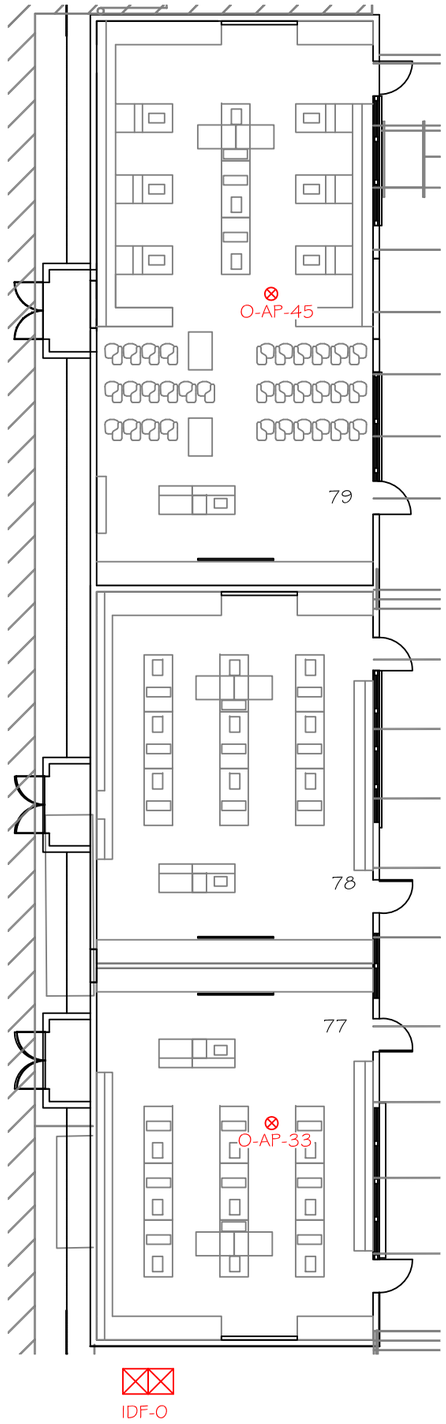


IDF- O - WIRELESS ACCESS POINT PLAN

SCALE: 1/16" = 1'-0"

LEGEND

⊗ WIRELESS ACCESS POINT

KEYMAP
NTS

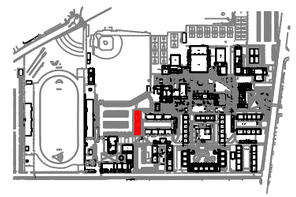

EASYNETWORKS CABLING
3538 SHELLEY WAY
RIVERSIDE, CA. 92503
OFFICE : 951. 742.8119
FAX : 951.742.8125
ST. LIC. # 936770

PREPARED FOR:

EL MONTE UNION HIGH SCHOOL DISTRICT

SITE:

ARROYO HIGH SCHOOL

4921 CEDAR AVENUE
EL MONTE, CA 91732

AS-BUILT
PROJECT NO. 5231

REVISIONS:

	DATE:	DESCRIPTION:

DRAWN BY:
GERARDO MORALES

DATE: 10/9/12
SCALE: AS SHOWN
SIZE: 11x17

TITLE:

IDF-O WIRELESS ACCESS POINT PLAN


• PROPERTY OF EASY NETWORKS •
• FOR USE BY EASY NETWORK ONLY •

SHEET#:

T17

17 OF 29

EASY NETWORKS - 5231 IDF O, 10/17/2012 4:57:45 PM, 11 x 17

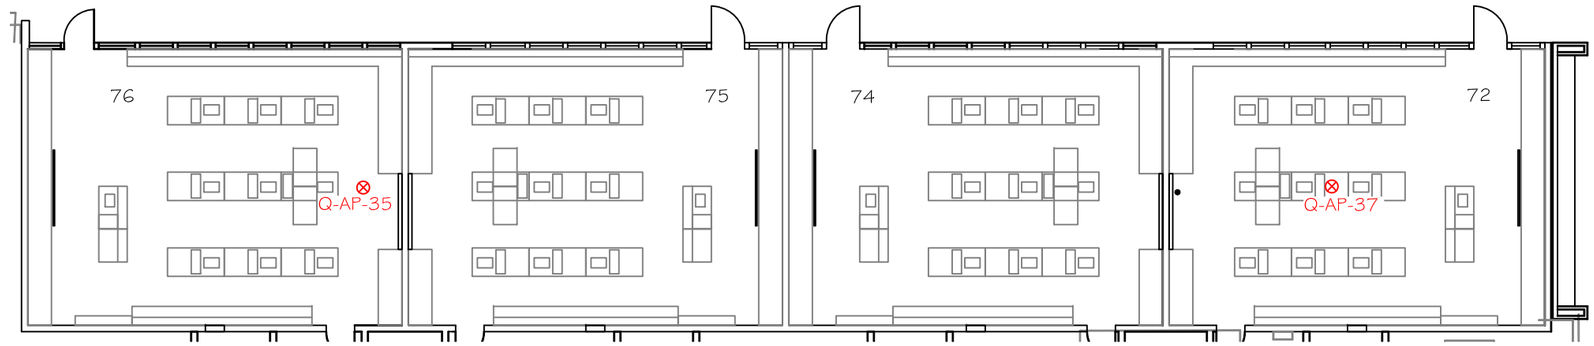

IDF-Q


IDF- Q - WIRELESS ACCESS POINT PLAN

SCALE: 1/16" = 1'-0"

LEGEND

⊗ WIRELESS ACCESS POINT

KEYMAP
NTS

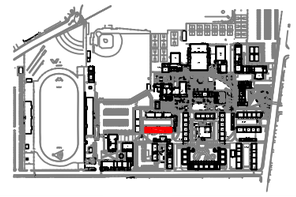

EASYNETWORKS CABLING
3538 SHELLEY WAY
RIVERSIDE, CA. 92503
OFFICE : 951. 742.8119
FAX : 951.742.8125
ST. LIC. # 936770

PREPARED FOR:

EL MONTE UNION HIGH SCHOOL DISTRICT

SITE:

ARROYO HIGH SCHOOL

4921 CEDAR AVENUE
EL MONTE, CA 91732

AS-BUILT
PROJECT NO. 5231

REVISIONS:

	DATE:	DESCRIPTION:
1		

DRAWN BY:
GERARDO MORALES

DATE: 10/9/12
SCALE: AS SHOWN
SIZE: 11x17

TITLE:

IDF-Q WIRELESS ACCESS POINT PLAN


● PROPERTY OF EASY NETWORKS ●
● FOR USE BY EASY NETWORK ONLY ●

SHEET#:

T18

18 OF 29

EASY NETWORKS - 5231 IDF Q, 10/17/2012 4:57:38 PM, 11 x 17

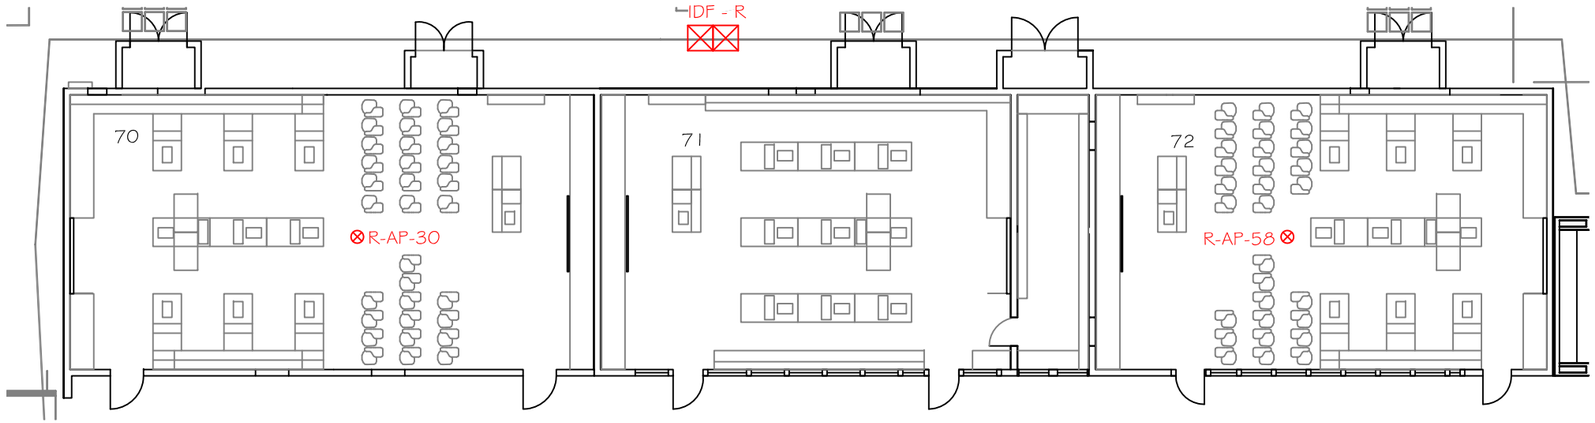


IDF- R - WIRELESS ACCESS POINT PLAN

SCALE: 1/16" = 1'-0"

LEGEND

⊗ WIRELESS ACCESS POINT

KEYMAP
NTS

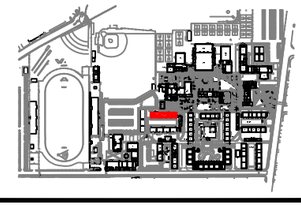

EASYNETWORKS CABLING
3538 SHELLEY WAY
RIVERSIDE, CA. 92503
OFFICE : 951. 742.8119
FAX : 951.742.8125
ST. LIC. # 936770

PREPARED FOR:

EL MONTE UNION HIGH SCHOOL DISTRICT

SITE:

ARROYO HIGH SCHOOL

4921 CEDAR AVENUE
EL MONTE, CA 91732

AS-BUILT
PROJECT NO. 5231

REVISIONS:

	DATE:	DESCRIPTION:

DRAWN BY:
GERARDO MORALES

DATE: 10/9/12
SCALE: AS SHOWN
SIZE: 11x17

TITLE:

IDF-R WIRELESS ACCESS POINT PLAN


● PROPERTY OF EASY NETWORKS ●
● FOR USE BY EASY NETWORK ONLY ●

SHEET#:

T19

19 OF 29

EASY NETWORKS - 5231 IDF R, 10/17/2012 4:57:31 PM, 11 x 17

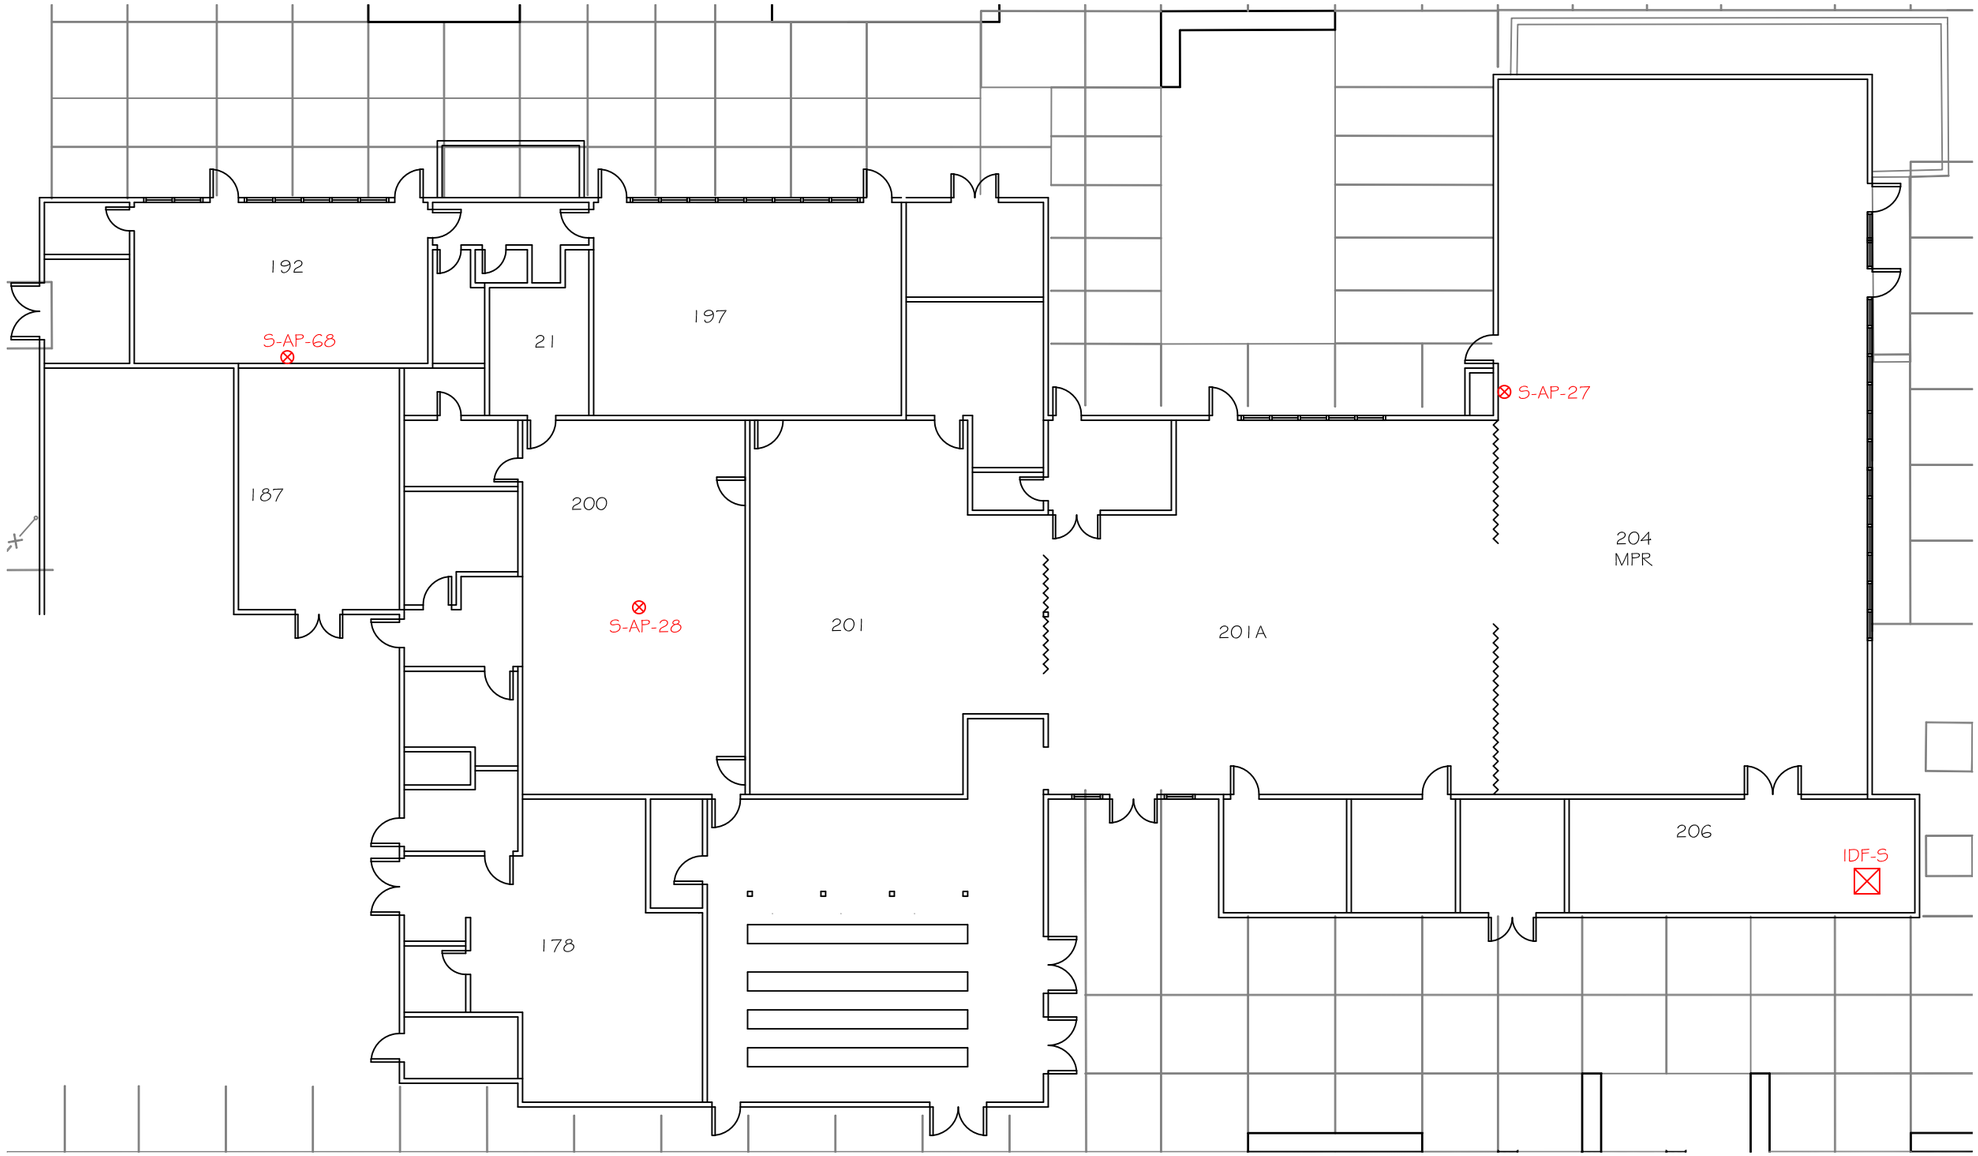


IDF- S - WIRELESS ACCESS POINT PLAN

SCALE: 1/16" = 1'-0"

LEGEND

⊗ WIRELESS ACCESS POINT

KEYMAP
NTS

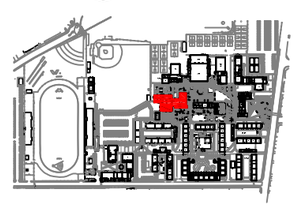

EASYNETWORKS CABLING
3538 SHELLEY WAY
RIVERSIDE, CA. 92503
OFFICE : 951.742.8119
FAX : 951.742.8125
ST. LIC. # 936770

PREPARED FOR:

EL MONTE UNION HIGH SCHOOL DISTRICT

SITE:

ARROYO HIGH SCHOOL

4921 CEDAR AVENUE
EL MONTE, CA 91732

AS-BUILT
PROJECT NO. 5231

REVISIONS:

#	DATE:	DESCRIPTION:

DRAWN BY:
GERARDO MORALES

DATE: 10/9/12
SCALE: AS SHOWN
SIZE: 11x17

TITLE:

IDF-S WIRELESS ACCESS POINT PLAN


• PROPERTY OF EASY NETWORKS •
• FOR USE BY EASY NETWORK ONLY •

SHEET#:

T20

20 OF 29

EASY NETWORKS - 5231 IDF S, 10/17/2012 4:57:23 PM, 11 x 17

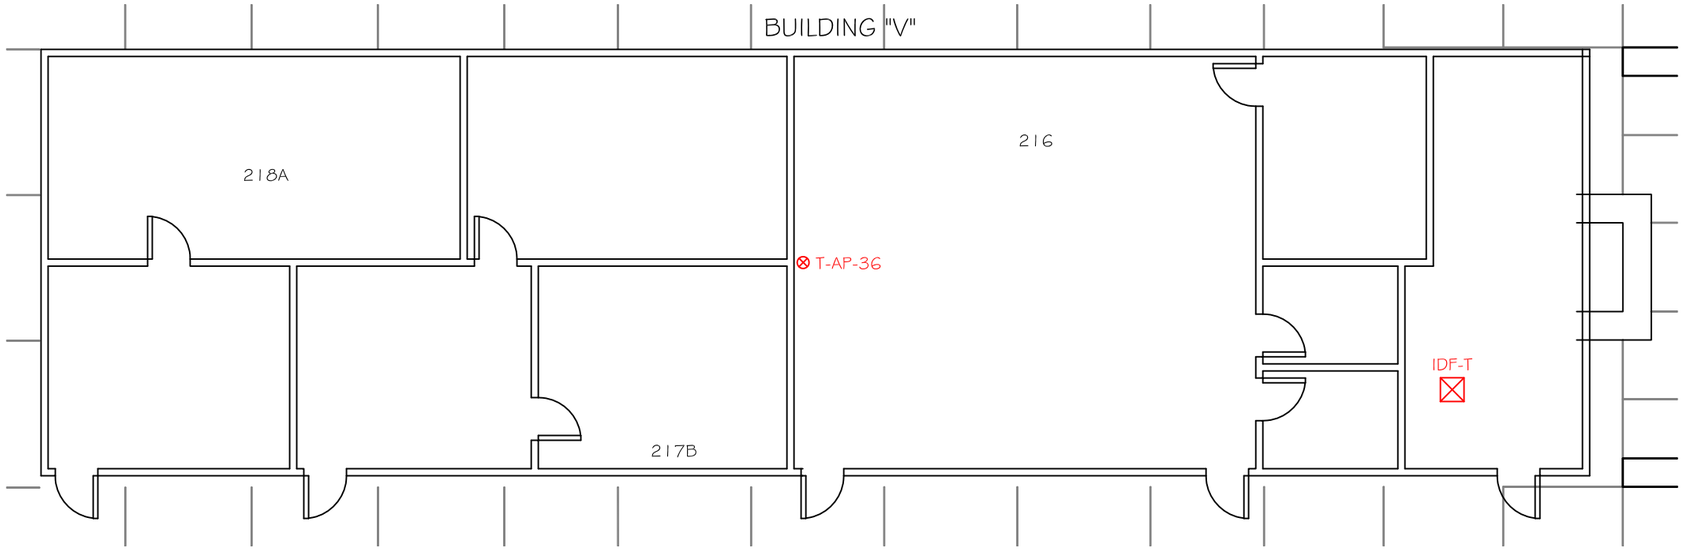


IDF- T - WIRELESS ACCESS POINT PLAN

SCALE: 3/32" = 1'-0"

LEGEND

⊗ WIRELESS ACCESS POINT

KEYMAP
NTS

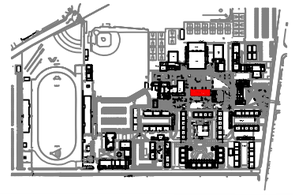

EASYNETWORKS CABLING
3538 SHELLEY WAY
RIVERSIDE, CA. 92503
OFFICE : 951. 742.8119
FAX : 951.742.8125
ST. LIC. # 936770

PREPARED FOR:

EL MONTE UNION HIGH SCHOOL DISTRICT

SITE:

ARROYO HIGH SCHOOL

4921 CEDAR AVENUE
EL MONTE, CA 91732

AS-BUILT
PROJECT NO. 5231

REVISIONS:

	DATE:	DESCRIPTION:
1		

DRAWN BY:
GERARDO MORALES

DATE: 10/9/12
SCALE: AS SHOWN
SIZE: 11x17

TITLE:

IDF-T WIRELESS ACCESS POINT PLAN


●PROPERTY OF EASY NETWORKS●
●FOR USE BY EASY NETWORK ONLY●

SHEET#:

T21

21 OF 29

EASY NETWORKS - 5231 IDF T.. 10/17/2012 4:57:11 PM. 11 x 17

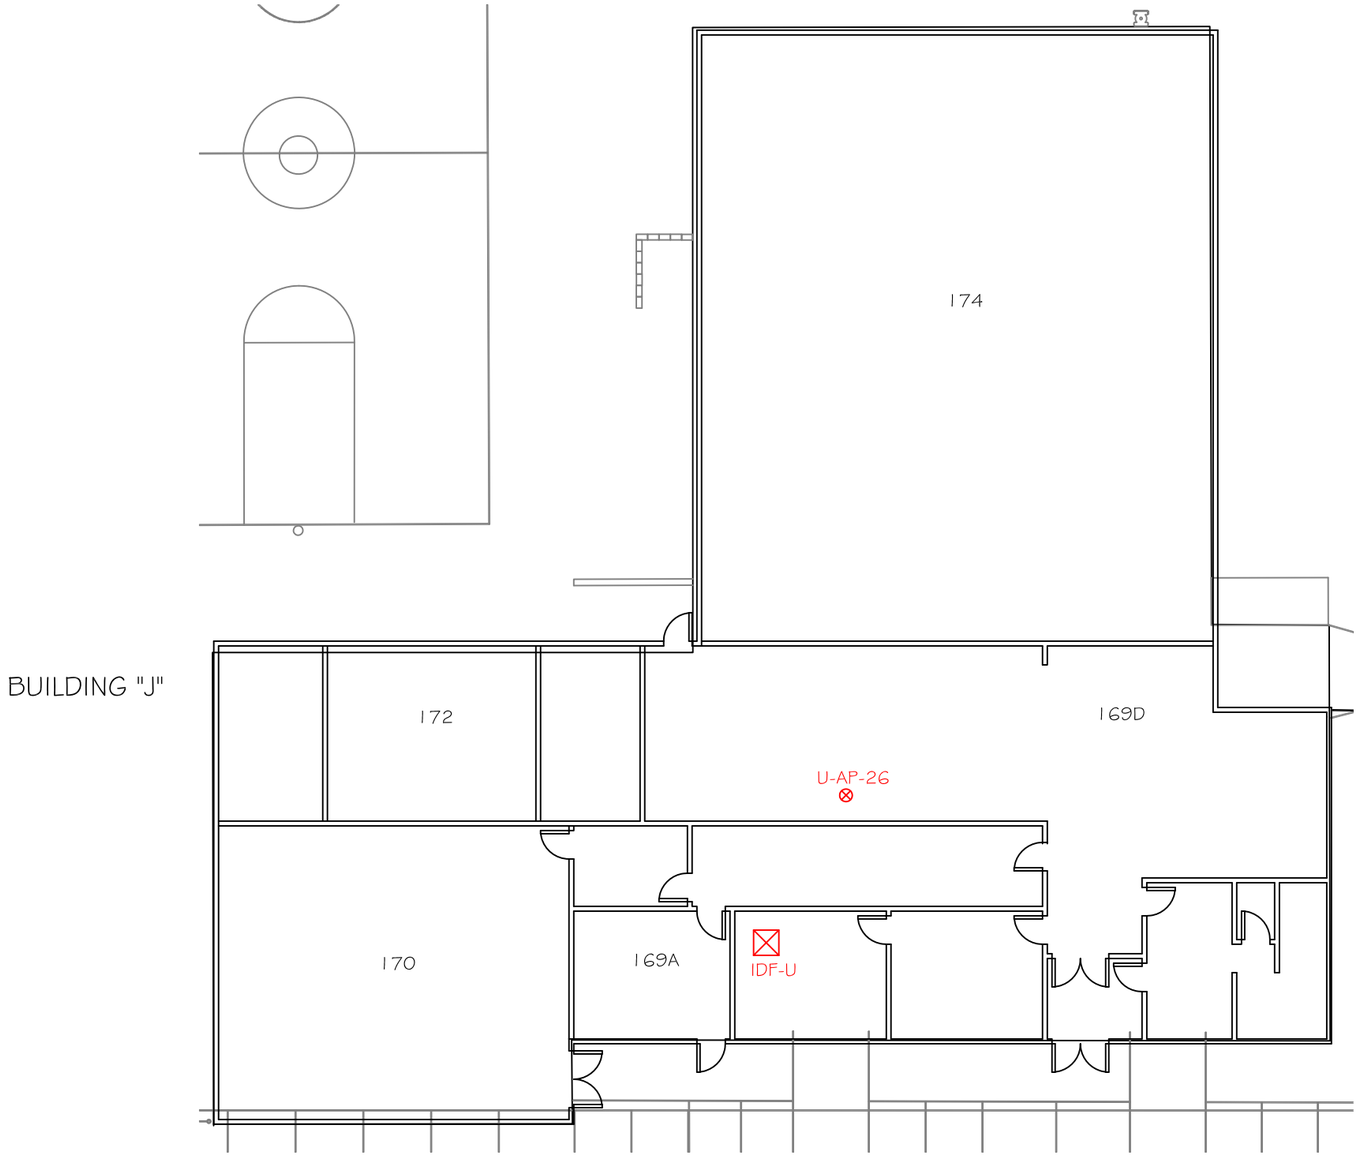


IDF- U - WIRELESS ACCESS POINT PLAN

SCALE: 1/16" = 1'-0"

LEGEND

⊗ WIRELESS ACCESS POINT

KEYMAP
NTS

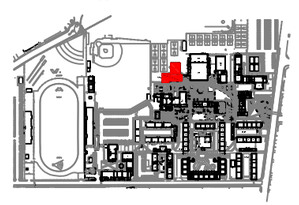

EASYNETWORKS CABLING
3538 SHELLEY WAY
RIVERSIDE, CA. 92503
OFFICE : 951. 742.8119
FAX : 951.742.8125
ST. LIC. # 936770

PREPARED FOR:

EL MONTE UNION HIGH SCHOOL DISTRICT

SITE:

ARROYO HIGH SCHOOL

4921 CEDAR AVENUE
EL MONTE, CA 91732

AS-BUILT
PROJECT NO. 5231

REVISIONS:

	DATE:	DESCRIPTION:

DRAWN BY:
GERARDO MORALES

DATE: 10/9/12
SCALE: AS SHOWN
SIZE: 11x17

TITLE:

IDF-U WIRELESS ACCESS POINT PLAN


• PROPERTY OF EASY NETWORKS •
• FOR USE BY EASY NETWORK ONLY •

SHEET#:

T22

22 OF 29


EASY NETWORKS - 5231 IDF U, 10/17/2012 4:56:54 PM, 11 x 17

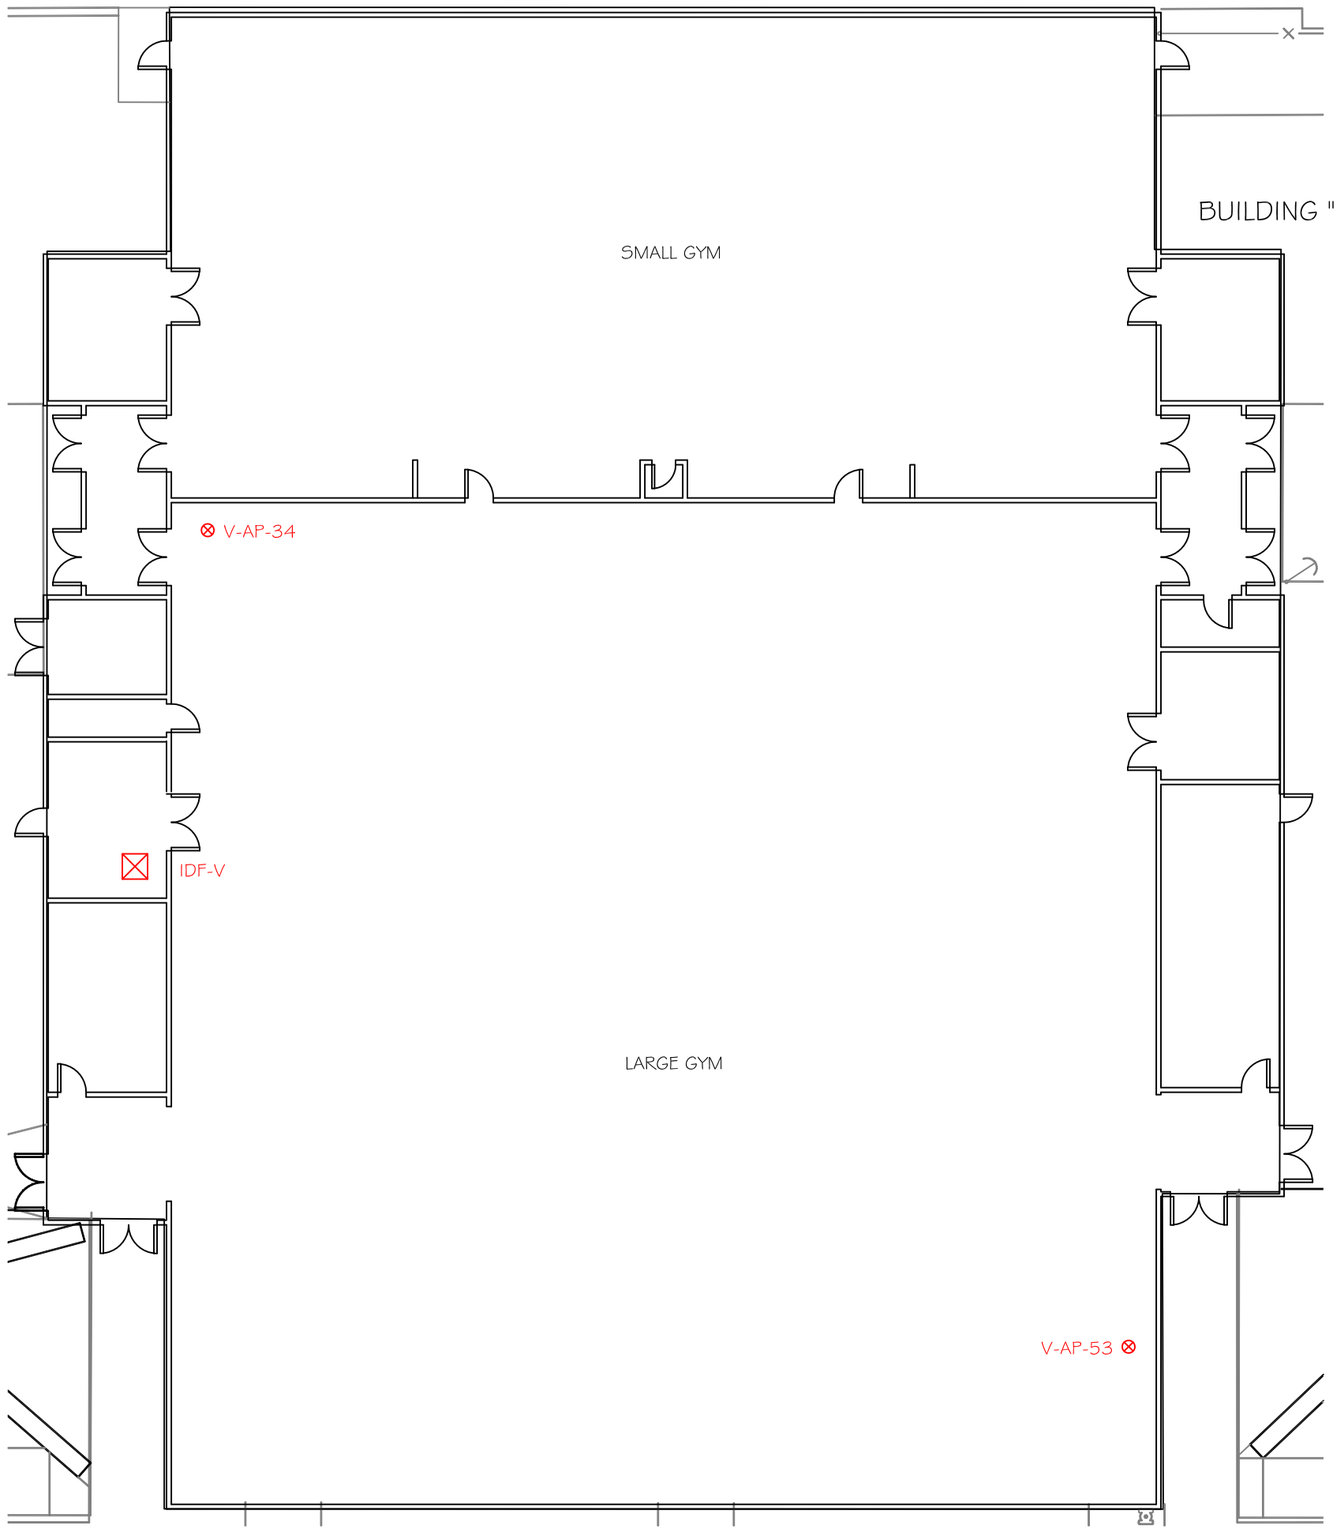

IDF- V - WIRELESS ACCESS POINT PLAN
SCALE: 1/16" = 1'-0"

LEGEND
⊗ WIRELESS ACCESS POINT

KEYMAP
NTS

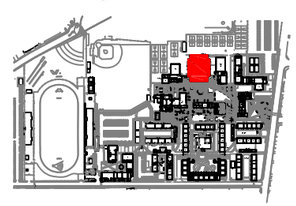

EASYNETWORKS CABLING
3538 SHELLEY WAY
RIVERSIDE, CA. 92503
OFFICE : 951. 742.8119
FAX : 951.742.8125
ST. LIC. # 936770

PREPARED FOR:
EL MONTE UNION HIGH SCHOOL DISTRICT

SITE:
ARROYO HIGH SCHOOL

4921 CEDAR AVENUE
EL MONTE, CA 91732

AS-BUILT
PROJECT NO. 5231

REVISIONS:

	DATE:	DESCRIPTION:

DRAWN BY:
GERARDO MORALES


DATE: 10/9/12
SCALE: AS SHOWN
SIZE: 11x17

TITLE:
IDF-V WIRELESS ACCESS POINT PLAN

• PROPERTY OF EASY NETWORKS •
• FOR USE BY EASY NETWORK ONLY •

SHEET#:
T23
23 OF 29

EASY NETWORKS - 5231 IDF V, 10/17/2012 4:56:46 PM, 11 x 17

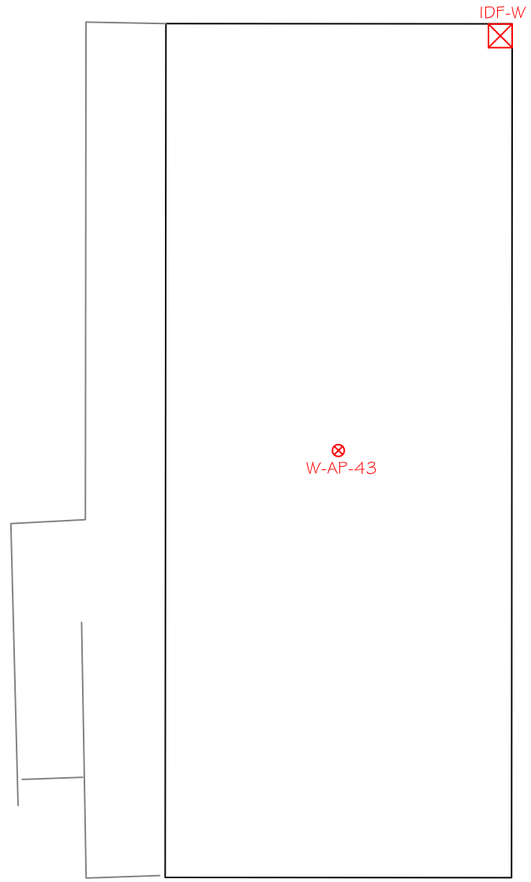


IDF-W - WIRELESS ACCESS POINT PLAN

SCALE: 3/32" = 1'-0"

LEGEND

⊗ WIRELESS ACCESS POINT

KEYMAP
NTS

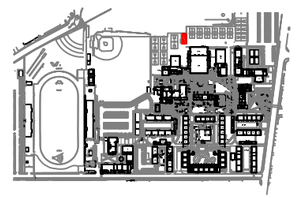

EASYNETWORKS CABLING
3538 SHELLEY WAY
RIVERSIDE, CA. 92503
OFFICE : 951. 742.8119
FAX : 951.742.8125
ST. LIC. # 936770

PREPARED FOR:

EL MONTE UNION HIGH SCHOOL DISTRICT

SITE:

ARROYO HIGH SCHOOL

4921 CEDAR AVENUE
EL MONTE, CA 91732

AS-BUILT
PROJECT NO. 5231

REVISIONS:

	DATE:	DESCRIPTION:

DRAWN BY:
GERARDO MORALES

DATE: 10/9/12
SCALE: AS SHOWN
SIZE: 11x17

TITLE:

IDF-W WIRELESS ACCESS POINT PLAN


● PROPERTY OF EASY NETWORKS ●
● FOR USE BY EASY NETWORK ONLY ●

SHEET#:

T24

24 OF 29

EASY NETWORKS - 5231 IDF W, 10/17/2012 4:56:34 PM, 11 x 17

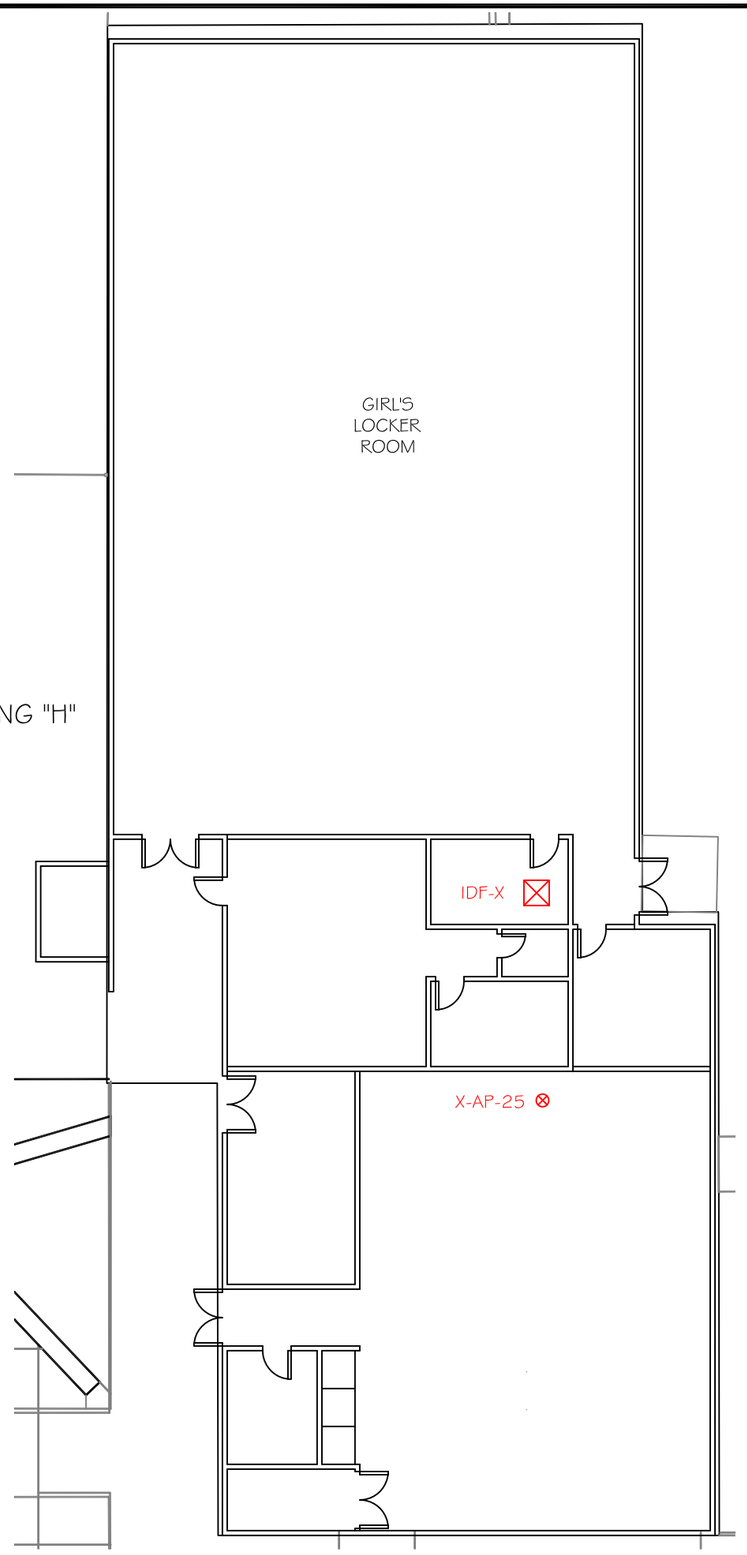


IDF- X - WIRELESS ACCESS POINT PLAN

SCALE: 1/16" = 1'-0"

LEGEND

⊗ WIRELESS ACCESS POINT

KEYMAP
NTS

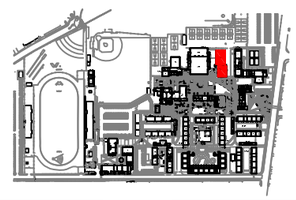

EASYNETWORKS CABLING
3538 SHELLEY WAY
RIVERSIDE, CA. 92503
OFFICE : 951. 742.8119
FAX : 951.742.8125
ST. LIC. # 936770

PREPARED FOR:

EL MONTE UNION HIGH SCHOOL DISTRICT

SITE:

ARROYO HIGH SCHOOL

4921 CEDAR AVENUE
EL MONTE, CA 91732

AS-BUILT
PROJECT NO. 5231

REVISIONS:

#	DATE:	DESCRIPTION:

DRAWN BY: GERARDO MORALES

DATE: 10/9/12
SCALE: AS SHOWN
SIZE: 11x17

TITLE:

IDF-X WIRELESS ACCESS POINT PLAN


• PROPERTY OF EASY NETWORKS •
• FOR USE BY EASY NETWORK ONLY •

SHEET#:

T25

25 OF 29

EASY NETWORKS - 5231 IDF X, 10/17/2012 4:56:26 PM, 11 x 17

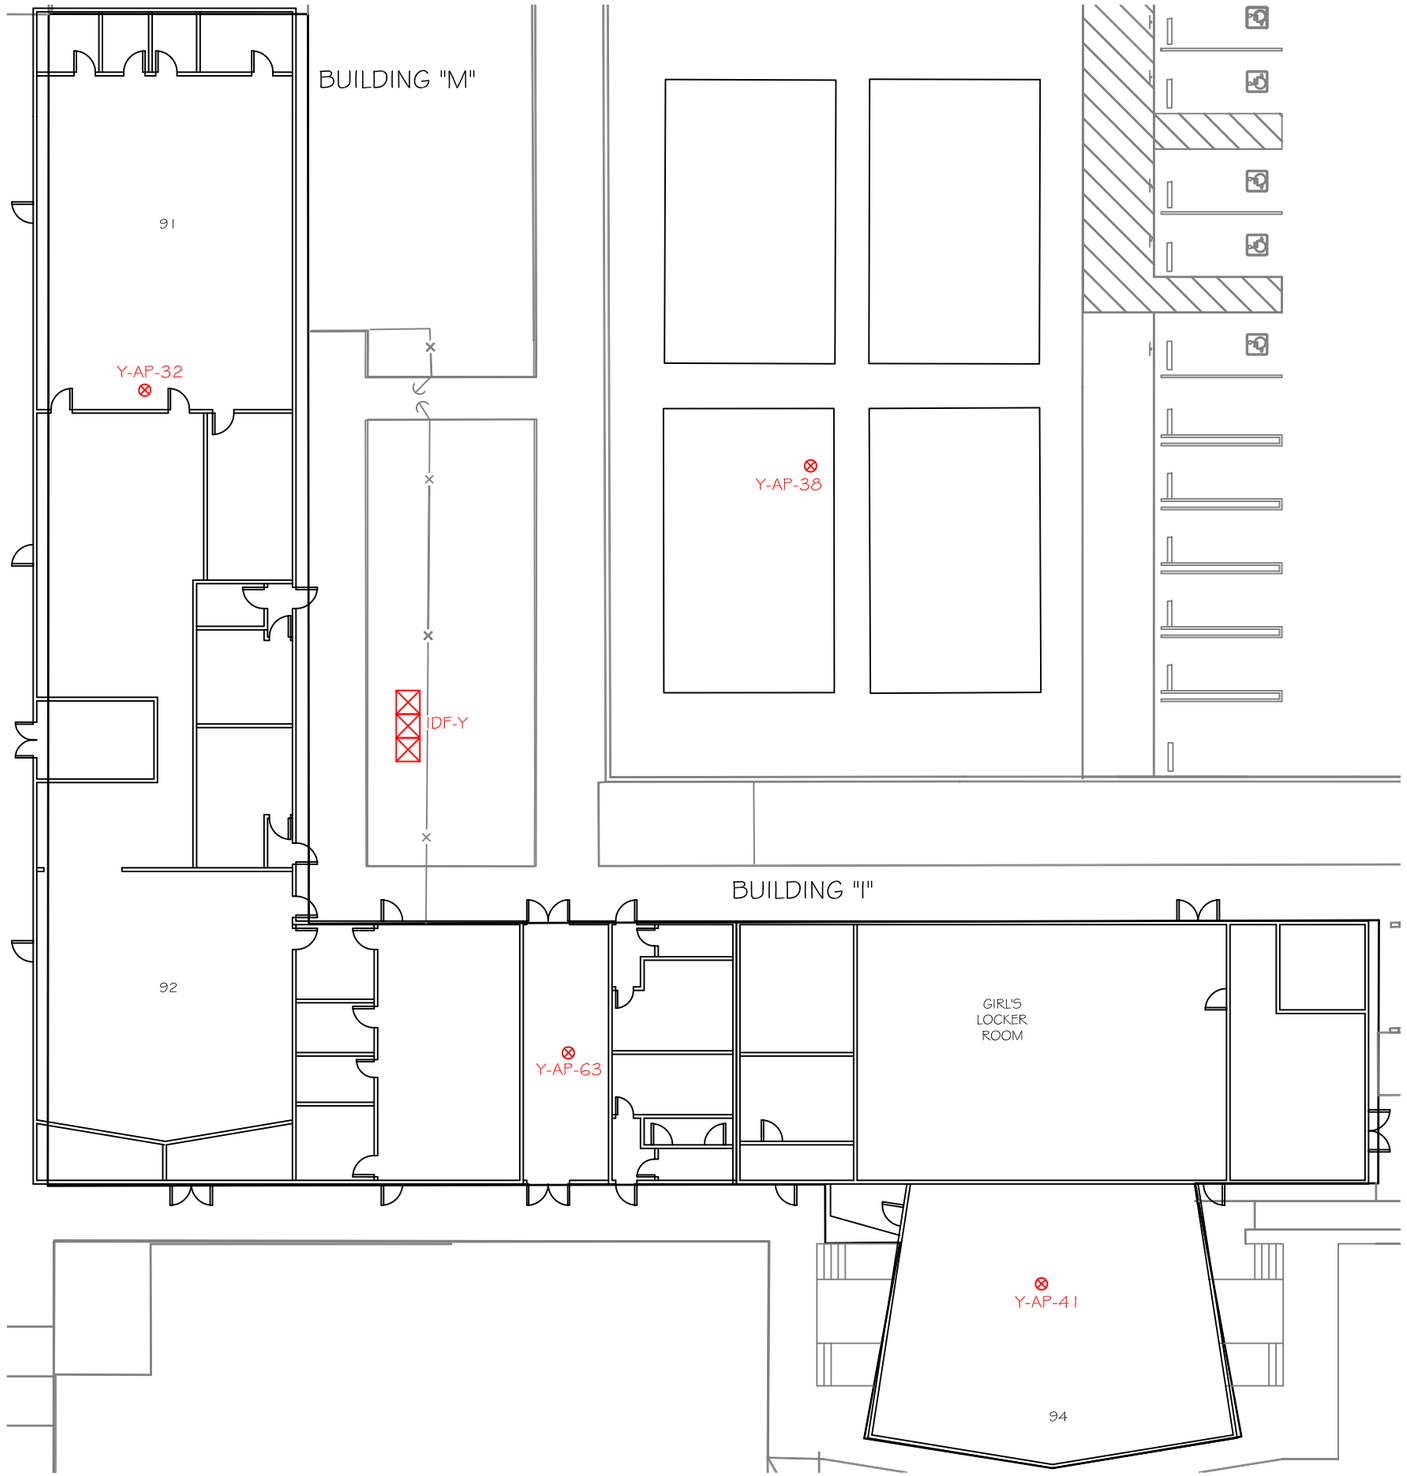


IDF- Y - WIRELESS ACCESS POINT PLAN

SCALE: 3/64" = 1'-0"

LEGEND

⊗ WIRELESS ACCESS POINT

KEYMAP
NTS

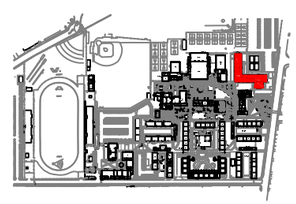

EASYNETWORKS CABLING
3538 SHELLEY WAY
RIVERSIDE, CA. 92503
OFFICE : 951. 742.8119
FAX : 951.742.8125
ST. LIC. # 936770

PREPARED FOR:

EL MONTE UNION HIGH SCHOOL DISTRICT

SITE:

ARROYO HIGH SCHOOL

4921 CEDAR AVENUE
EL MONTE, CA 91732

AS-BUILT
PROJECT NO. 5231

REVISIONS:

	DATE:	DESCRIPTION:

DRAWN BY:
GERARDO MORALES

DATE: 10/9/12
SCALE: AS SHOWN
SIZE: 11x17

TITLE:

IDF-Y WIRELESS ACCESS POINT PLAN


● PROPERTY OF EASY NETWORKS ●
● FOR USE BY EASY NETWORK ONLY ●

SHEET#:

T26

26 OF 29

EASY NETWORKS - 5231 IDF Y, 10/17/2012 4:56:20 PM, 11 x 17

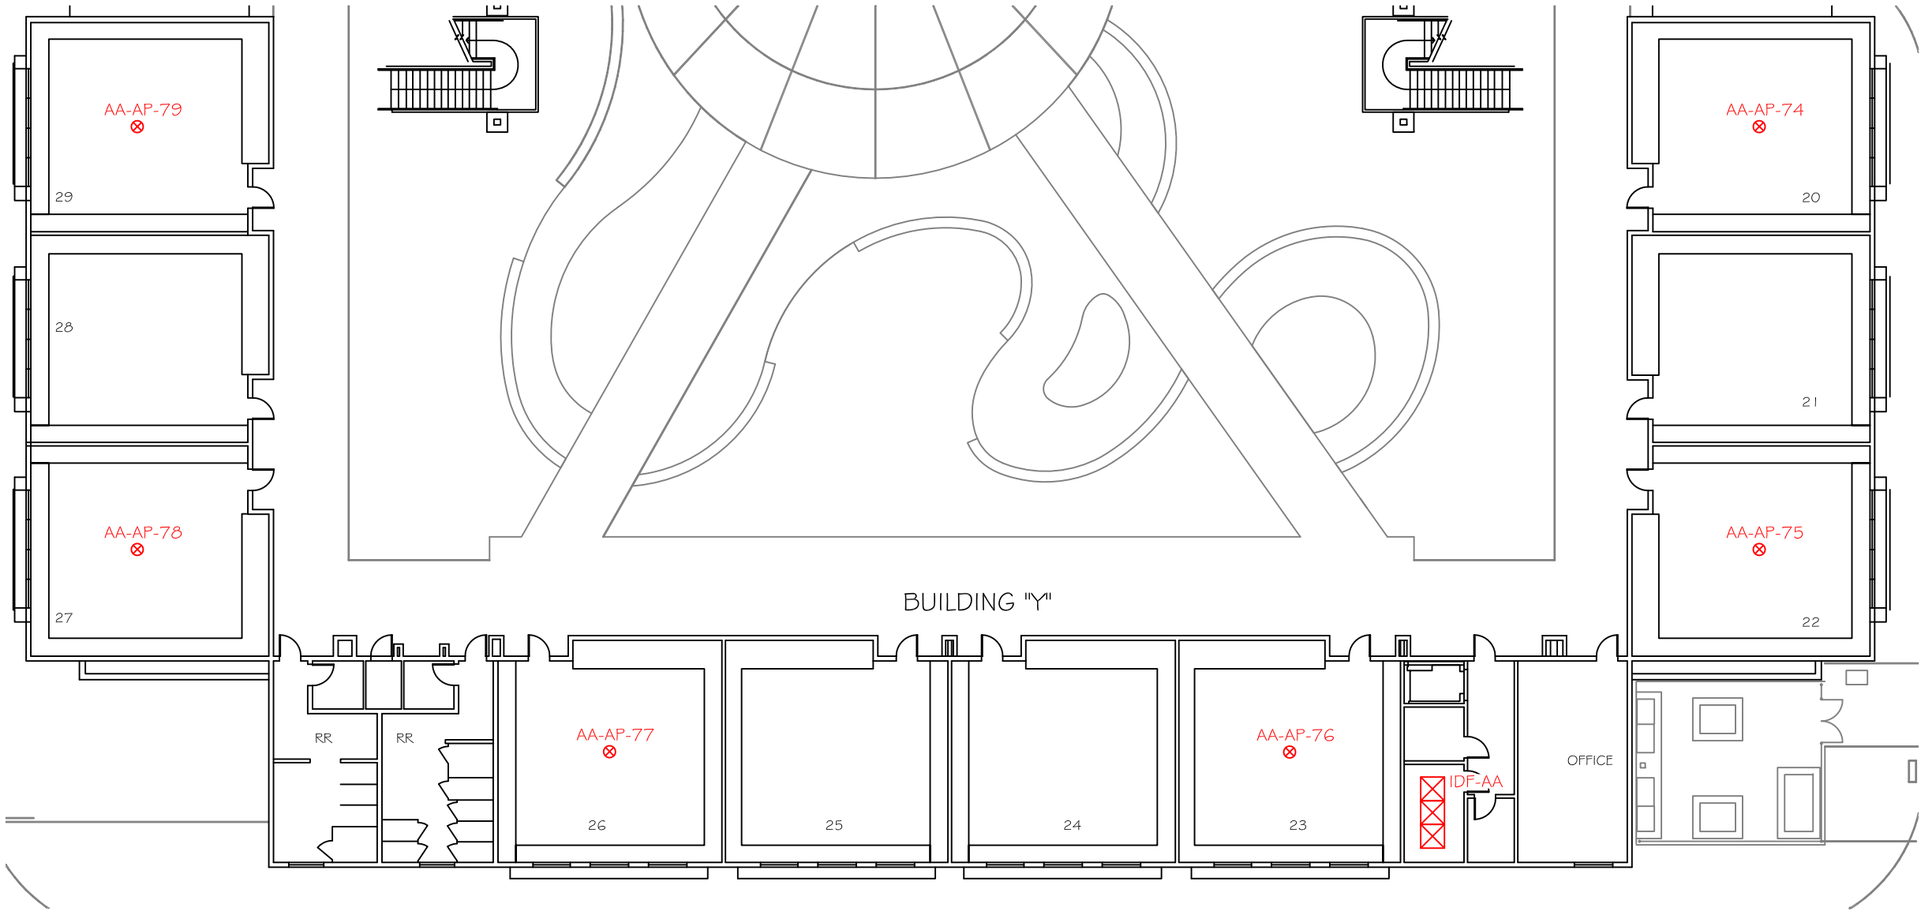


IDF- AA - WIRELESS ACCESS POINT PLAN

SCALE: 3/64" = 1'-0"

LEGEND

⊗ WIRELESS ACCESS POINT

KEYMAP NTS

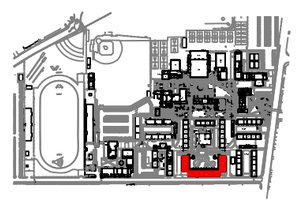

EASYNETWORKS CABLING
3538 SHELLEY WAY
RIVERSIDE, CA. 92503
OFFICE : 951. 742.8119
FAX : 951.742.8125
ST. LIC. # 936770

PREPARED FOR:

EL MONTE UNION HIGH SCHOOL DISTRICT

SITE:

ARROYO HIGH SCHOOL

4921 CEDAR AVENUE
EL MONTE, CA 91732

AS-BUILT
PROJECT NO. 5231

REVISIONS:

#	DATE:	DESCRIPTION:

DRAWN BY: GERARDO MORALES

DATE: 10/9/12
SCALE: AS SHOWN
SIZE: 11x17

TITLE:

IDF-AA WIRELESS ACCESS POINT PLAN


• PROPERTY OF EASY NETWORKS •
• FOR USE BY EASY NETWORK ONLY •

SHEET#:

T27

27 OF 29

EASY NETWORKS - 5231 IDF AA, 10/17/2012 4:56:12 PM, 11 x 17

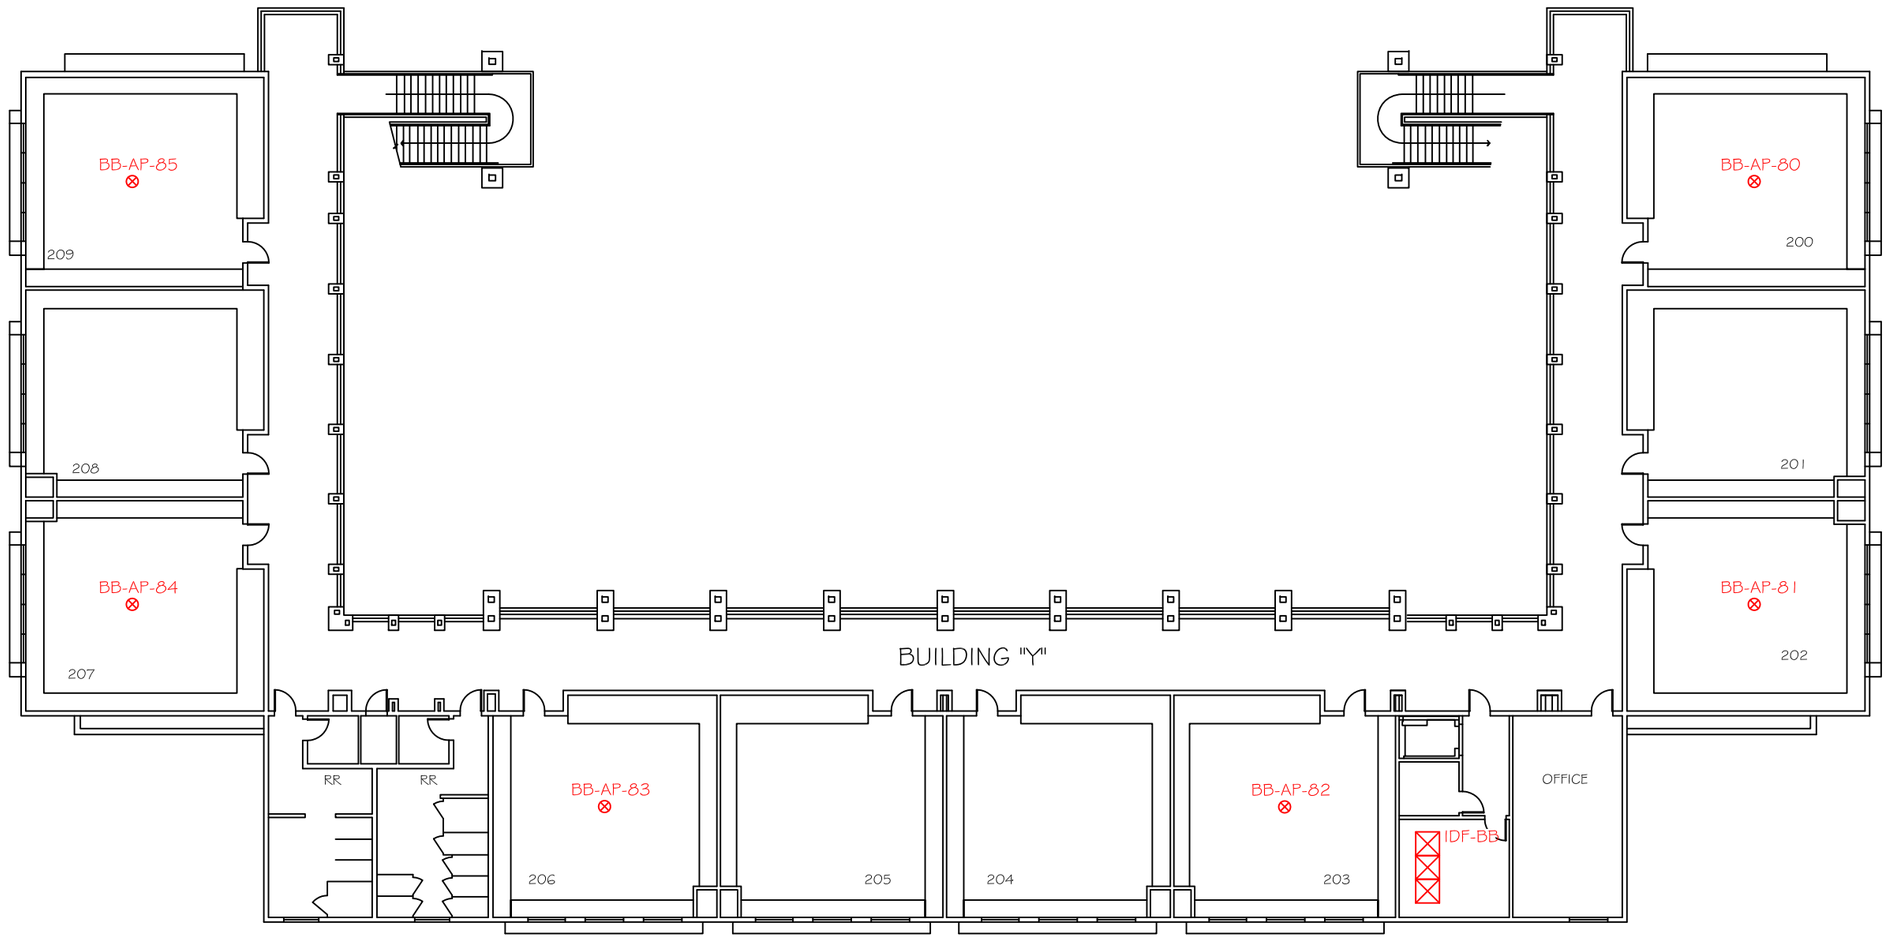


IDF- BB - WIRELESS ACCESS POINT PLAN

SCALE: 3/64" = 1'-0"

LEGEND

⊗ WIRELESS ACCESS POINT

KEYMAP
NTS

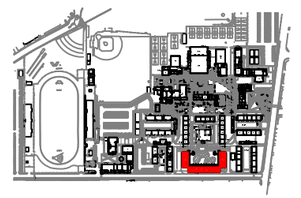

EASYNETWORKS CABLING
3538 SHELLEY WAY
RIVERSIDE, CA. 92503
OFFICE : 951. 742.8119
FAX : 951.742.8125
ST. LIC. # 936770

PREPARED FOR:

EL MONTE UNION HIGH SCHOOL DISTRICT

SITE:

ARROYO HIGH SCHOOL

4921 CEDAR AVENUE
EL MONTE, CA 91732

AS-BUILT
PROJECT NO. 5231

REVISIONS:

	DATE:	DESCRIPTION:

DRAWN BY:
GERARDO MORALES

DATE: 10/9/12
SCALE: AS SHOWN
SIZE: 11x17

TITLE:

IDF-BB WIRELESS ACCESS POINT PLAN


●PROPERTY OF EASY NETWORKS●
●FOR USE BY EASY NETWORK ONLY●

SHEET#:

T28

28 OF 29

EASY NETWORKS - 5231 IDF BB. 10/17/2012 4:55:58 PM. 11 x 17

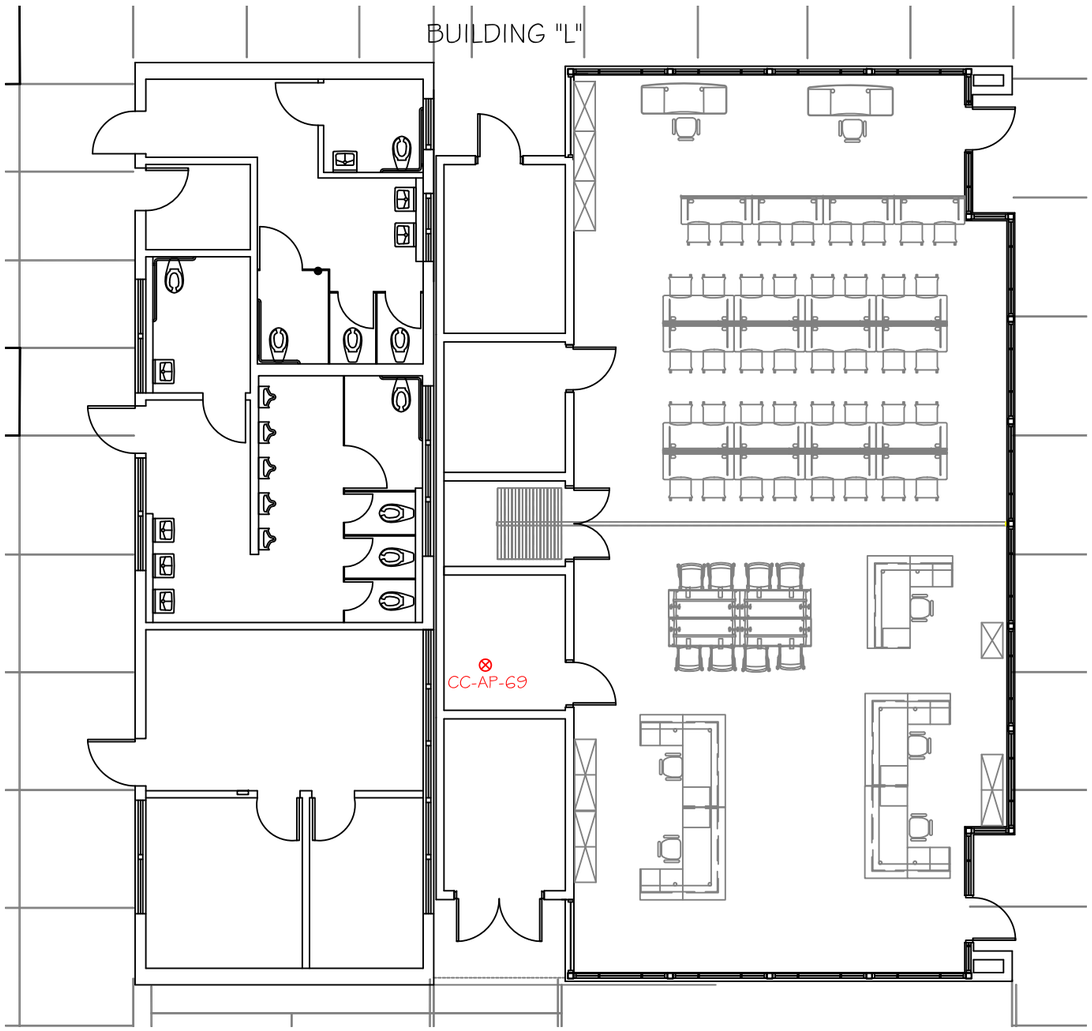


IDF- CC - WIRELESS ACCESS POINT PLAN

SCALE: 3/32" = 1'-0"

LEGEND

⊗ WIRELESS ACCESS POINT

KEYMAP
NTS

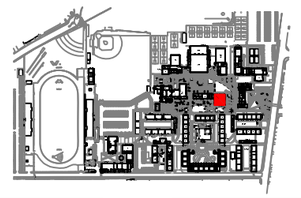

EASYNETWORKS CABLING
3538 SHELLEY WAY
RIVERSIDE, CA. 92503
OFFICE : 951. 742.8119
FAX : 951.742.8125
ST. LIC. # 936770

PREPARED FOR:

EL MONTE UNION HIGH SCHOOL DISTRICT

SITE:

ARROYO HIGH SCHOOL

4921 CEDAR AVENUE
EL MONTE, CA 91732

AS-BUILT
PROJECT NO. 5231

REVISIONS:

	DATE:	DESCRIPTION:

DRAWN BY:
GERARDO MORALES

DATE: 10/9/12
SCALE: AS SHOWN
SIZE: 11x17

TITLE:

IDF-CC WIRELESS ACCESS POINT PLAN

• PROPERTY OF EASY NETWORKS •
• FOR USE BY EASY NETWORK ONLY •


SHEET#:

T29

29 OF 29

EASY NETWORKS - 5231 IDF CC, 10/17/2012 4:55:32 PM, 11 x 17

KEYMAP
NTS

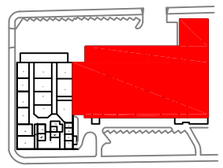

FIRST FLOOR - WIRELESS ACCESS POINT PLAN
N.T.S.

LEGEND

⊗ WIRELESS ACCESS POINT

EASYNETWORKS CABLING
3538 SHELLEY WAY
RIVERSIDE, CA. 92503
OFFICE : 951. 742.8119
FAX : 951.742.8125
ST. LIC. # 936770

PREPARED FOR:
EL MONTE UNION HIGH SCHOOL DISTRICT

SITE:
EL MONTE ADULT SCHOOL

10807 RAMONA BLVD
EL MONTE, CA 91731

AS-BUILT
PROJECT NO. 5231

REVISIONS:

#	DATE:	DESCRIPTION:

DRAWN BY:
GERARDO MORALES

DATE: 10/25/12
SCALE: AS SHOWN
SIZE: 11x17

TITLE:
FIRST FLOOR WIRELESS ACCESS POINT PLAN

● PROPERTY OF EASY NETWORKS ●
● FOR USE BY EASY NETWORK ONLY ●

SHEET#:
T1
1 OF 2

5231 - FIRST FLOOR PLAN, 10/25/2012 11:46:38 AM, 11 x 17

WIRELESS ACCESS POINT SCHEDULE			
AP #	Mac Address	Asset Tag	LOCATION
EMA-B.AP_20	002438F2CB7C	41060	Reception
EMA-B.AP_21	002438F2C9A4	41059	Outside of RM 141
EMA-B.AP_22	002438F2C85C	41062	Room 145
EMA-B.AP_23	002438F2CA00	41061	Conference Office
EMA-MDF.AP_24	002438F2C960	41064	Room 115
EMA-MDF.AP_25	002438F2C8F4	41065	Outside of RM 111
EMA-MDF.AP_26	002438F2C870	41066	Room 105
EMA-MDF.AP_27	002438F2C8FC	41063	Outside RM 102




ESL BUILDING - WIRELESS ACCESS POINT PLAN
N.T.S.

LEGEND

⊗ WIRELESS ACCESS POINT

KEYMAP
NTS

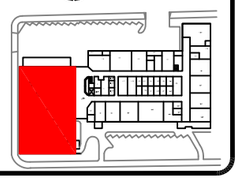

EASYNETWORKS CABLING
3538 SHELLEY WAY
RIVERSIDE, CA. 92503
OFFICE : 951. 742.8119
FAX : 951.742.8125
ST. LIC. # 936770

PREPARED FOR:

EL MONTE UNION HIGH SCHOOL DISTRICT

SITE:

EL MONTE ADULT SCHOOL

10807 RAMONA BLVD
EL MONTE, CA 91731

AS-BUILT
PROJECT NO. 5231

REVISIONS:

	DATE:	DESCRIPTION:

DRAWN BY: GERARDO MORALES

DATE: 10/25/12
SCALE: AS SHOWN
SIZE: 11x17

TITLE:

ESL BLDG. WIRELESS ACCESS POINT PLAN


• PROPERTY OF EASY NETWORKS •
• FOR USE BY EASY NETWORK ONLY •


SHEET#:


T2

2 OF 2

EASY NETWORKS - 5231 ESL BLDG, 10/25/2012 11:47:24 AM, 11 x 17

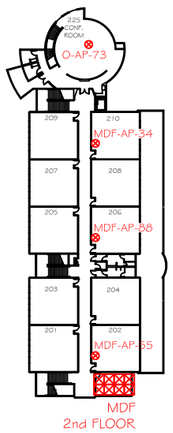

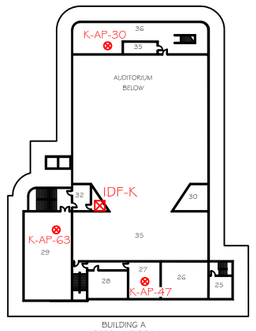

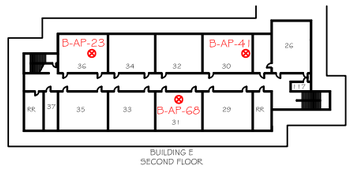

WIRELESS ACCESS POINT SCHEDULE

AP #	Mac Address	Asset Tag	LOCATION
EHS-A.AP 20	0023689310SC	40769	Room84 Old student sotore
EHS-I.AP_21	002368930804	40759	Independent Studies IDF-L3
EHS-I.AP_22	002368930C6C	40758	Room84_BldgB
EHS B.AP 23	002368930CDC	40757	Room36 BldgF 2nd Floor
EHS A.AP 24	0023689309FC	40767	RM18 IDF A
EHS A.AP 25	002368930A18	40768	Room21 BldgE
EHS-D.AP 26	002368930EEC	40766	Room45 BldgJ
EHS-K.AP_27	002368930DC4	40770	Auditorium
EHS-D.AP_28	002368930C10	40771	Room46_BldgF
EHS K.AP_30	002368931198	40772	Room36_Auditorium_2nd_floor
EHS A.AP 31	0023689311FC	40762	MailRoom Admin
EHS-E.AP_32	0023689309DC	40763	Science bldg isle
EHS-K.AP 33	002368931368	40764	Room22 Auditorium
EHS-MDF.AP_34	0023689312D8	40760	Room210_2nd_Floor_New_Bldg
EHS-I.AP_35	002368930884	40761	Room81_BldgB
EHS C.AP 36	0023689313C4	40765	RM Police IDF C
EHS E.AP 37	002368930914	36131	Room55 IDF F
EHS A.AP 38	0023689310F0	40755	Room14 BldgE
EHS-O.AP 39	0023689313AM	40754	Room127 BldgO
EHS-A.AP_40	002368931060	40848	Room15_BldgE
EHS-B.AP_41	002368931114	40845	Room30_BldgE_2nd_Floor
EHS K.AP 42	0023689305A8	40844	Room2 Auditorium
EHS F.AP 43	0023689309F8	40846	RM61 BldgI
EHS-M.AP 44	002368930980	40851	Boys Locker Room
EHS-J.AP 45	002368930AEC	40849	Room218 Old Library
EHS-MDF.AP_46	0023689305C8	40850	Room107_1st_Floor_New_Bldg
EHS K.AP_47	002368930DD0	40852	Room27_Auditorium_2nd_Floor
EHS N.AP 48	0023689311?R	40847	Room4 BldgC
EHS E.AP 49	0023689309?C	40841	Lab Cience Bldg
EHS L.AP 50	002368930B90	40837	Room226 BldgM
EHS-G.AP 51	002368931318	40836	Room74 BldgM
EHS-L.AP_52	0023688C0E78	40834	Room235_BldgM
EHS-C.AP_53	002368931088	40833	Room56_Cience_Bldg
EHS M.AP 54	0023689300C	40839	Gym BldgK
EHS MDF.AP 55	002368931354	40838	Room202 2nd Floor New Bldg
EHS-K.AP 56	002368930CC8	40842	Auditorium
EHS-E.AP 57	002368931DFC	40843	Room50 Cience Bldg
EHS-H.AP_58	002368930A74	36024	Room202_Kitchen
EHS F.AP_59	002368930B7C	36027	Room63_BldgI
EHS C.AP_60	002368930A64	36023	Office BldgH
EHS K.AP 61	002368930870	36025	Room9 Auditorium
EHS M.AP 62	002368930C88	36030	Gym BldgK
EHS-K.AP 63	002368931410	36028	Room29 Auditorium 2nd Floor
EHS-J.AP_64	002368930DA0	36031	Room218_Old_Library
EHS-M.AP_65	002368931300	36029	Boys_Coach_Office
EHS K.AP 66	002368930AAR	36033	Stage Auditorium
EHS A.AP 67	002368930ADC	36035	Principal Office
EHS-B.AP 68	002368930AC4	36036	Room31 2nd Floor BldgE
EHS-D.AP 69	002368931?6C	36037	Room40 BldgI
EHS-H.AP_70	002368930C58	36142	Room222_BldgN
EHS O.AP_71	002368931100	36039	Room41_BldgF
EHS F.AP_72	002368930096C	36032	RM66 IDF F
EHS O.AP 73	002368930EF4	36040	MediaCenter 2nd Floor New Bldg
EHS-I.AP_74	002368930BC0	36183	Library IDF-I
EHS-I.AP 76	002368930854	36184	ASB-Office IDF-D
EHS-G.AP_80	002368930A48	36191	Room76_BldgM
EHS-J.AP_81	002368R83C34	36098	Room200_Cafete
EHS N.AP 82	0023689309CC	36187	Room3 BldgC
EHS N.AP 83	00236893078c	36056	Room7 BldgC
EHS-MDF.AP 84	0023689311d8	36050	Room112 1st Fl
EHS-MDI.AP_85	002368930?0c	36051	Room102_1st_Fl
EHS-O.AP_86	002368930d04	36058	Room132_BldgO
EHS O.AP_87	002368930a00	96454	Autoshop_BldgO
EHS MDF.AP_88	0023689305A7C	40840	Room206 2nd Floor New Bldg
EHS IDF M.AP_89	002368930FF8	41014	BigGym IDF M
EHS-IDF-M.AP_90	002368931348	41013	Basketball courts IDF-M

WIRELESS ACCESS POINT PLAN

SCALE: 1" = 100'-0"

LEGEND

⊗ WIRELESS ACCESS POINT

EASYNETWORKS CABLING

3538 SHELLEY WAY
RIVERSIDE, CA. 92503
OFFICE : 951. 742.8119
FAX : 951.742.8125
ST. LIC. # 936770

PREPARED FOR:

EL MONTE UNION HIGH SCHOOL DISTRICT

SITE:

EL MONTE HIGH SCHOOL

3048 TYLER AVE
EL MONTE, CA 91731

AS-BUILT
PROJECT NO. 5231

REVISIONS:

#	DATE:	DESCRIPTION:

DRAWN BY: GERARDO MORALES

DATE: 10/9/12
SCALE: AS SHOWN
SIZE: 11x17

TITLE:

WIRELESS ACCESS POINT PLAN


● PROPERTY OF EASY NETWORKS ●
● FOR USE BY EASY NETWORK ONLY ●


SHEET#:

T1

1 OF 17

EASY NETWORKS - 5231, 10/17/2012 4:44:04 PM, Tabloid

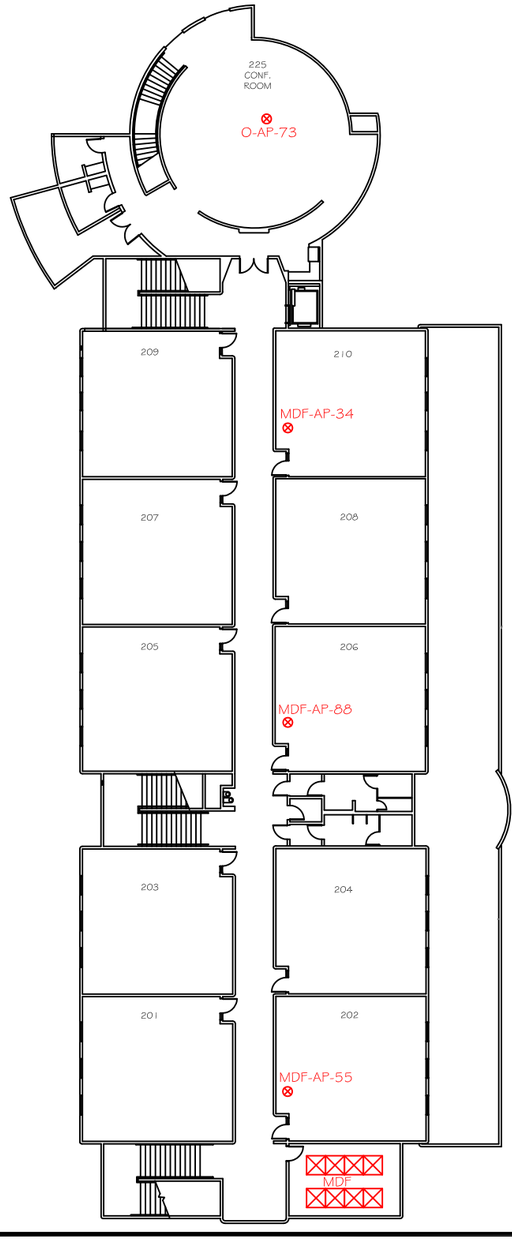

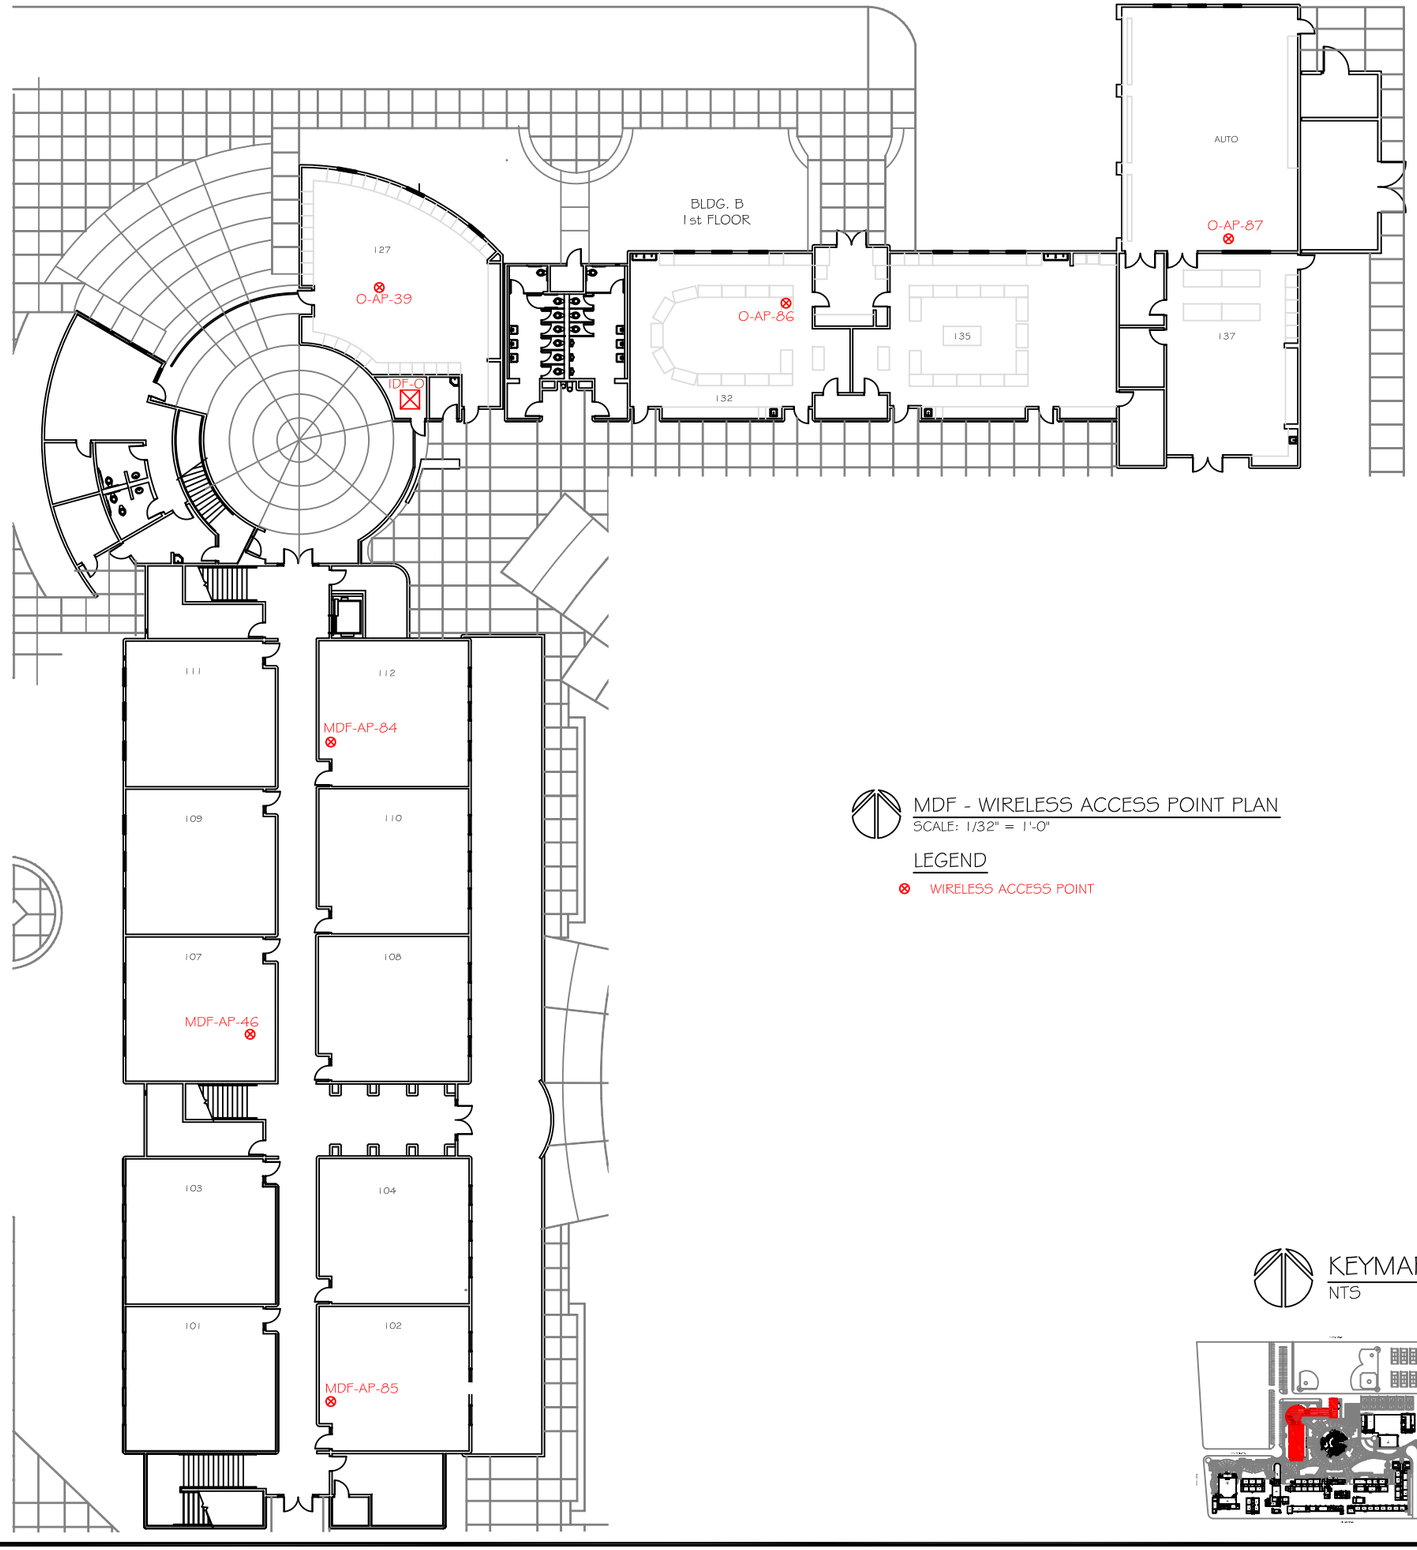

MDF - WIRELESS ACCESS POINT PLAN
SCALE: 1/32" = 1'-0"

LEGEND

⊗ WIRELESS ACCESS POINT

KEYMAP
NTS

EASYNETWORKS CABLING
3538 SHELLEY WAY
RIVERSIDE, CA. 92503
OFFICE : 951. 742.8119
FAX : 951.742.8125
ST. LIC. # 936770

PREPARED FOR:

EL MONTE UNION HIGH SCHOOL DISTRICT

SITE:

EL MONTE HIGH SCHOOL

3048 TYLER AVE
EL MONTE, CA 91731

AS-BUILT
PROJECT NO. 5231

REVISIONS:

#	DATE:	DESCRIPTION:

DRAWN BY:
GERARDO MORALES

DATE: 10/9/12
SCALE: AS SHOWN
SIZE: 11x17

TITLE:

MDF WIRELESS ACCESS POINT PLAN


• PROPERTY OF EASY NETWORKS •
• FOR USE BY EASY NETWORK ONLY •

SHEET#:

T2

2 OF 17

EASY NETWORKS - 5231 MDF_ 10/17/2012 4:44:29 PM, Tabloid

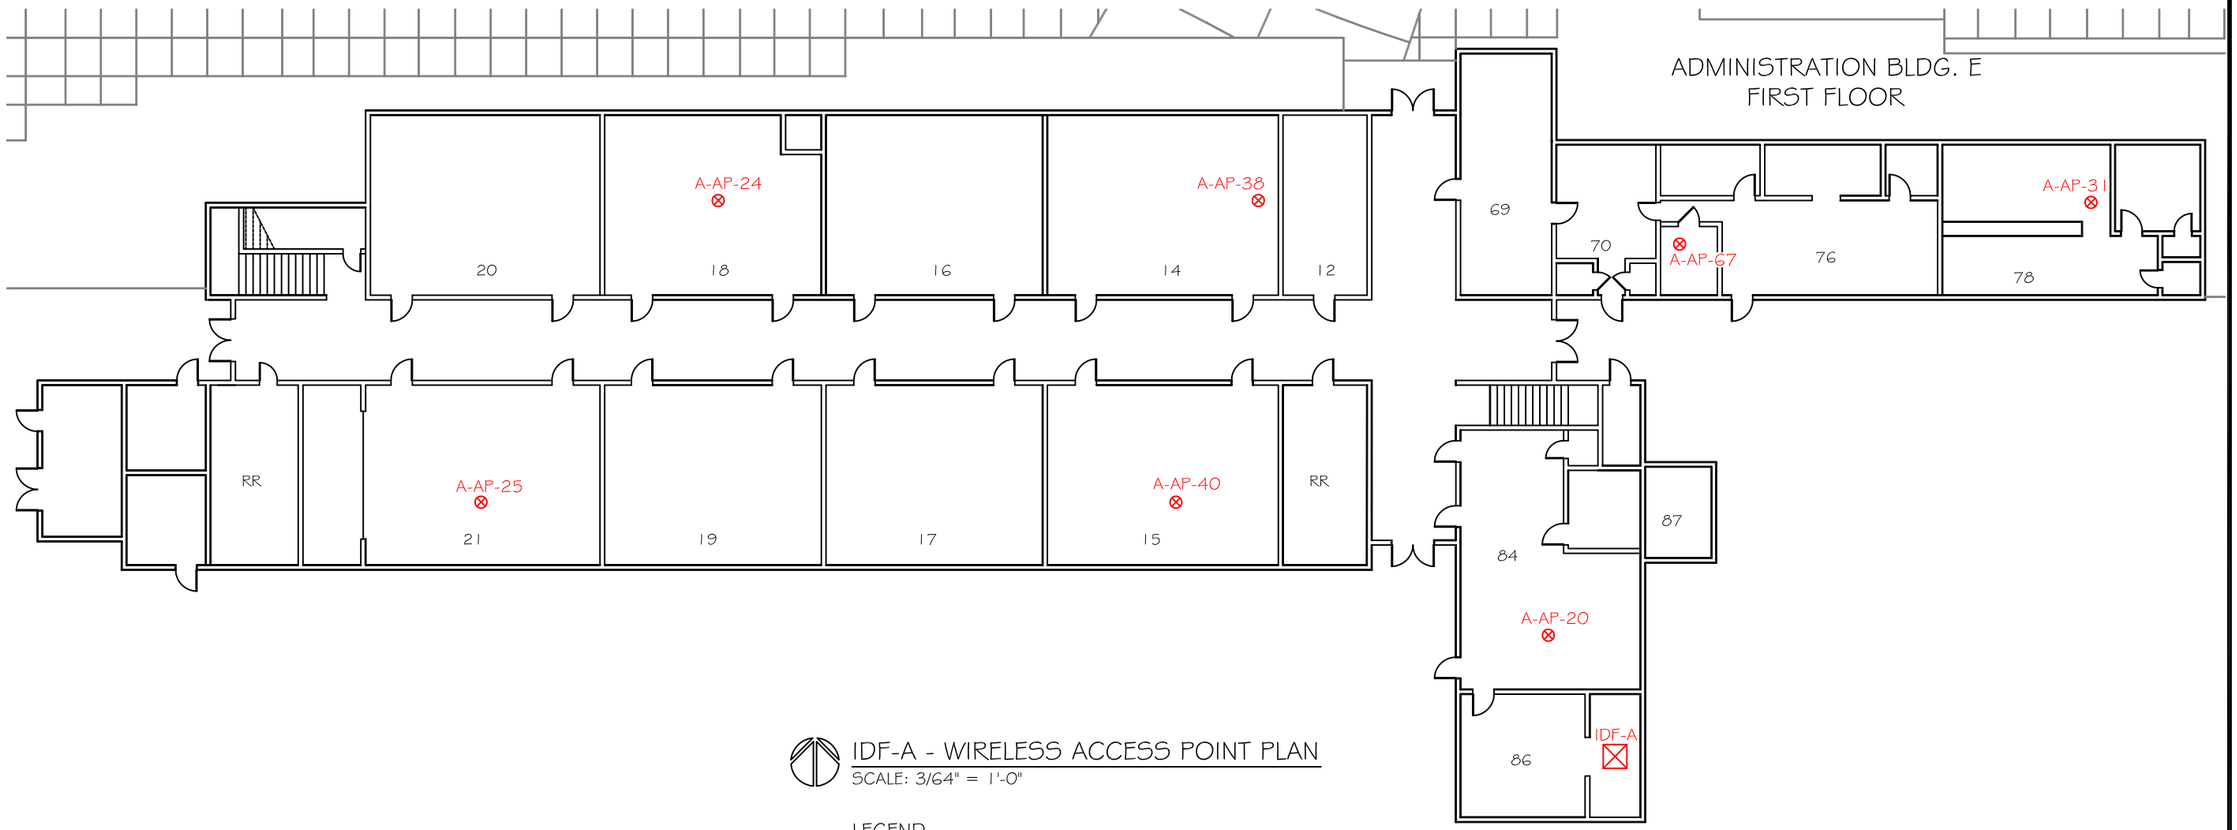


IDF-A - WIRELESS ACCESS POINT PLAN

SCALE: 3/64" = 1'-0"

LEGEND

⊗ WIRELESS ACCESS POINT

KEYMAP
NTS

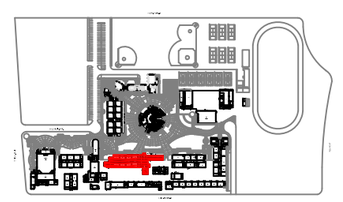

EASYNETWORKS CABLING
3538 SHELLEY WAY
RIVERSIDE, CA. 92503
OFFICE : 951. 742.8119
FAX : 951.742.8125
ST. LIC. # 936770

PREPARED FOR:

EL MONTE UNION HIGH SCHOOL DISTRICT

SITE:

EL MONTE HIGH SCHOOL

3048 TYLER AVE
EL MONTE, CA 91731

AS-BUILT
PROJECT NO. 5231

REVISIONS:

#	DATE:	DESCRIPTION:

DRAWN BY:
GERARDO MORALES

DATE: 10/9/12
SCALE: AS SHOWN
SIZE: 11x17

TITLE:

IDF-A WIRELESS ACCESS POINT PLAN


● PROPERTY OF EASY NETWORKS ●
● FOR USE BY EASY NETWORK ONLY ●

SHEET#:

T3

3 OF 17

EASY NETWORKS - 5231 IDF A, 10/17/2012 4:44:52 PM, Tabloid

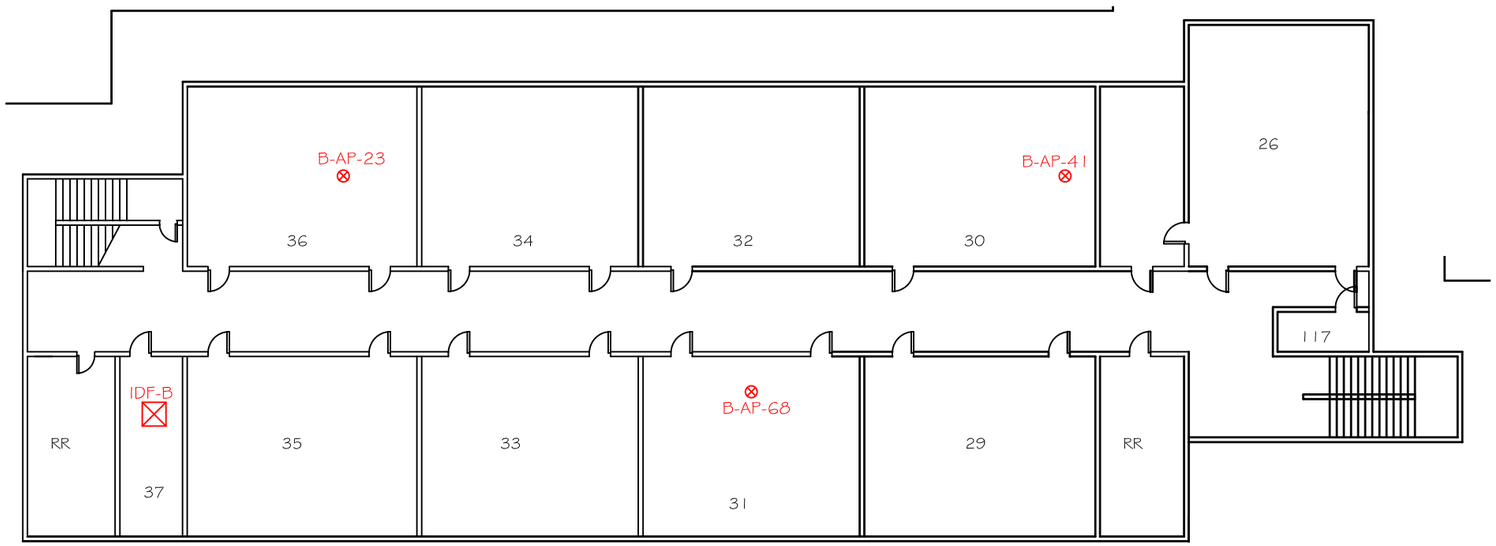


IDF-B - WIRELESS ACCESS POINT PLAN
SCALE: 3/64" = 1'-0"

LEGEND

⊗ WIRELESS ACCESS POINT

KEYMAP
NTS

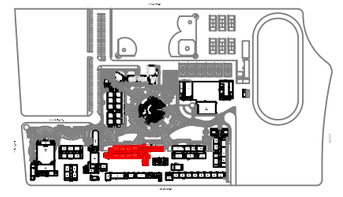

EASYNETWORKS CABLING
3538 SHELLEY WAY
RIVERSIDE, CA. 92503
OFFICE : 951. 742.8119
FAX : 951.742.8125
ST. LIC. # 936770

PREPARED FOR:
EL MONTE UNION HIGH SCHOOL DISTRICT

SITE:
EL MONTE HIGH SCHOOL

3048 TYLER AVE
EL MONTE, CA 91731

AS-BUILT
PROJECT NO. 5231

REVISIONS:

	DATE:	DESCRIPTION:
1		

DRAWN BY:
GERARDO MORALES


DATE: 10/9/12
SCALE: AS SHOWN
SIZE: 11x17

TITLE:
IDF-B WIRELESS ACCESS POINT PLAN

● PROPERTY OF EASY NETWORKS ●
● FOR USE BY EASY NETWORK ONLY ●

SHEET#:
T4
4 OF 17

EASY NETWORKS - 5231 IDF B, 10/17/2012 4:45:00 PM, Tabbdi

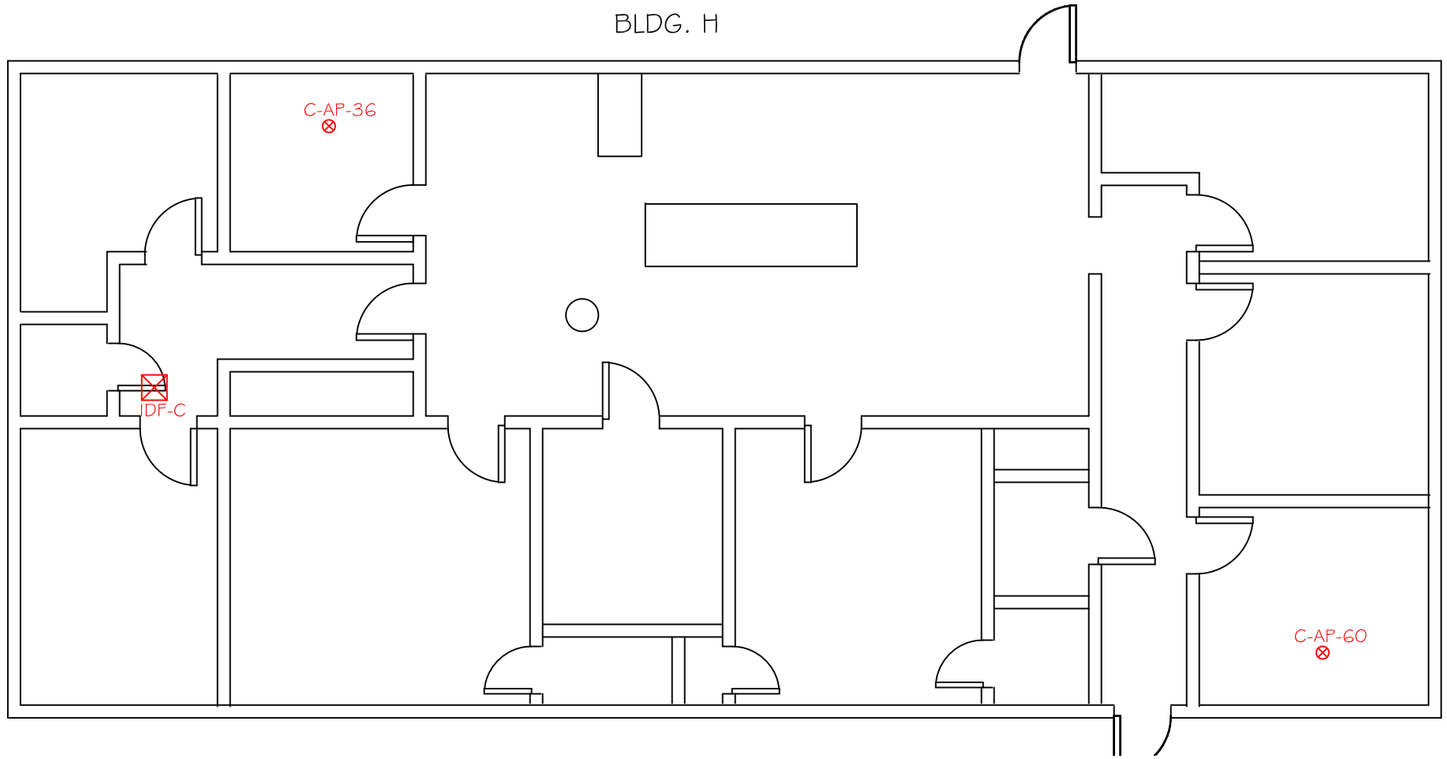


IDF-C - WIRELESS ACCESS POINT PLAN

SCALE: 1/8" = 1'-0"

LEGEND

⊗ WIRELESS ACCESS POINT

KEYMAP
NTS

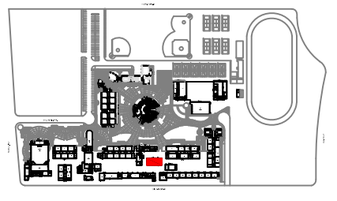

EASYNETWORKS CABLING
3538 SHELLEY WAY
RIVERSIDE, CA. 92503
OFFICE : 951. 742.8119
FAX : 951.742.8125
ST. LIC. # 936770

PREPARED FOR:

EL MONTE UNION HIGH SCHOOL DISTRICT

SITE:

EL MONTE HIGH SCHOOL

3048 TYLER AVE
EL MONTE, CA 91731

AS-BUILT
PROJECT NO. 5231

REVISIONS:

	DATE:	DESCRIPTION:
1		

DRAWN BY:
GERARDO MORALES

DATE: 10/9/12
SCALE: AS SHOWN
SIZE: 11x17

TITLE:

IDF-C WIRELESS ACCESS POINT PLAN

● PROPERTY OF EASY NETWORKS ●
● FOR USE BY EASY NETWORK ONLY ●


SHEET#:

T5

5 OF 17

EASY NETWORKS - 5231 IDF C, 10/17/2012 4:45:07 PM, Tabloid

BLDG. F

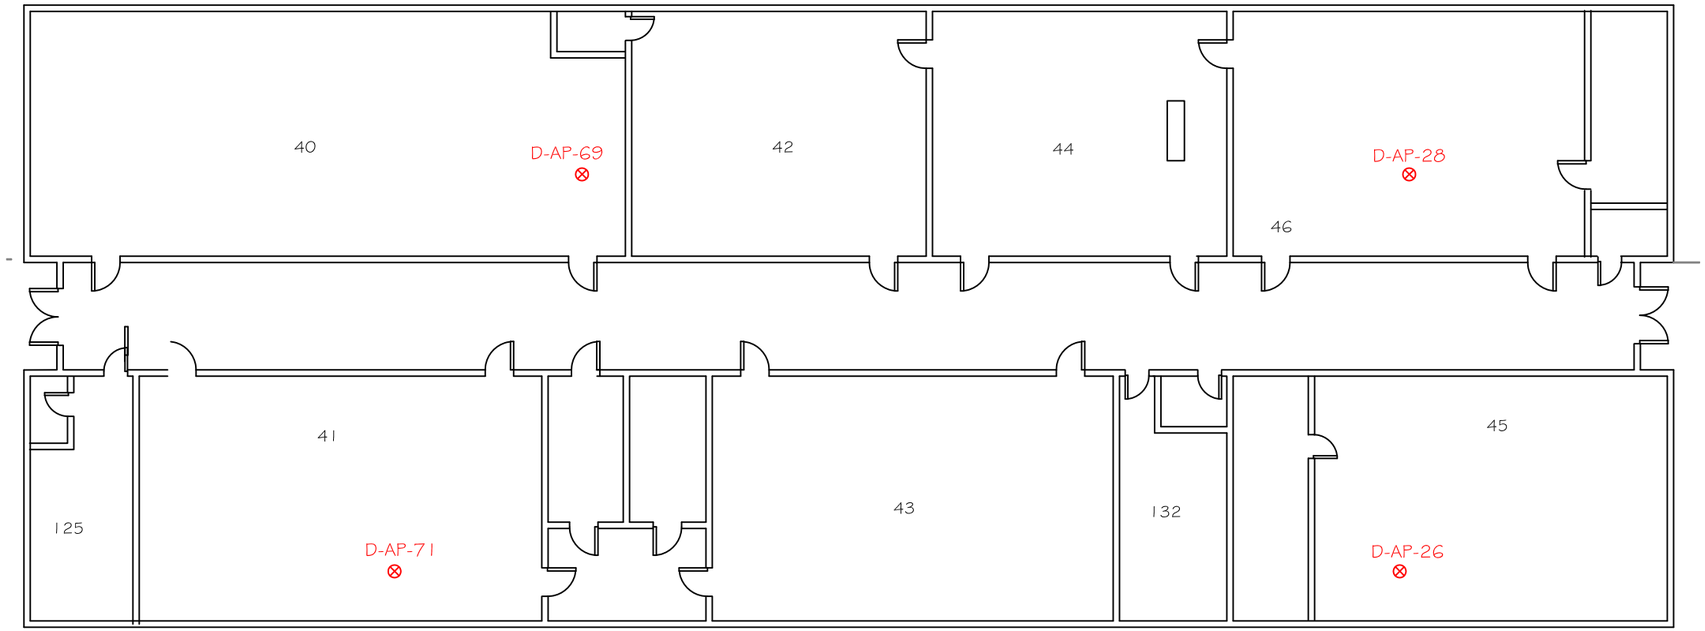

IDF-D


IDF-D - WIRELESS ACCESS POINT PLAN

SCALE: 1/16" = 1'-0"

LEGEND

⊗ WIRELESS ACCESS POINT

KEYMAP
NTS

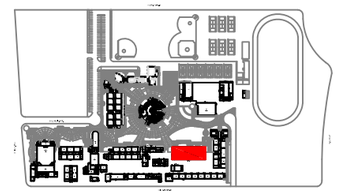

EASYNETWORKS CABLING

3538 SHELLEY WAY
RIVERSIDE, CA. 92503
OFFICE : 951. 742.8119
FAX : 951.742.8125
ST. LIC. # 936770

PREPARED FOR:

EL MONTE UNION HIGH SCHOOL DISTRICT

SITE:

EL MONTE HIGH SCHOOL

3048 TYLER AVE
EL MONTE, CA 91731

AS-BUILT
PROJECT NO. 5231

REVISIONS:

	DATE:	DESCRIPTION:

DRAWN BY:
GERARDO MORALES

DATE: 10/9/12
SCALE: AS SHOWN
SIZE: 11x17

TITLE:

IDF-D WIRELESS ACCESS POINT PLAN


• PROPERTY OF EASY NETWORKS •
• FOR USE BY EASY NETWORK ONLY •

SHEET#:

T6

6 OF 17

EASY NETWORKS - 5231 IDF D, 10/17/2012 4:45:15 PM, Tabloid

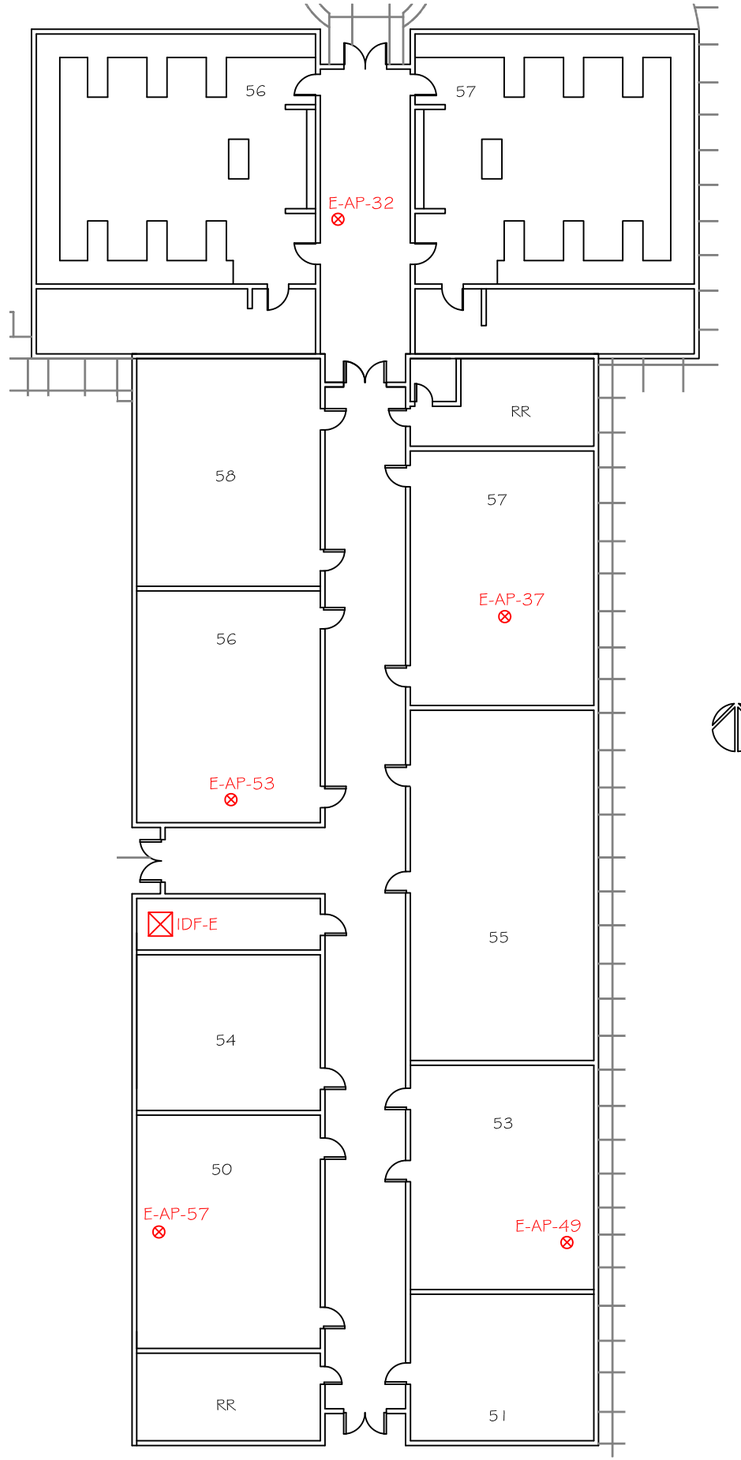


IDF-E - WIRELESS ACCESS POINT PLAN

SCALE: 3/64" = 1'-0"

LEGEND

⊗ WIRELESS ACCESS POINT

KEYMAP
NTS

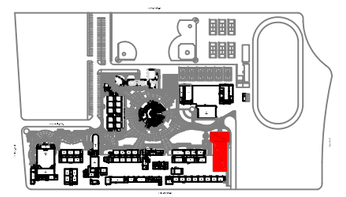

EASYNETWORKS CABLING

3538 SHELLEY WAY
RIVERSIDE, CA. 92503
OFFICE : 951. 742.8119
FAX : 951.742.8125
ST. LIC. # 936770

PREPARED FOR:

EL MONTE UNION HIGH SCHOOL DISTRICT

SITE:

EL MONTE HIGH SCHOOL

3048 TYLER AVE
EL MONTE, CA 91731

AS-BUILT
PROJECT NO. 5231

REVISIONS:

	DATE:	DESCRIPTION:

DRAWN BY: GERARDO MORALES

DATE: 10/9/12
SCALE: AS SHOWN
SIZE: 11x17

TITLE:

IDF-E WIRELESS ACCESS POINT PLAN

● PROPERTY OF EASY NETWORKS ●
● FOR USE BY EASY NETWORK ONLY ●


SHEET#:

T7

7 OF 17

EASY NETWORKS - 5231 IDF E, 10/17/2012 4:45:22 PM, Tablet

BLDG. 1

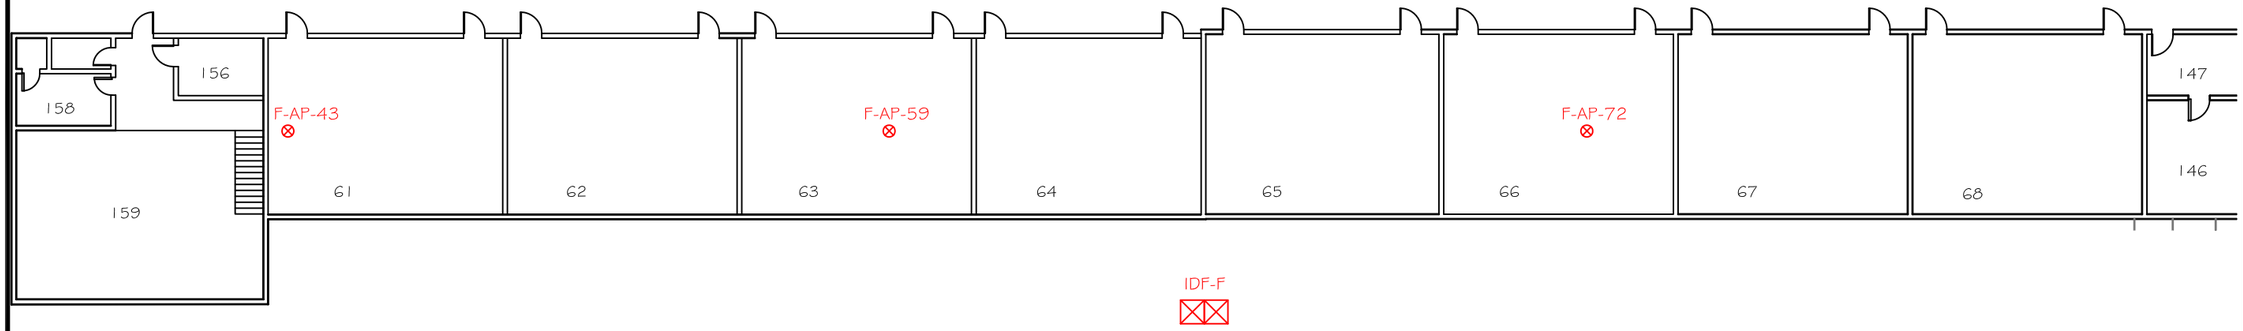

IDF-F - WIRELESS ACCESS POINT PLAN


SCALE: 3/64" = 1'-0"

LEGEND

⊗ WIRELESS ACCESS POINT

KEYMAP

NTS

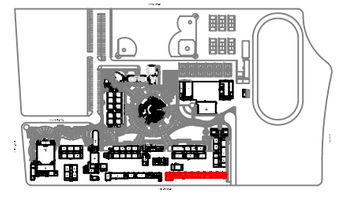

EASYNETWORKS CABLING

3538 SHELLEY WAY
RIVERSIDE, CA. 92503
OFFICE : 951. 742.8119
FAX : 951.742.8125
ST. LIC. # 936770

PREPARED FOR:

EL MONTE UNION HIGH SCHOOL DISTRICT

SITE:

EL MONTE HIGH SCHOOL

3048 TYLER AVE
EL MONTE, CA 91731

AS-BUILT
PROJECT NO. 5231

REVISIONS:

	DATE:	DESCRIPTION:
1		

DRAWN BY:
GERARDO MORALES

DATE: 10/9/12
SCALE: AS SHOWN
SIZE: 11x17

TITLE:

IDF-F WIRELESS ACCESS POINT PLAN

● PROPERTY OF EASY NETWORKS ●
● FOR USE BY EASY NETWORK ONLY ●


SHEET#:

T8

8 OF 17

EASY NETWORKS - 5231 IDF F, 10/17/2012 4:45:29 PM, Tabloid

BLDG. MM

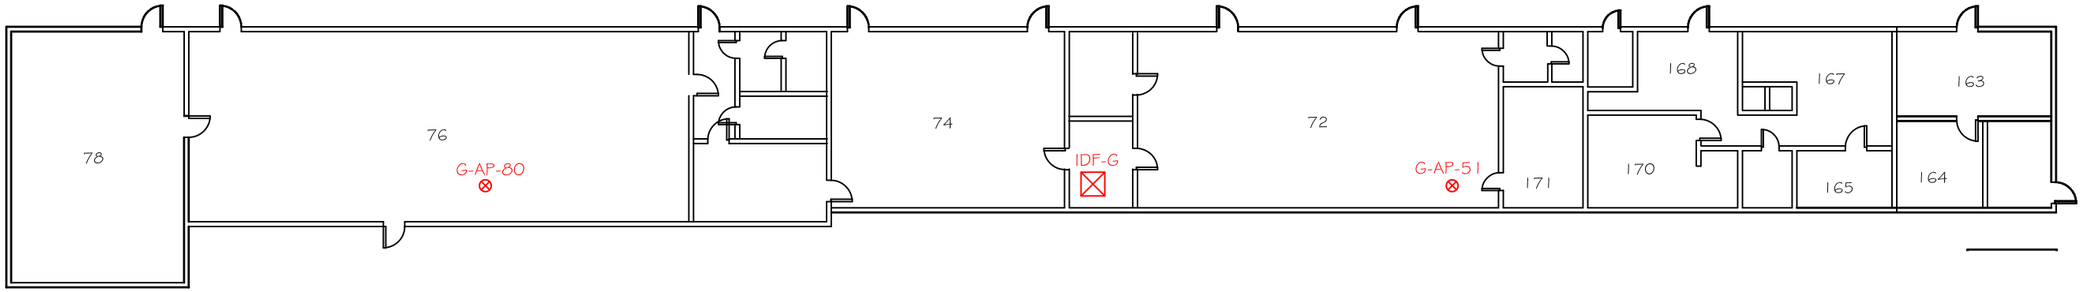


IDF-G - WIRELESS ACCESS POINT PLAN

SCALE: 3/64" = 1'-0"

LEGEND

⊗ WIRELESS ACCESS POINT

KEYMAP
NTS

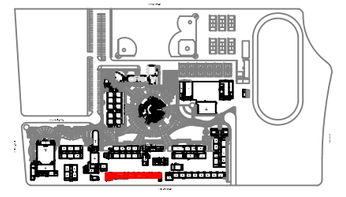

EASYNETWORKS CABLING
3538 SHELLEY WAY
RIVERSIDE, CA. 92503
OFFICE : 951. 742.8119
FAX : 951.742.8125
ST. LIC. # 936770

PREPARED FOR:

EL MONTE UNION HIGH SCHOOL DISTRICT

SITE:

EL MONTE HIGH SCHOOL

3048 TYLER AVE
EL MONTE, CA 91731

AS-BUILT
PROJECT NO. 5231

REVISIONS:

	DATE:	DESCRIPTION:
1		

DRAWN BY:
GERARDO MORALES

DATE: 10/9/12
SCALE: AS SHOWN
SIZE: 11x17

TITLE:

IDF-G WIRELESS ACCESS POINT PLAN


● PROPERTY OF EASY NETWORKS ●
● FOR USE BY EASY NETWORK ONLY ●

SHEET#:

T9

9 OF 17

EASY NETWORKS - 5231 IDF G, 10/17/2012 4:45:40 PM, Tabloid

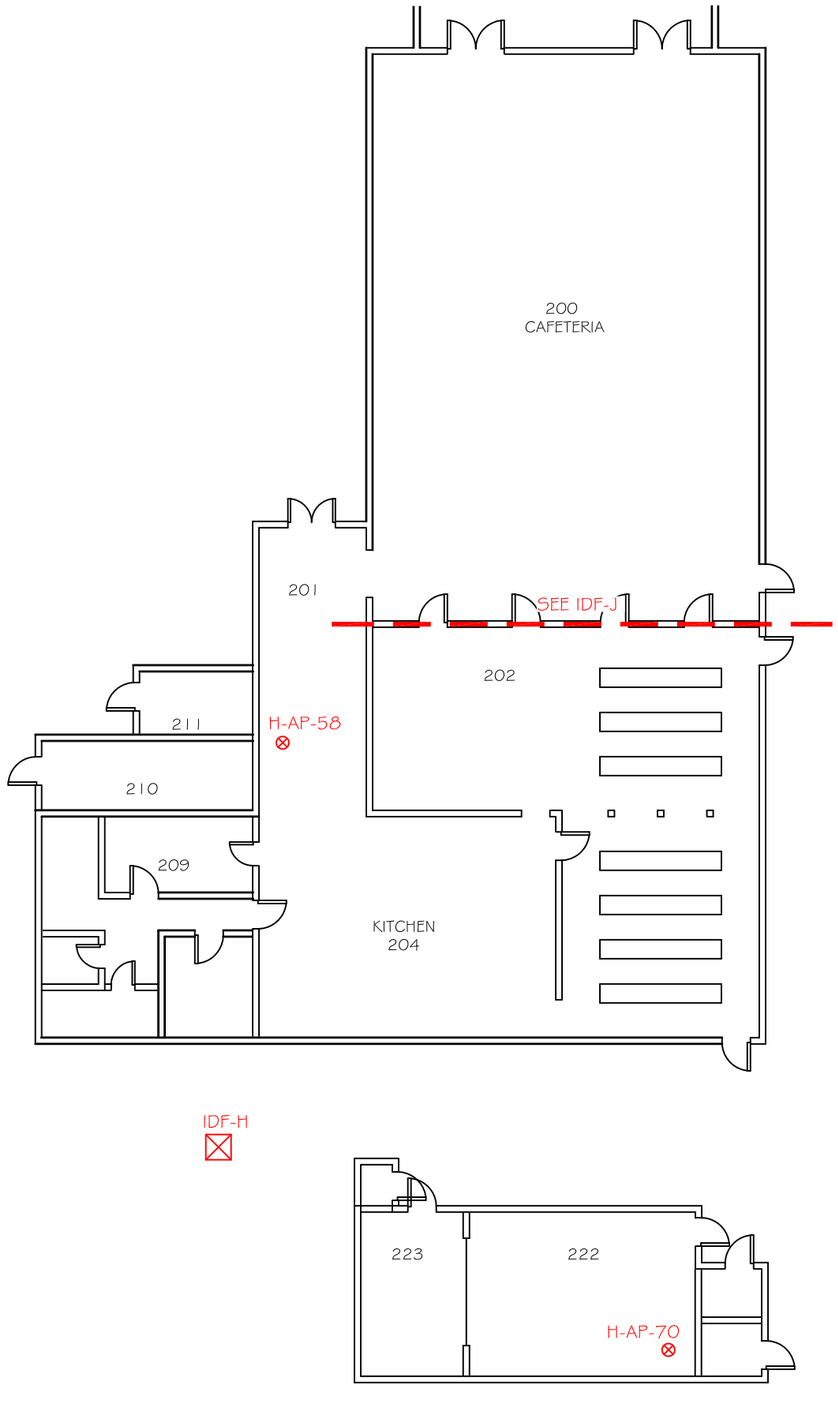


BLDG. NN

IDF-H - WIRELESS ACCESS POINT PLAN
SCALE: 1/16" = 1'-0"

LEGEND

⊗ WIRELESS ACCESS POINT

KEYMAP
NTS

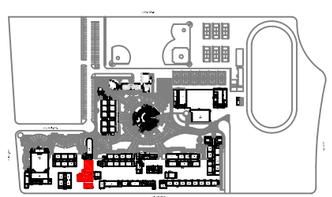

EASYNETWORKS CABLING
3538 SHELLEY WAY
RIVERSIDE, CA. 92503
OFFICE : 951. 742.8119
FAX : 951.742.8125
ST. LIC. # 936770

PREPARED FOR:

EL MONTE UNION HIGH SCHOOL DISTRICT

SITE:

EL MONTE HIGH SCHOOL

3048 TYLER AVE
EL MONTE, CA 91731

AS-BUILT
PROJECT NO. 5231

REVISIONS:

#	DATE:	DESCRIPTION:

DRAWN BY: GERARDO MORALES

DATE: 10/9/12
SCALE: AS SHOWN
SIZE: 11x17

TITLE:

IDF-H WIRELESS ACCESS POINT PLAN


● PROPERTY OF EASY NETWORKS ●
● FOR USE BY EASY NETWORK ONLY ●

SHEET#:

T10

10 OF 17

EASY NETWORKS - 5231 IDF H, 10/17/2012 4:45:51 PM, Tabloid

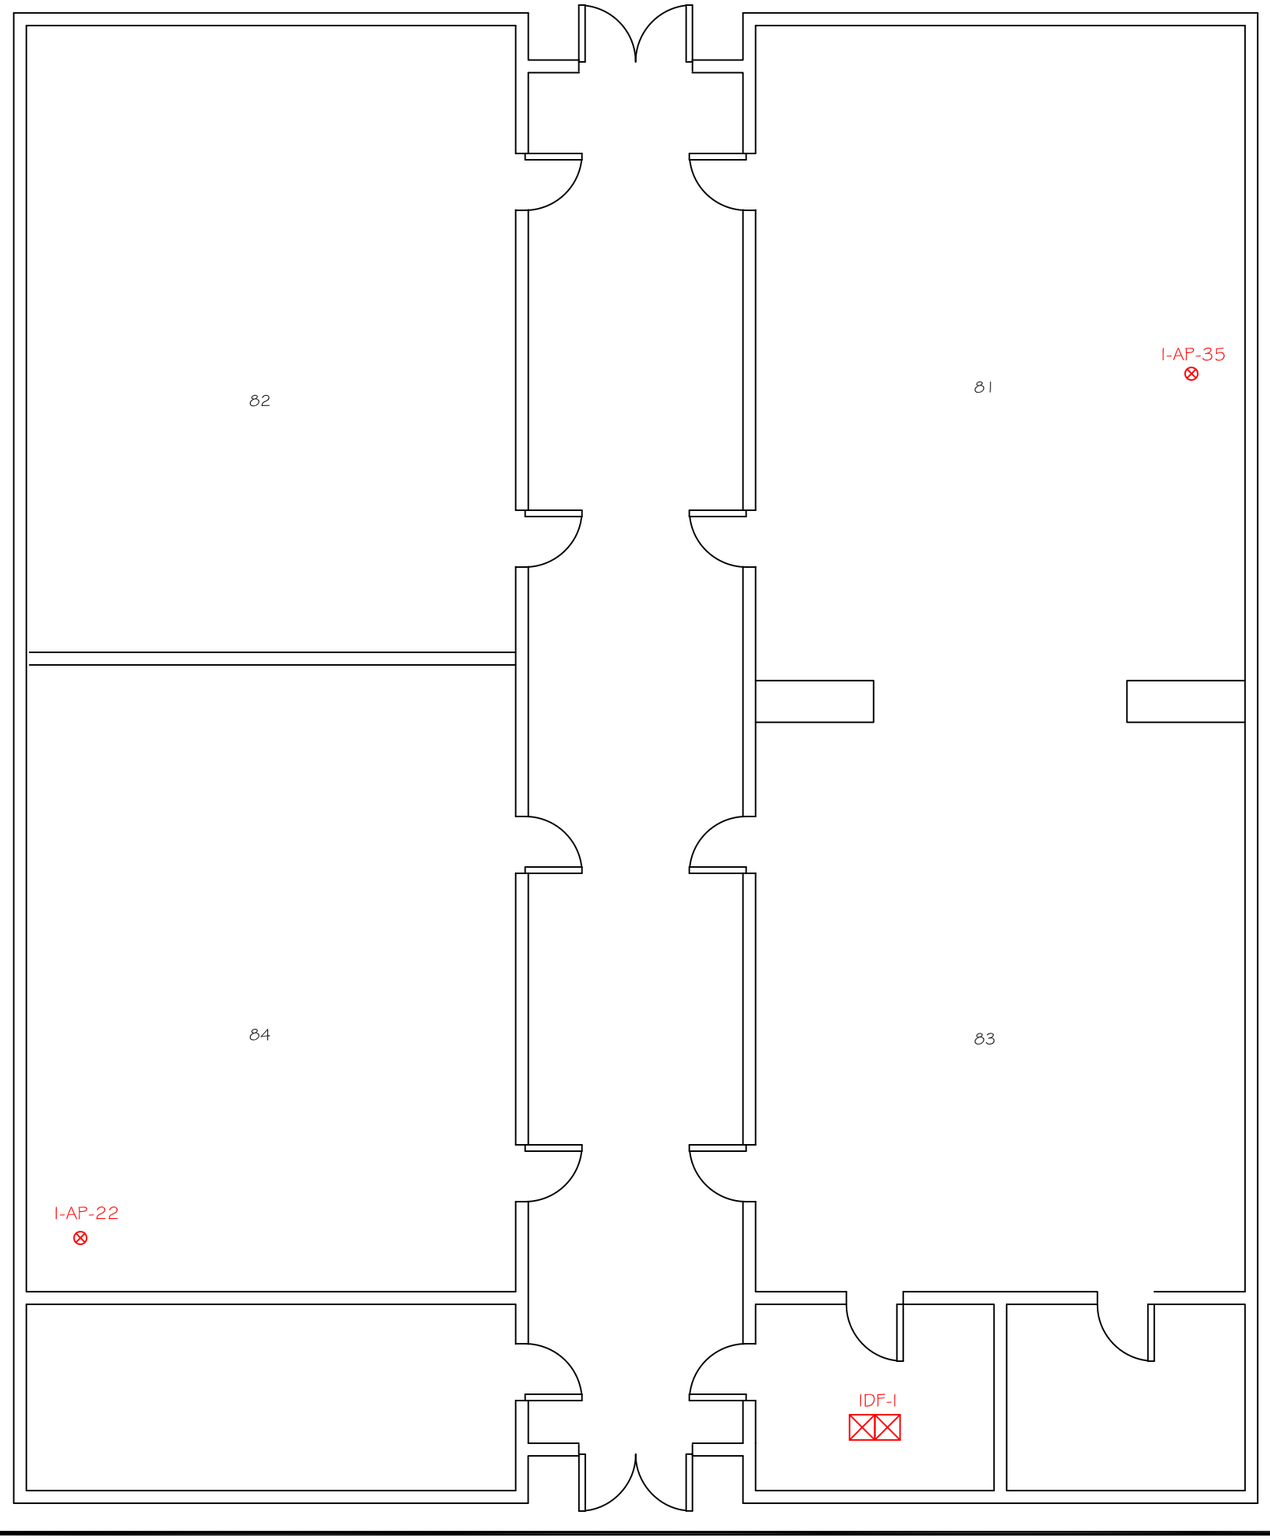


SCALE: 1/8" = 1'-0"

LEGEND

⊗ WIRELESS ACCESS POINT

KEYMAP
NTS

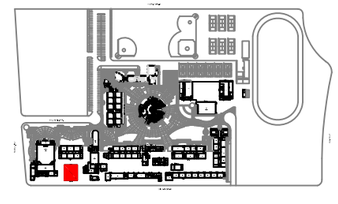

EASYNETWORKS CABLING
3538 SHELLEY WAY
RIVERSIDE, CA. 92503
OFFICE : 951. 742.8119
FAX : 951.742.8125
ST. LIC. # 936770

PREPARED FOR:

EL MONTE UNION HIGH SCHOOL DISTRICT

SITE:

EL MONTE HIGH SCHOOL

3048 TYLER AVE
EL MONTE, CA 91731

AS-BUILT
PROJECT NO. 5231

REVISIONS:

#	DATE:	DESCRIPTION:

DRAWN BY: GERARDO MORALES

DATE: 10/9/12
SCALE: AS SHOWN
SIZE: 11x17

TITLE:

IDF-I WIRELESS ACCESS POINT PLAN


● PROPERTY OF EASY NETWORKS ●
● FOR USE BY EASY NETWORK ONLY ●

SHEET#:

T11

11 OF 17

EASY NETWORKS - 5231 IDF I, 10/17/2012 4:46:01 PM, Tabloid

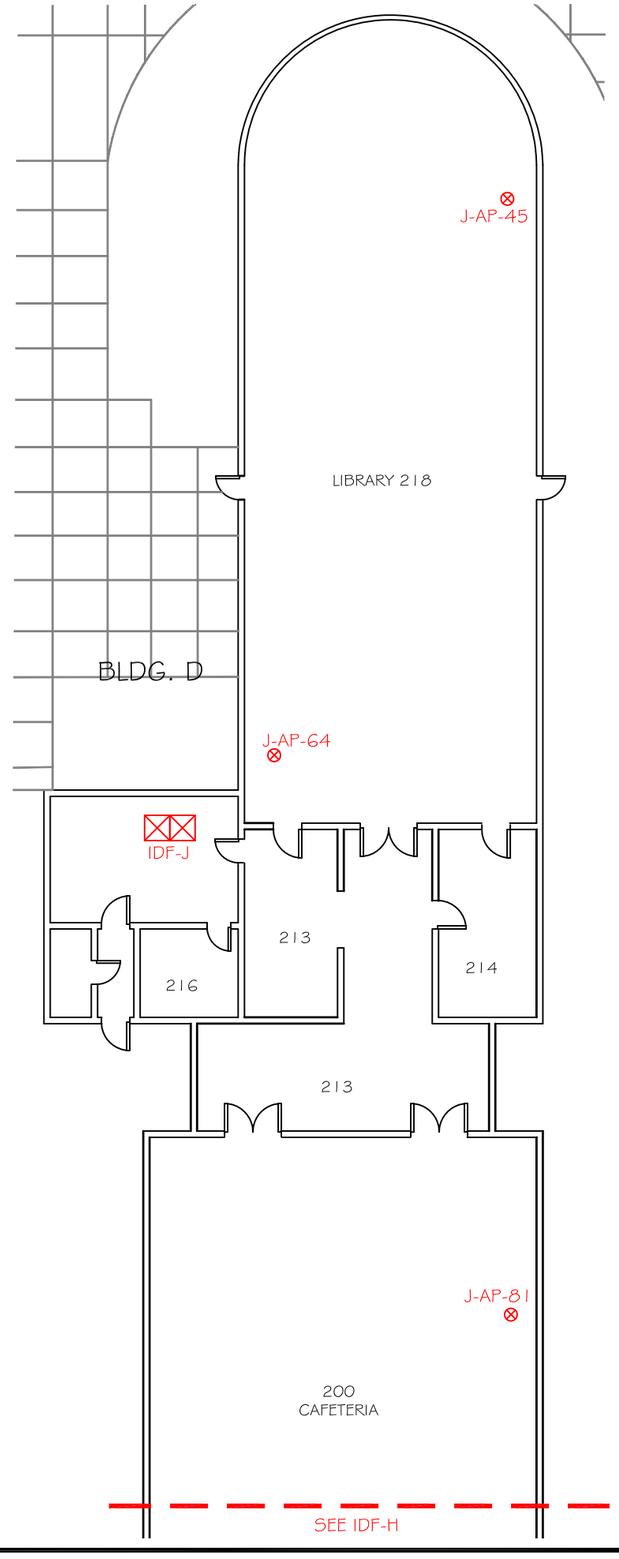


IDF-J - WIRELESS ACCESS POINT PLAN

SCALE: 1/16" = 1'-0"

LEGEND

⊗ WIRELESS ACCESS POINT

KEYMAP
NTS

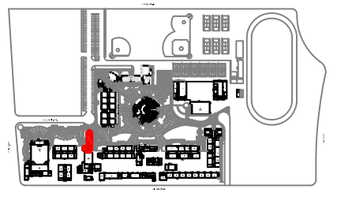

EASYNETWORKS CABLING

3538 SHELLEY WAY
RIVERSIDE, CA. 92503
OFFICE : 951. 742.8119
FAX : 951.742.8125
ST. LIC. # 936770

PREPARED FOR:

EL MONTE UNION HIGH SCHOOL DISTRICT

SITE:

EL MONTE HIGH SCHOOL

3048 TYLER AVE
EL MONTE, CA 91731

AS-BUILT
PROJECT NO. 5231

REVISIONS:

	DATE:	DESCRIPTION:
1		

DRAWN BY:
GERARDO MORALES

DATE: 10/9/12
SCALE: AS SHOWN
SIZE: 11x17

TITLE:

IDF-J WIRELESS ACCESS POINT PLAN


● PROPERTY OF EASY NETWORKS ●
● FOR USE BY EASY NETWORK ONLY ●


SHEET#:

T12

12 OF 17

EASY NETWORKS - 5231 IDF J, 10/17/2012 4:46:09 PM, Tabloid

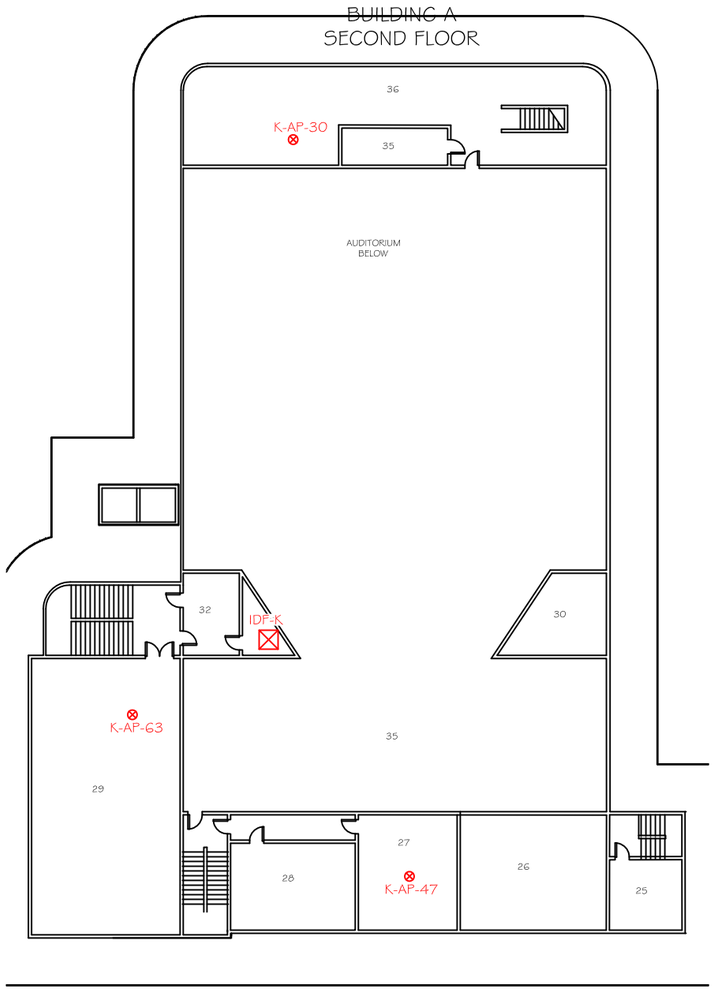

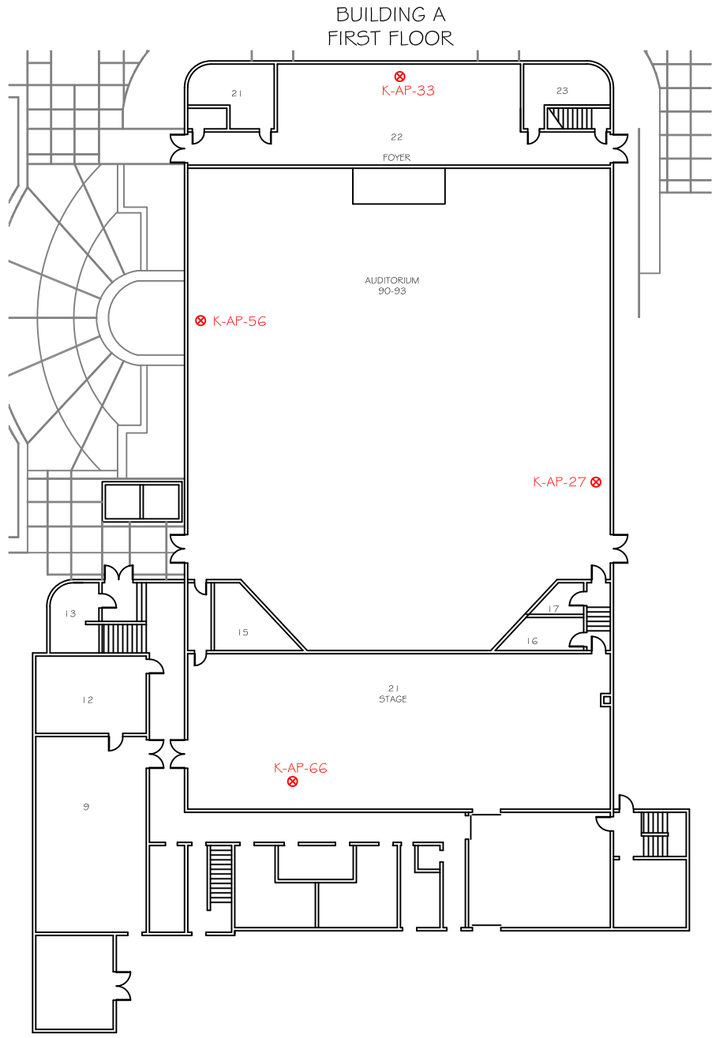


IDF-K - WIRELESS ACCESS POINT PLAN
SCALE: 1/32" = 1'-0"

LEGEND

⊗ WIRELESS ACCESS POINT

KEYMAP
NTS

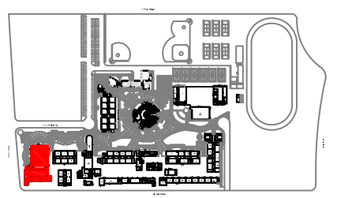

EASYNETWORKS CABLING
3538 SHELLEY WAY
RIVERSIDE, CA. 92503
OFFICE : 951. 742.8119
FAX : 951.742.8125
ST. LIC. # 936770

PREPARED FOR:

EL MONTE UNION HIGH SCHOOL DISTRICT

SITE:

EL MONTE HIGH SCHOOL

3048 TYLER AVE
EL MONTE, CA 91731

AS-BUILT
PROJECT NO. 5231

REVISIONS:

#	DATE:	DESCRIPTION:

DRAWN BY:
GERARDO MORALES

DATE: 10/9/12
SCALE: AS SHOWN
SIZE: 11x17

TITLE:

IDF-K WIRELESS ACCESS POINT PLAN


● PROPERTY OF EASY NETWORKS ●
● FOR USE BY EASY NETWORK ONLY ●

SHEET#:

T13

13 OF 17

EASY NETWORKS - 5231 IDF K, 10/17/2012 4:46:16 PM, Tabkid

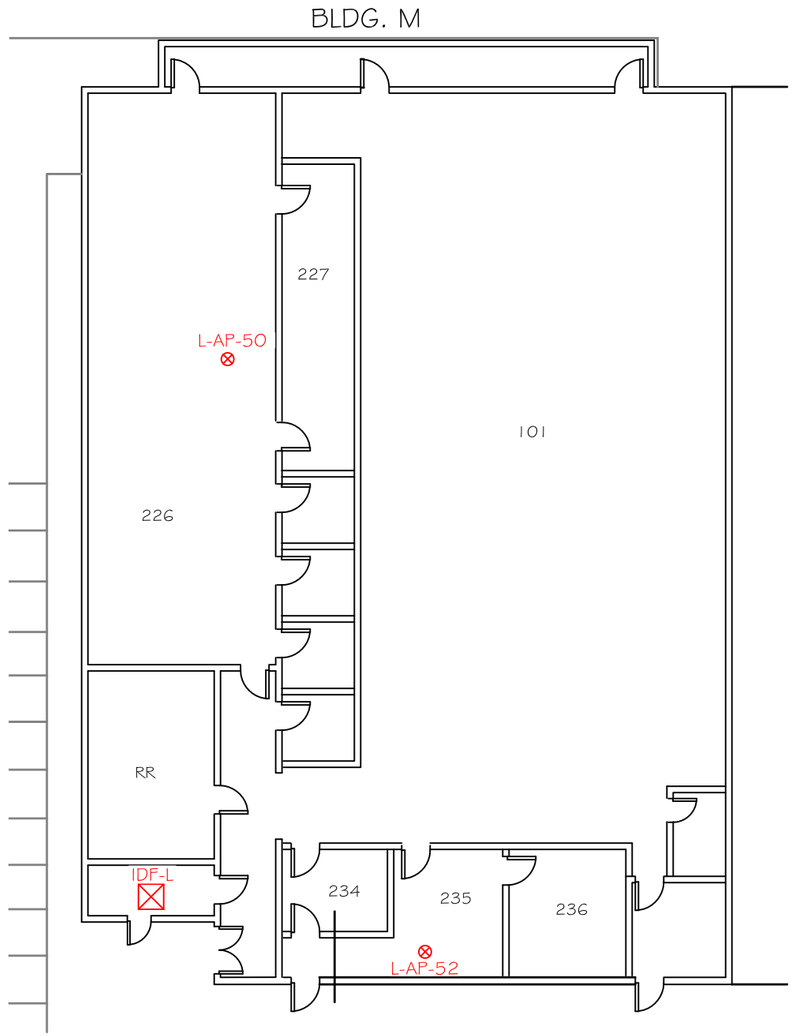


IDF-L - WIRELESS ACCESS POINT PLAN
SCALE: 3/64" = 1'-0"

LEGEND

⊗ WIRELESS ACCESS POINT

KEYMAP
NTS

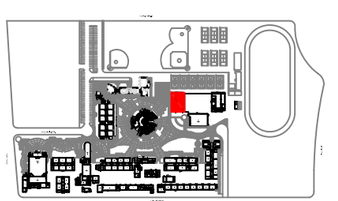

EASYNETWORKS CABLING
3538 SHELLEY WAY
RIVERSIDE, CA. 92503
OFFICE : 951. 742.8119
FAX : 951.742.8125
ST. LIC. # 936770

PREPARED FOR:
EL MONTE UNION HIGH SCHOOL DISTRICT

SITE:
EL MONTE HIGH SCHOOL

3048 TYLER AVE
EL MONTE, CA 91731

AS-BUILT
PROJECT NO. 5231

REVISIONS:

	DATE:	DESCRIPTION:

DRAWN BY:
GERARDO MORALES


DATE: 10/9/12
SCALE: AS SHOWN
SIZE: 11x17

TITLE:
IDF-L WIRELESS ACCESS POINT PLAN

● PROPERTY OF EASY NETWORKS ●
● FOR USE BY EASY NETWORK ONLY ●

SHEET#:
T14
14 OF 17

EASY NETWORKS - 5231 IDF L, 10/17/2012 4:46:23 PM, Tabloid

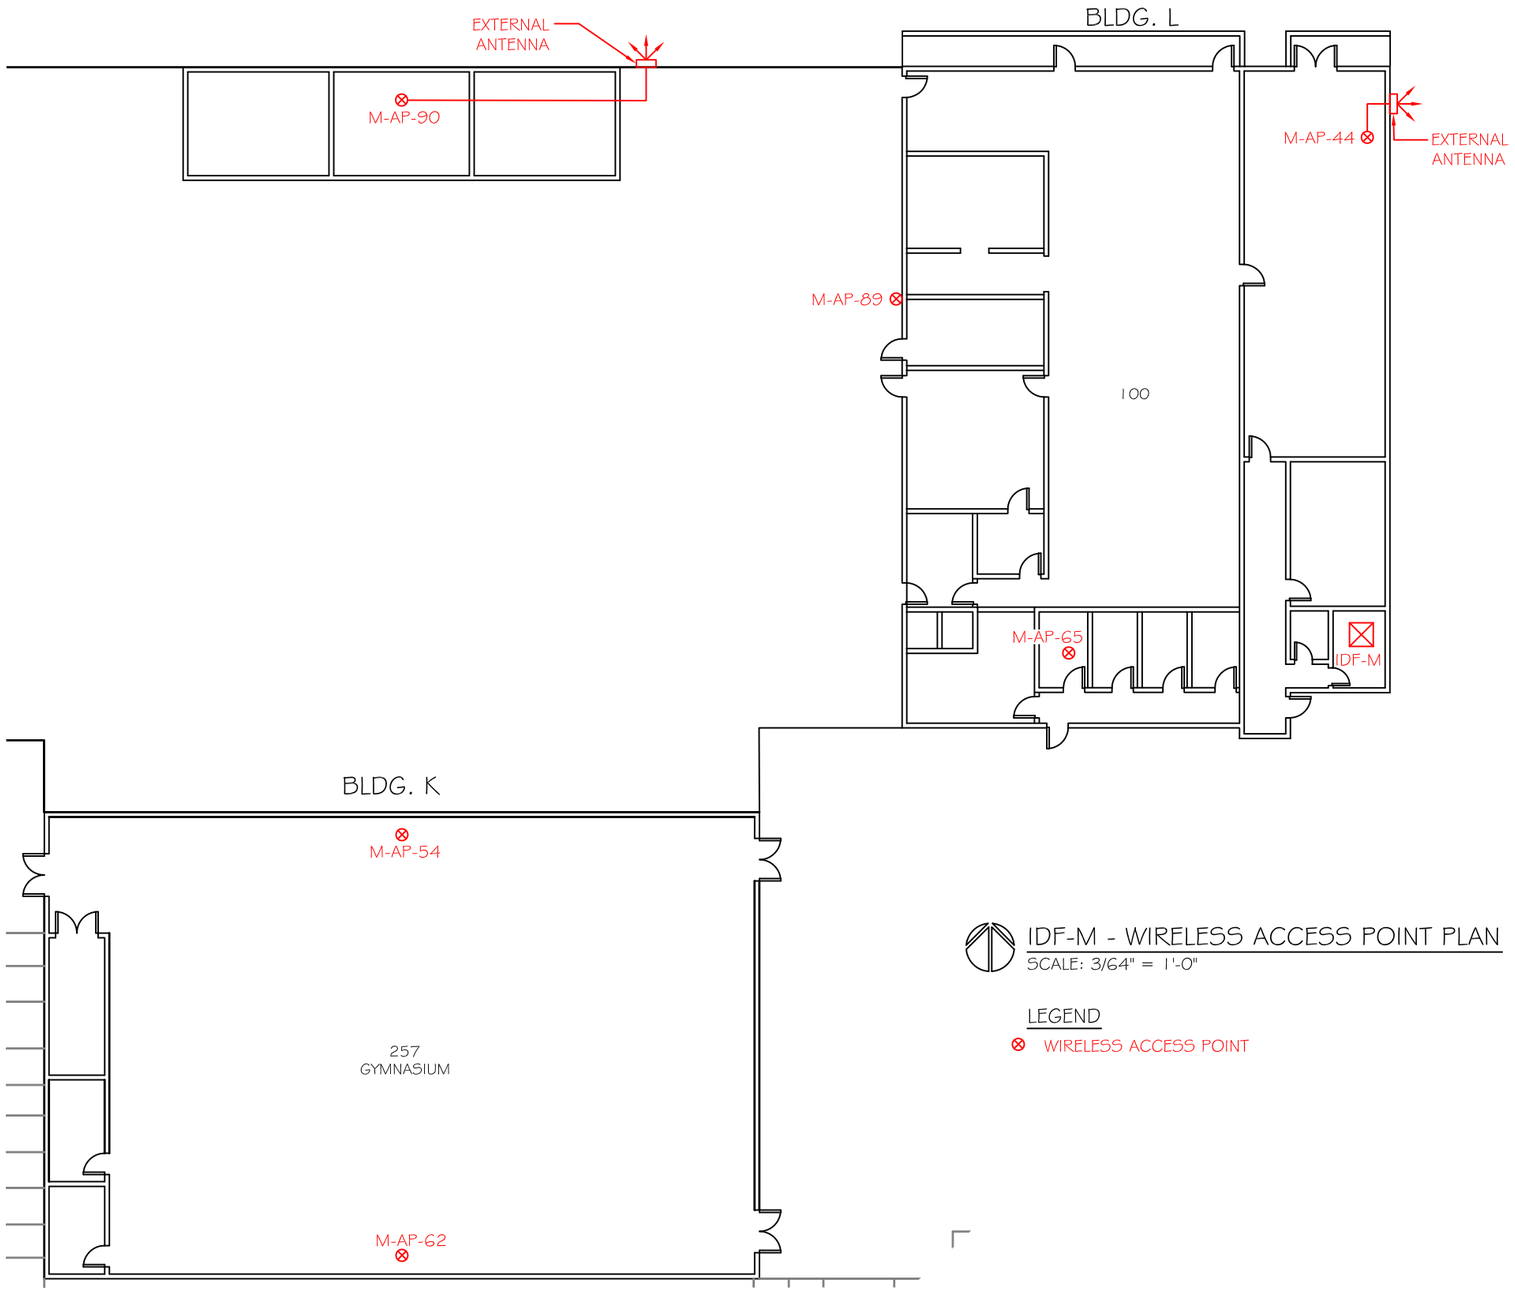


IDF-M - WIRELESS ACCESS POINT PLAN

SCALE: 3/64" = 1'-0"

LEGEND

⊗ WIRELESS ACCESS POINT

KEYMAP
NTS

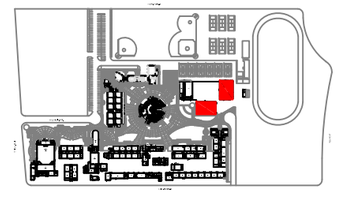

EASYNETWORKS CABLING
3538 SHELLEY WAY
RIVERSIDE, CA. 92503
OFFICE : 951. 742.8119
FAX : 951.742.8125
ST. LIC. # 936770

PREPARED FOR:

EL MONTE UNION HIGH SCHOOL DISTRICT

SITE:

EL MONTE HIGH SCHOOL

3048 TYLER AVE
EL MONTE, CA 91731

AS-BUILT
PROJECT NO. 5231

REVISIONS:

	DATE:	DESCRIPTION:
1		

DRAWN BY:
GERARDO MORALES

DATE: 10/9/12
SCALE: AS SHOWN
SIZE: 11x17

TITLE:

IDF-M WIRELESS ACCESS POINT PLAN

● PROPERTY OF EASY NETWORKS ●
● FOR USE BY EASY NETWORK ONLY ●


SHEET#:

T15

15 OF 17

EASY NETWORKS - 5231 IDF M, 10/17/2012 4:46:30 PM, Tabbid

BLDG. C

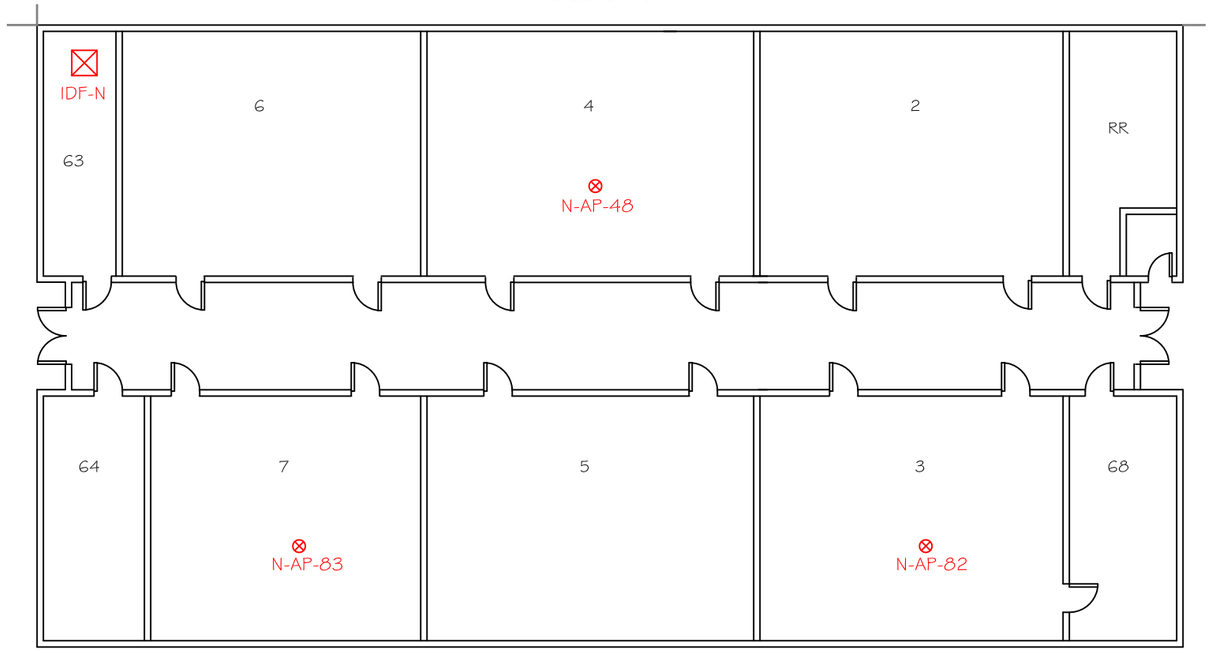


IDF-N - WIRELESS ACCESS POINT PLAN
SCALE: 1/16" = 1'-0"

LEGEND

⊗ WIRELESS ACCESS POINT

KEYMAP
NTS

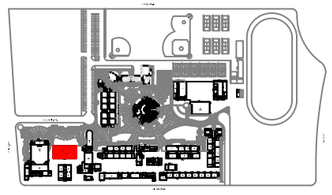

EASYNETWORKS CABLING
3538 SHELLEY WAY
RIVERSIDE, CA. 92503
OFFICE : 951. 742.8119
FAX : 951.742.8125
ST. LIC. # 936770

PREPARED FOR:
EL MONTE UNION HIGH SCHOOL DISTRICT

SITE:
EL MONTE HIGH SCHOOL

3048 TYLER AVE
EL MONTE, CA 91731

AS-BUILT
PROJECT NO. 5231

REVISIONS:

	DATE:	DESCRIPTION:
1		

DRAWN BY: GERARDO MORALES


DATE: 10/9/12
SCALE: AS SHOWN
SIZE: 11x17

TITLE:
IDF-N WIRELESS ACCESS POINT PLAN

• PROPERTY OF EASY NETWORKS •
• FOR USE BY EASY NETWORK ONLY •

SHEET#:
T16
16 OF 17

EASY NETWORKS - 5231 IDF N, 10/17/2012 4:46:37 PM, Tabloid

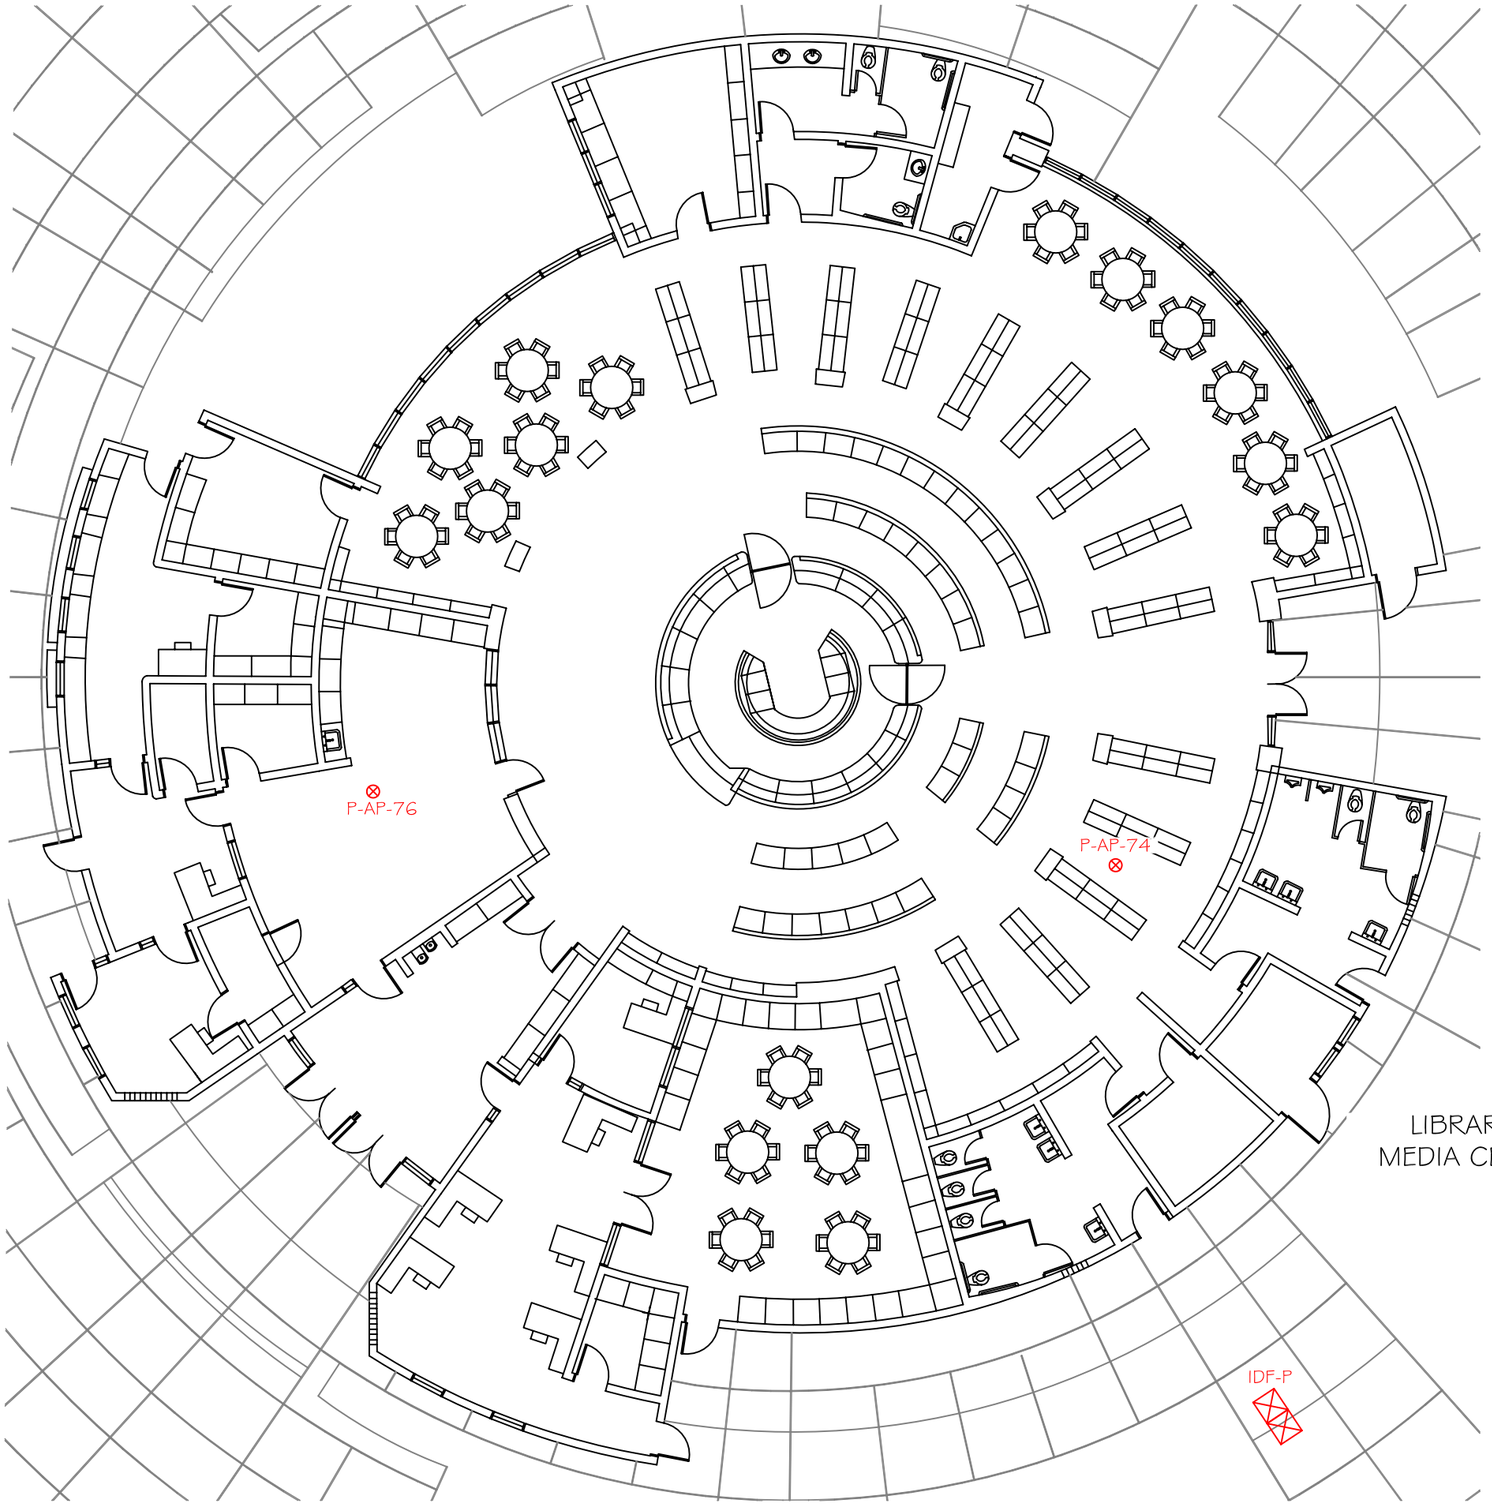


IDF-P - WIRELESS ACCESS POINT PLAN
SCALE: 1/16" = 1'-0"

LEGEND

⊗ WIRELESS ACCESS POINT

KEYMAP
NTS

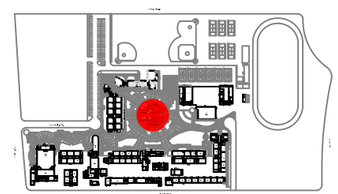

EASYNETWORKS CABLING
3538 SHELLEY WAY
RIVERSIDE, CA. 92503
OFFICE : 951. 742.8119
FAX : 951.742.8125
ST. LIC. # 936770

PREPARED FOR:

EL MONTE UNION HIGH SCHOOL DISTRICT

SITE:

EL MONTE HIGH SCHOOL

3048 TYLER AVE
EL MONTE, CA 91731

AS-BUILT
PROJECT NO. 5231

REVISIONS:

	DATE:	DESCRIPTION:

DRAWN BY:
GERARDO MORALES

DATE: 10/9/12
SCALE: AS SHOWN
SIZE: 11x17

TITLE:

IDF-P WIRELESS ACCESS POINT PLAN

• PROPERTY OF EASY NETWORKS •
• FOR USE BY EASY NETWORK ONLY •


SHEET#:

T17

17 OF 17

EASY NETWORKS - 5231 IDF N (2), 10/17/2012 4:46:45 PM, Tabloid

WIRELESS ACCESS POINT SCHEDULE			
AP #	**Mac Address**	**Asset Tag**	**LOCATION**
FRL-C.AP_20	002368930B00	36193	Room9_2nd_Floor_BldgF
FRL-D.AP_21	0023689310AC	36195	Room11_BldgD
FRL-C.AP_23	002368930B88	36185	Room7_BldgF
FRL-C.AP_26	002368931414	36197	Social_Science_Bldg_D
FRL-MDF.AP_27	002368461EF8	36190	Room1B_BldgB
FRL-D.AP_30	002368930D18	36143	Room14_BldgD
FRL-C.AP_32	002368930CC4	36136	Independant_Study_Bldg_D
FRL-B.AP_33	002368930B60	36155	Room3_BdlgD
FRL-E.AP_36	002368930DC8	26129	Room16A

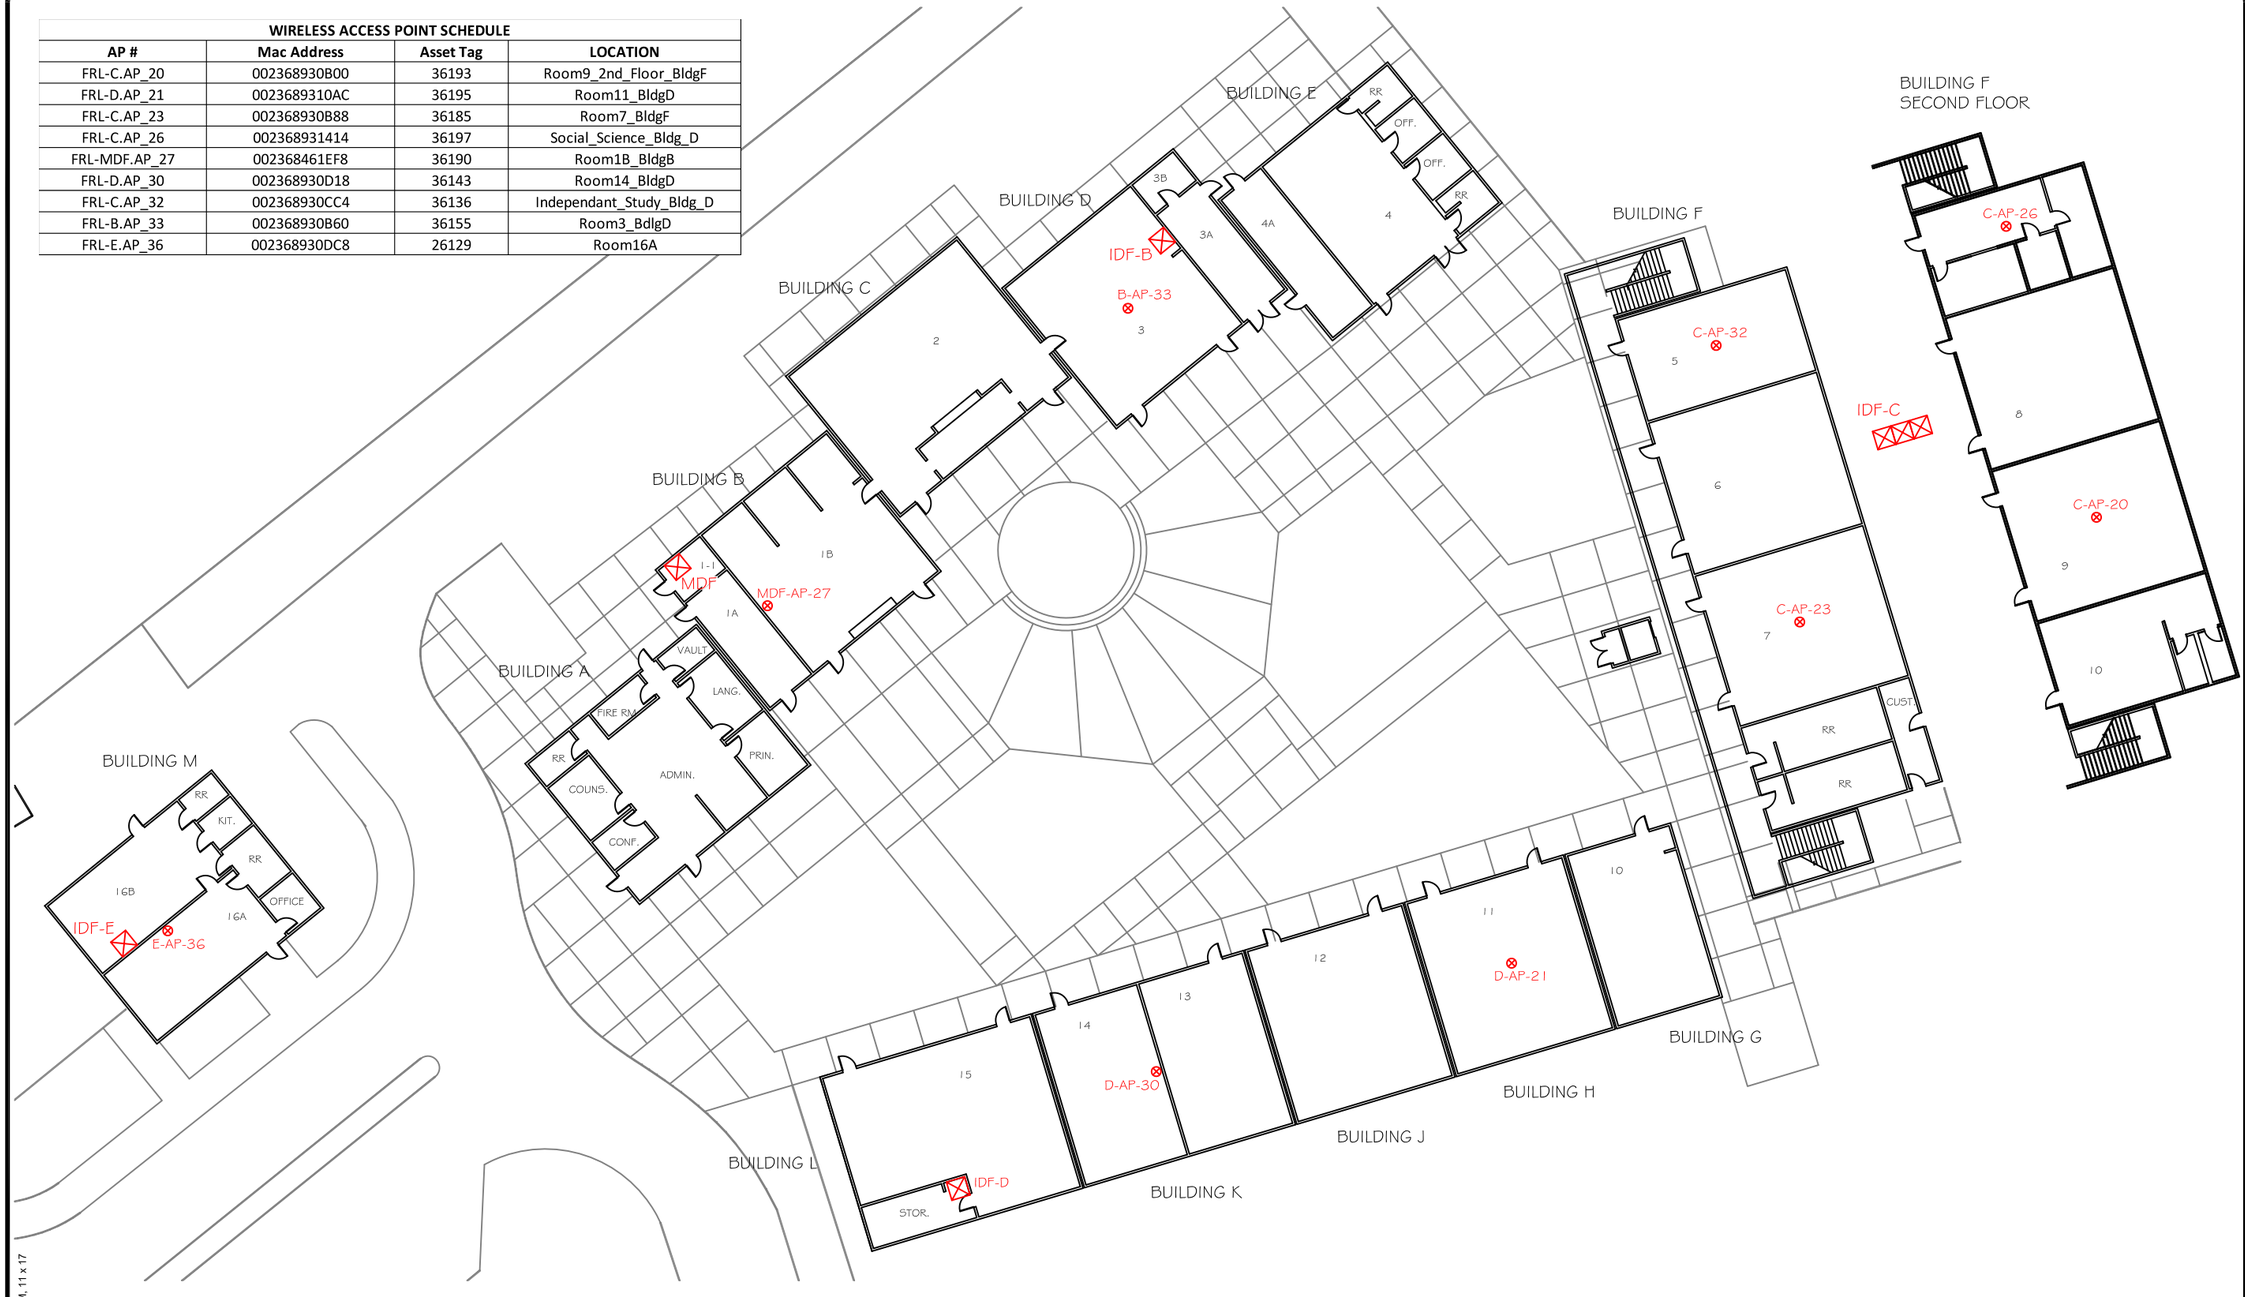

WIRELESS ACCESS POINT PLAN

SCALE: 1/32" = 1' - 0"

LEGEND

⊗ WIRELESS ACCESS POINT

EASYNETWORKS CABLING
3538 SHELLEY WAY
RIVERSIDE, CA. 92503
OFFICE : 951. 742.8119
FAX : 951.742.8125
ST. LIC. # 936770

PREPARED FOR:

EL MONTE UNION HIGH SCHOOL DISTRICT

SITE:

FERNANDO LEDESMA CONTINUATION HIGH SCHOOL

12347 RAMONA BLVD.
EL MONTE, CA 91732

AS-BUILT
PROJECT NO. 5231

REVISIONS:

	DATE:	DESCRIPTION:

DRAWN BY: GERARDO MORALES

DATE: 10/9/12
SCALE: AS SHOWN
SIZE: 11x17


TITLE: **WIRELESS ACCESS POINT PLAN**

● PROPERTY OF EASY NETWORKS ●
●FOR USE BY EASY NETWORK ONLY●

SHEET#: **T1**

1 OF 5

EASY NETWORKS - 5231, 10/17/2012 4:41:46 PM, 11 x 17

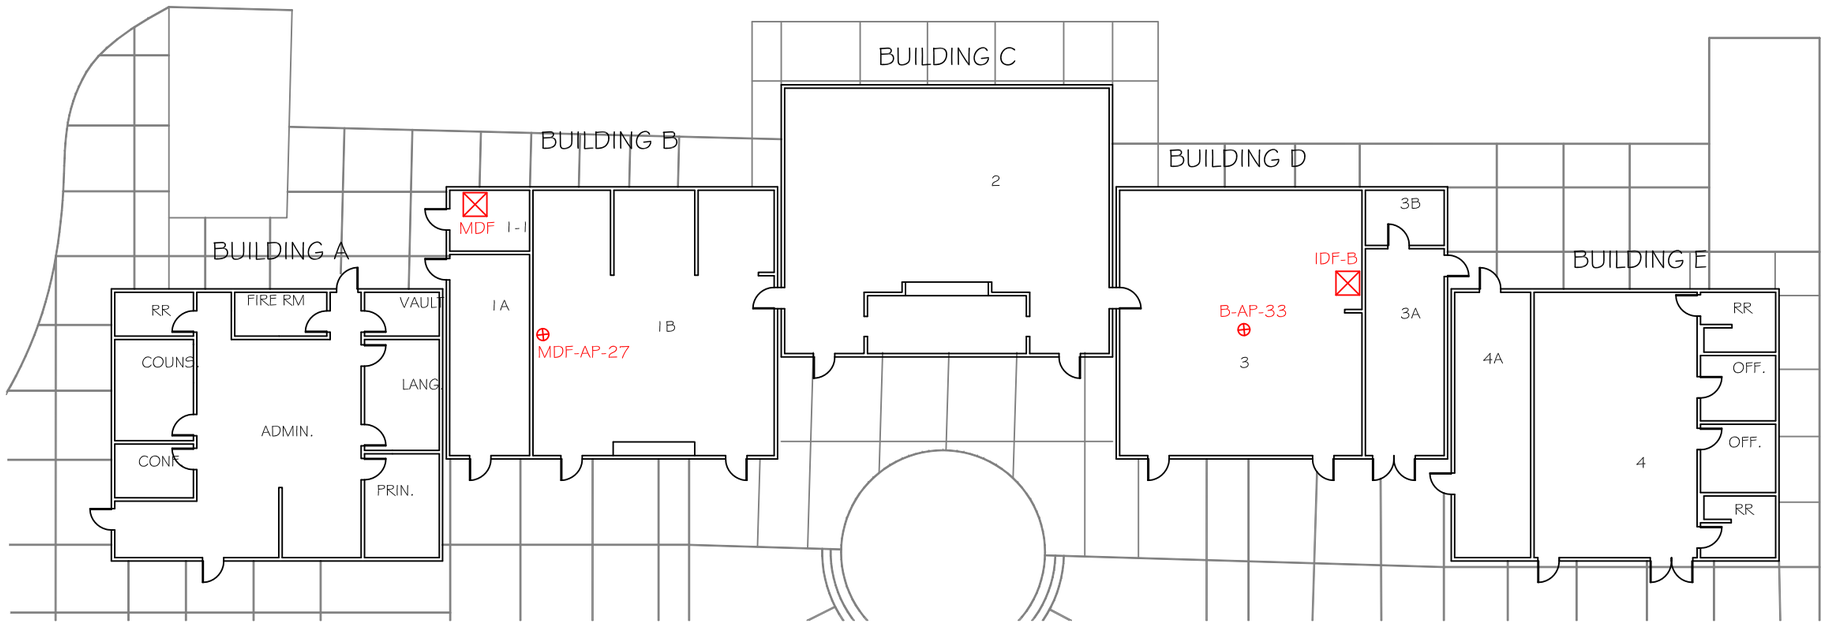


MDF & IDF-B - WIRELESS ACCESS POINT PLAN

SCALE: 3/64" = 1' - 0"

LEGEND

⊗ WIRELESS ACCESS POINT

KEYMAP
NTS

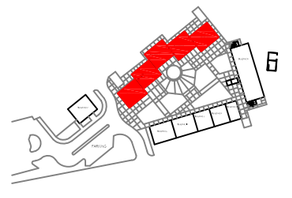

EASYNETWORKS CABLING
3538 SHELLEY WAY
RIVERSIDE, CA. 92503
OFFICE : 951. 742.8119
FAX : 951.742.8125
ST. LIC. # 936770

PREPARED FOR:

EL MONTE UNION HIGH SCHOOL DISTRICT

SITE:

FERNANDO LEDESMA CONTINUATION HIGH SCHOOL

12347 RAMONA BLVD.
EL MONTE, CA 91732

AS-BUILT
PROJECT NO. 5231

REVISIONS:

#	DATE:	DESCRIPTION:

DRAWN BY: GERARDO MORALES

DATE: 10/9/12
SCALE: AS SHOWN
SIZE: 11x17

TITLE:

MDF & IDF-B WIRELESS ACCESS POINT PLAN

• PROPERTY OF EASY NETWORKS •
• FOR USE BY EASY NETWORK ONLY •


SHEET#:

T2


2 OF 5


EASY NETWORKS - 5231 MDF. 10/17/2012 4:42:04 PM. 11 x 17

BUILDING F
2ND FLOOR

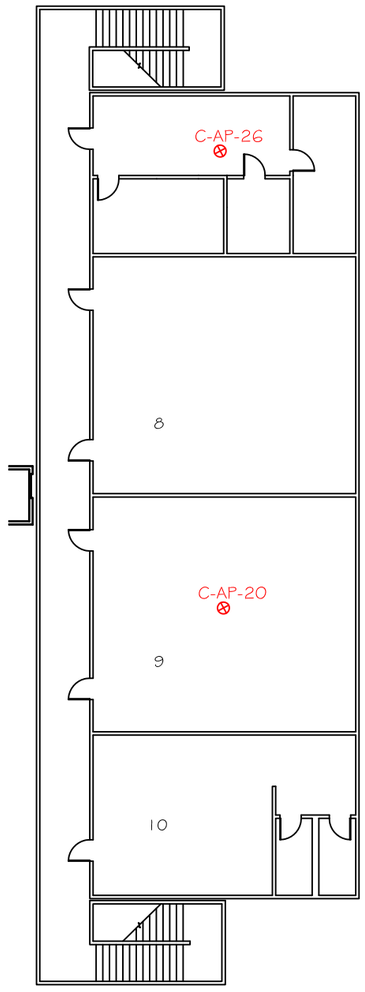

BUILDING F
1ST FLOOR

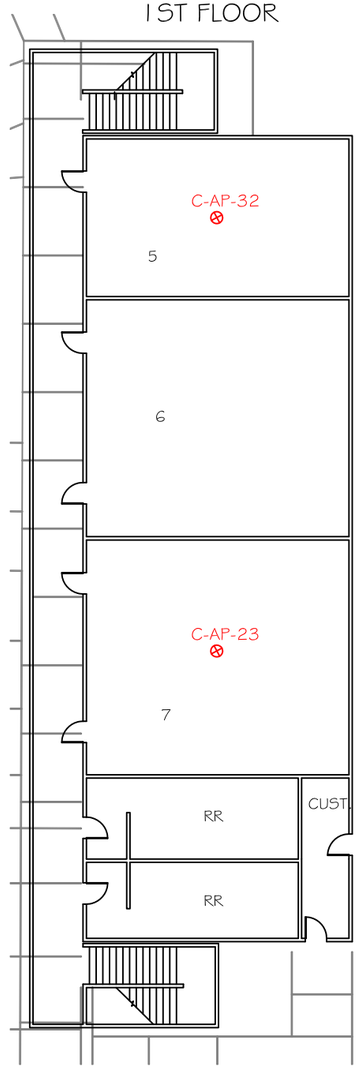

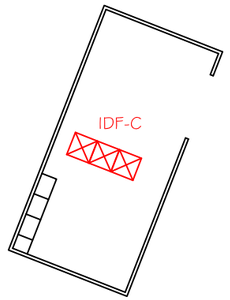


IDF-C - WIRELESS ACCESS POINT PLAN

SCALE: 3/64" = 1' - 0"

LEGEND

⊗ WIRELESS ACCESS POINT

KEYMAP
NTS

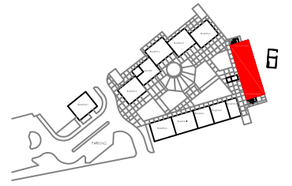

EASYNETWORKS CABLING
3538 SHELLEY WAY
RIVERSIDE, CA. 92503
OFFICE : 951. 742.8119
FAX : 951.742.8125
ST. LIC. # 936770

PREPARED FOR:

EL MONTE UNION HIGH SCHOOL DISTRICT

SITE:

FERNANDO LEDESMA CONTINUATION HIGH SCHOOL

12347 RAMONA BLVD.
EL MONTE, CA 91732

AS-BUILT
PROJECT NO. 5231

REVISIONS:

	DATE:	DESCRIPTION:

DRAWN BY: GERARDO MORALES

DATE: 10/9/12
SCALE: AS SHOWN
SIZE: 11x17

TITLE:

IDF-C WIRELESS ACCESS POINT PLAN


● PROPERTY OF EASY NETWORKS ●
● FOR USE BY EASY NETWORK ONLY ●

SHEET#:

T3

3 OF 5

EASY NETWORKS - 5231 IDF C, 10/17/2012 4:42:13 PM, 11 x 17

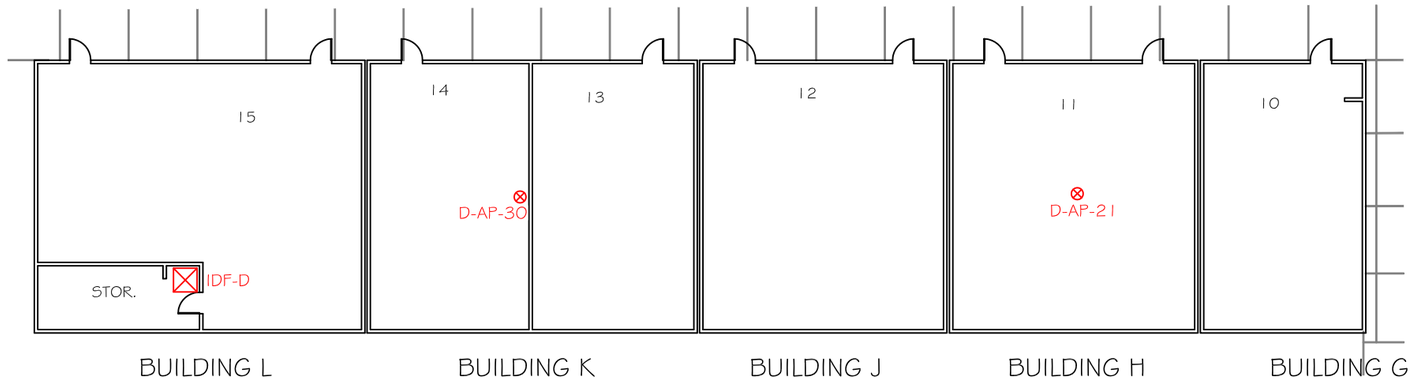


IDF-D - WIRELESS ACCESS POINT PLAN

SCALE: 3/64" = 1' - 0"

LEGEND

⊗ WIRELESS ACCESS POINT

KEYMAP
NTS

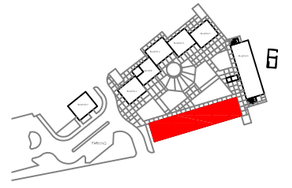

EASYNETWORKS CABLING
3538 SHELLEY WAY
RIVERSIDE, CA. 92503
OFFICE : 951. 742.8119
FAX : 951.742.8125
ST. LIC. # 936770

PREPARED FOR:

EL MONTE UNION HIGH SCHOOL DISTRICT

SITE:

FERNANDO LEDESMA CONTINUATION HIGH SCHOOL

12347 RAMONA BLVD.
EL MONTE, CA 91732

AS-BUILT
PROJECT NO. 5231

REVISIONS:

	DATE:	DESCRIPTION:

DRAWN BY:
GERARDO MORALES

DATE: 10/9/12
SCALE: AS SHOWN
SIZE: 11x17

TITLE:


IDF-D WIRELESS ACCESS POINT PLAN

● PROPERTY OF EASY NETWORKS ●
● FOR USE BY EASY NETWORK ONLY ●

SHEET#:

T4

EASY NETWORKS - 5231 IDF D, 10/17/2012 4:42:20 PM, 11 x 17

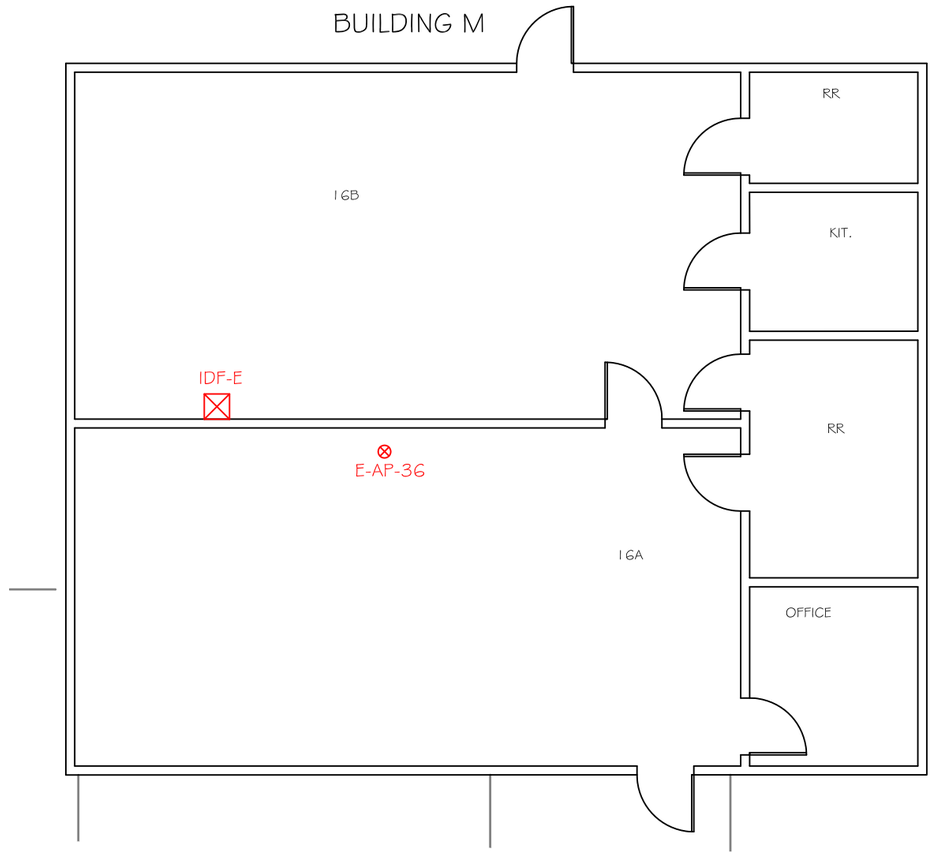


IDF-E - WIRELESS ACCESS POINT PLAN
SCALE: 3/64" = 1' - 0"

LEGEND

⊗ WIRELESS ACCESS POINT

KEYMAP
NTS

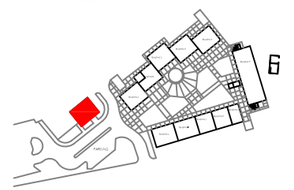

EASYNETWORKS CABLING
3538 SHELLEY WAY
RIVERSIDE, CA. 92503
OFFICE : 951. 742.8119
FAX : 951.742.8125
ST. LIC. # 936770

PREPARED FOR:
EL MONTE UNION HIGH SCHOOL DISTRICT

SITE:
FERNANDO LEDESMA CONTINUATION HIGH SCHOOL

12347 RAMONA BLVD.
EL MONTE, CA 91732

AS-BUILT
PROJECT NO. 5231

REVISIONS:

	DATE:	DESCRIPTION:

DRAWN BY:
GERARDO MORALES

DATE: 10/9/12
SCALE: AS SHOWN
SIZE: 11x17

TITLE:
IDF-E WIRELESS ACCESS POINT PLAN


• PROPERTY OF EASY NETWORKS •
• FOR USE BY EASY NETWORK ONLY •

SHEET#:
T5
5 OF 5

EASY NETWORKS - 5231 IDF D (2), 10/17/2012 4:42:28 PM, 11 x 17

WIRELESS ACCESS POINT SCHEDULE

AP #	Mac Address	Asset Tag	LOCATION
GRA-AP20	002438F2C968	41124	Room_2_MDF
GRA-AP21	002438F2CB88	41123	Room_4_MDF
GRA-AP22	002438F2CA50	41122	Room_6_MDF

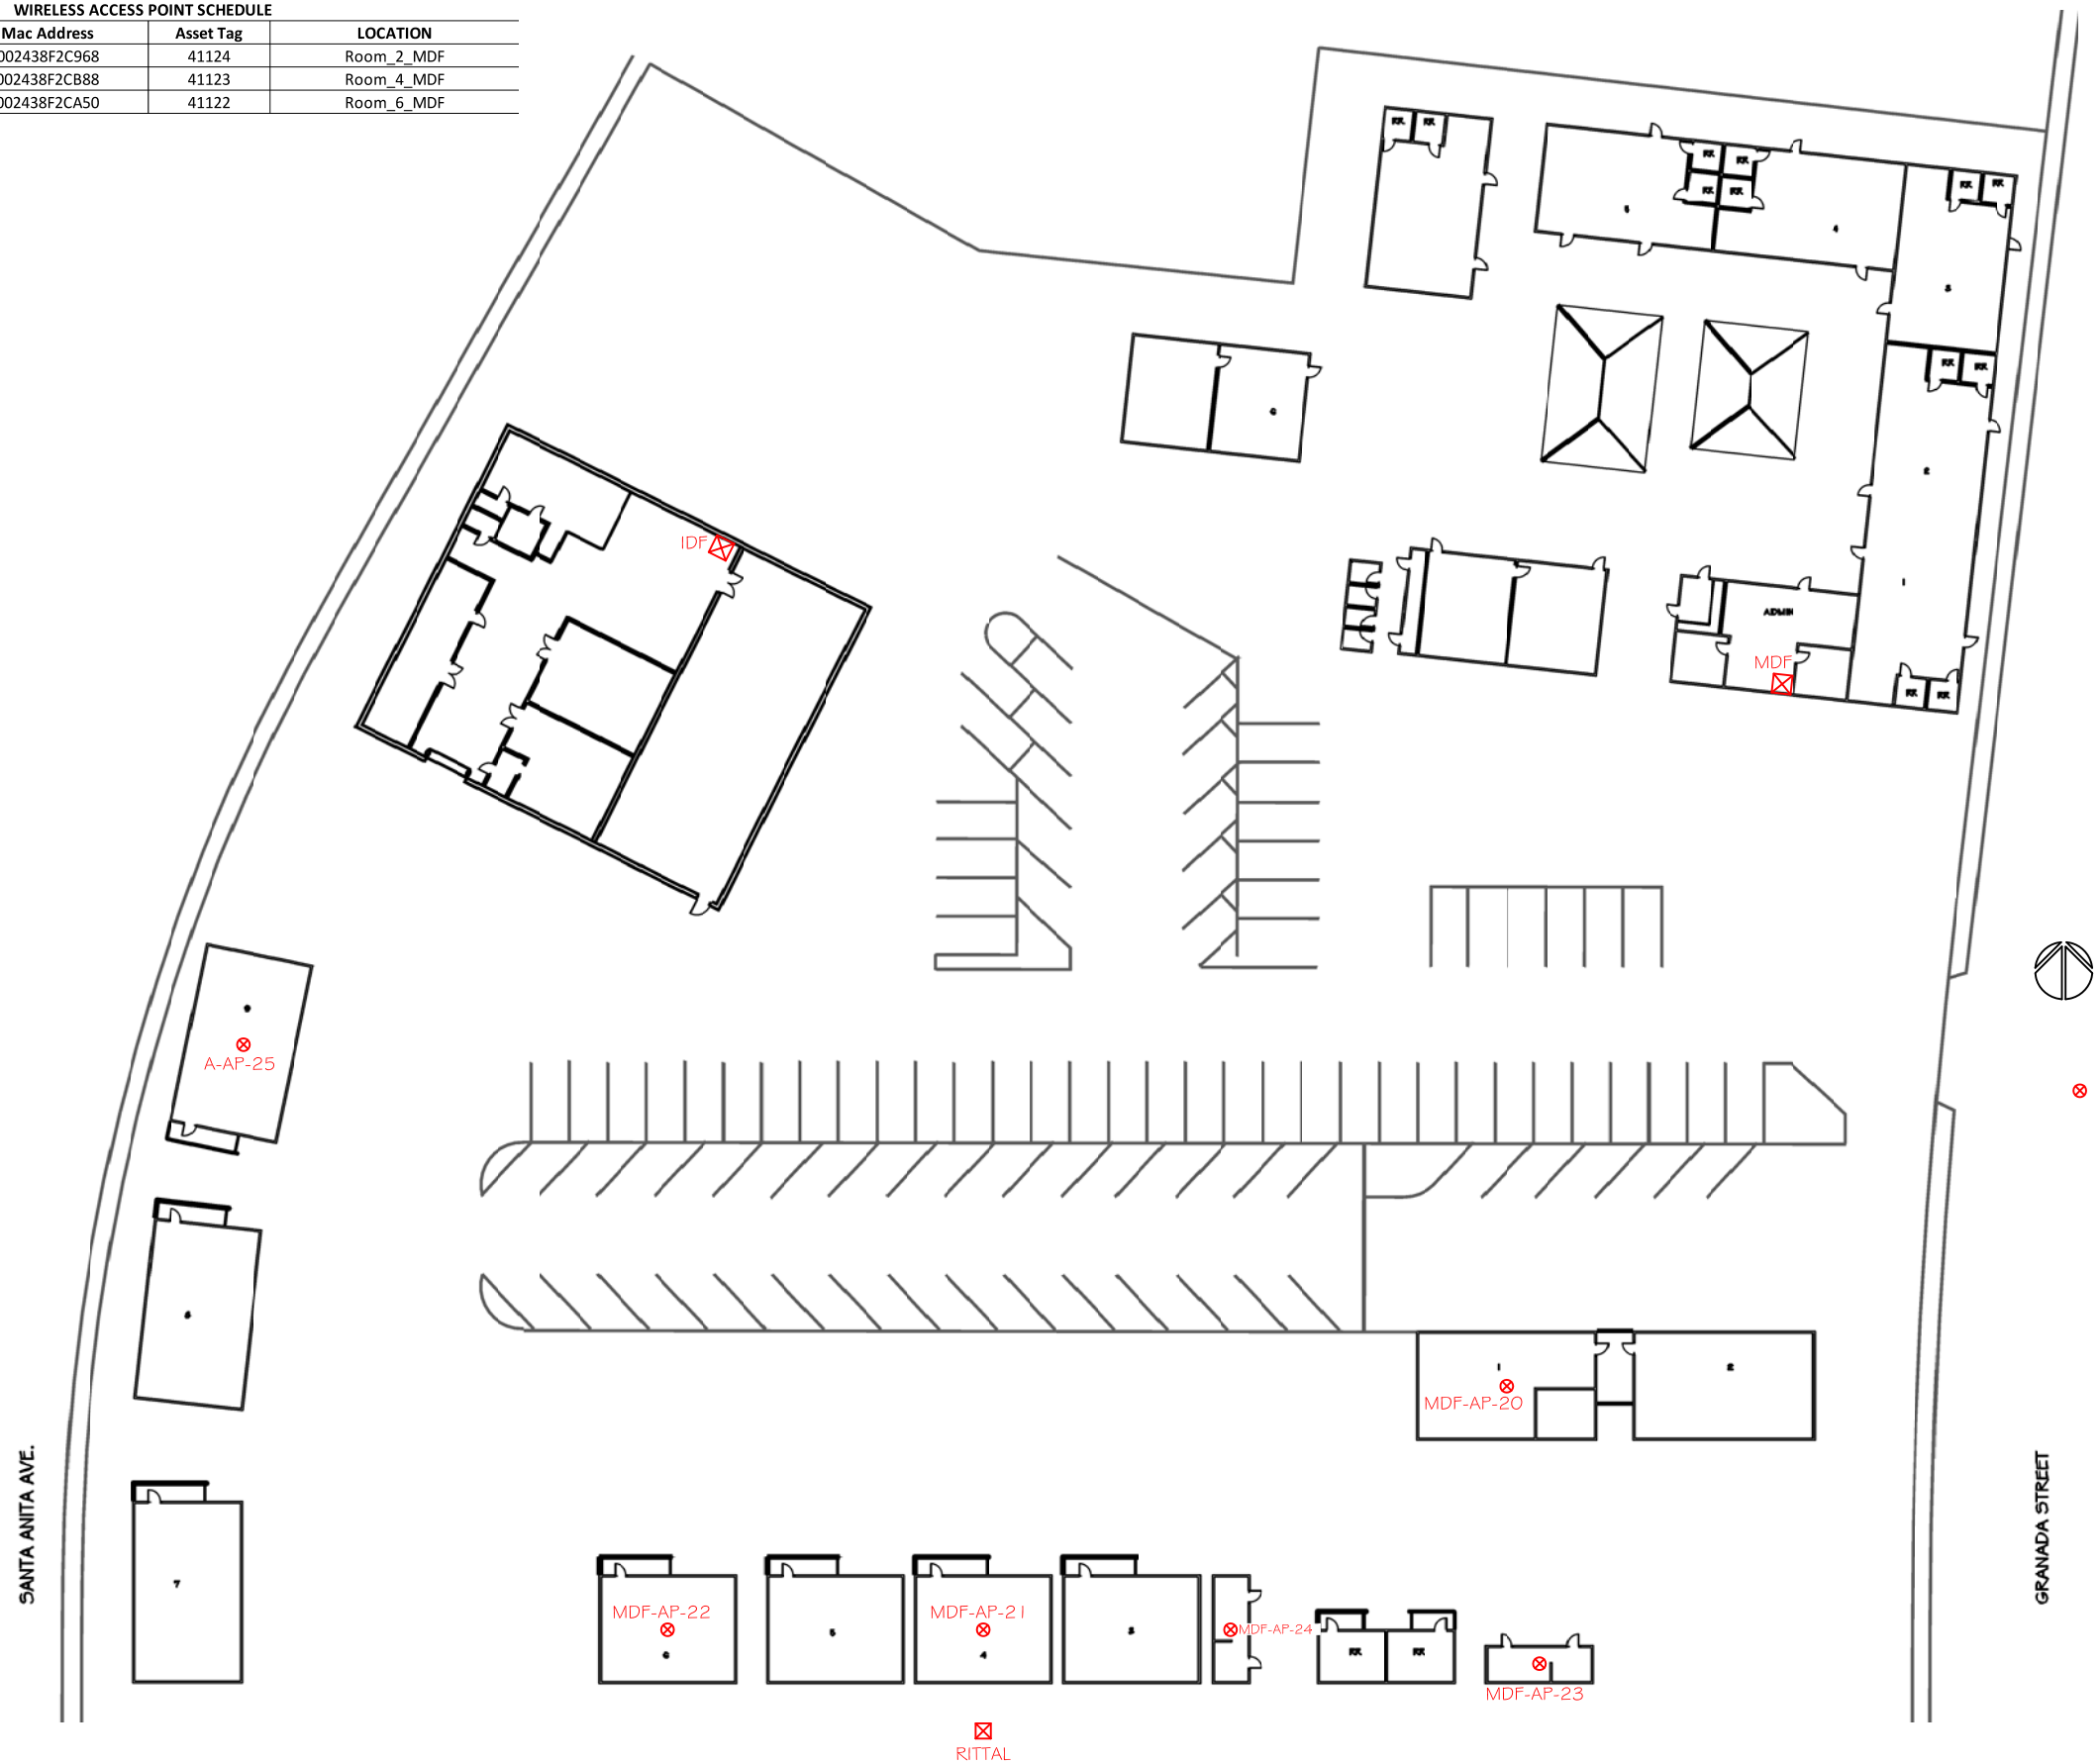

WIRELESS ACCESS POINT PLAN
SCALE: 1" = 50' - 0"

LEGEND

⊗ WIRELESS ACCESS POINT

EASYNETWORKS CABLING
3538 SHELLEY WAY
RIVERSIDE, CA. 92503
OFFICE : 951. 742.8119
FAX : 951.742.8125
ST. LIC. # 936770

PREPARED FOR:

EL MONTE UNION HIGH SCHOOL DISTRICT

SITE:

GRANADA EDUCATION CENTER

3513 GRANADA AVE.
EL MONTE, CA 91731

AS-BUILT
PROJECT NO. 5231

REVISIONS:

#	DATE:	DESCRIPTION:

DRAWN BY: GERARDO MORALES

DATE: 10/25/12
SCALE: AS SHOWN
SIZE: 11x17

TITLE: WIRELESS ACCESS POINT PLAN

● PROPERTY OF EASY NETWORKS ●
● FOR USE BY EASY NETWORK ONLY ●

SHEET#: T1

1 OF 1

EASY NETWORKS - 5231, 10/25/2012 11:51:36 AM, 11 x 17



WIRELESS ACCESS POINT SCHEDULE

AP #	Mac Address	Asset Tag	LOCATION
MVH-L2.AP_20	002368930C0C	36145	Portable384
MVH-R.AP_21	002368930CAC	36146	Portable405
MVH-A.AP_22	0023689307 7C	36055	Administration_Bldg-A
MVH-A.AP_23	002368930C74	36139	TeachersLng_Bldg-A
MVH-M2.AP_24	002368931098	36144	Portable_321
MVH-C1.AP_25	002368930C04	36138	Library_Bldg-C
MVH-C1.AP_26	002368930C98	36122	Library_Bldg-C
MVH-E.AP_27	002368930CA4	36127	Room293_Bldg-F
MVH-E.AP_28	002368461E00	36140	Room291_Bldg-E
MVH-E.AP_29	002368930BA4	36128	Room301_Bldg-F
MVH-E.AP_30	00236893 10D0	36124	Room302_Bldg-F
MVH-G.AP_31	002368930C08	36123	Student_Store_Bldg-G
MVH-G.AP_32	0023688B3F7C	36080	Cafeteria
MVH-G.AP_33	002368930A88	36121	Cafeteria
MVH-G.AP_34	002368930D10	36120	Maintenance_Bldg_G
MVH-G.AP_35	002368930C00	36118	Kitchen
MVH-H.AP_36	002368930BA8	36119	Boys_Locker_Bldg-H
MVH-H.AP_37	0023688B3CE0	36079	Gym_IDF-H
MVH-H.AP_38	002368930A50	36116	Girls_Locker_Bldg-H
MVH-H.AP_39	002368930A38	36115	Gym_Bldg-H
MVH-K.AP_40	002368930B98	36114	Room372_Bldg-K
MVH-K.AP_41	002368930C28	36113	Room371_BLdg-K
MVH-K.AP_42	002368930784	36112	Room376_Bldg_K
MVH-K.AP_43	002368930C48	36111	Room365_Bldg-K
MVH-L1.AP_44	002368930AC8	36182	Room390_Bldg-K
MVH-L1.AP_45	002368930C8C	36137	Room392_Bldg-L
MVH-R_AP_46	002368930918	36181	Portable398
MVH-L2.AP_47	002368930C90	36169	Room401_Bldg-L
MVH-L2.AP_48	002368931100	36174	Autoshop_Bldg-L
MVH-M.AP_49	002368930C40	36175	Room502_Bldg-M
MVH-M.AP_50	002368930B08	36176	areer_Center_Bldg-J
MVH-M.AP_51	0023688B399C	36077	Career_Center
MVH-M.AP_52	0023689310 3C	36168	RM508_Bldg-M
MVH-M.AP_53	002368930CD0	36179	Room505_Bldg-M
MVH-L1.AP_54	002368930B68	36177	Room395_IDF-L1
MVH-MDF.AP_55	002368930CE8	36178	Room250_Bldg-B
MVH-MDF.AP_56	002368930B6C	36166	RM257_Bldg-B
MVH-MDF.AP_57	002368930B3C	36172	Room255_Bldg-B
MVH-MDF.AP_58	002368930C1C	36171	Room252_Bldg-B
MVH-MDF.AP_59	002368930BD4	36173	Room248_Bldg-B
MVH-C1.AP_60	002368930B64	36200	Room_275_IDF-C1

WIRELESS ACCESS POINT PLAN
SCALE: 1" = 90'-0"

LEGEND

⊗ WIRELESS ACCESS POINT

EASYNETWORKS CABLING
3538 SHELLEY WAY
RIVERSIDE, CA. 92503
OFFICE : 951. 742.8119
FAX : 951.742.8125
ST. LIC. # 936770

PREPARED FOR:

EL MONTE UNION HIGH SCHOOL DISTRICT

SITE:

MOUNTAIN VIEW HIGH SCHOOL

2900 PARKWAY DRIVE
EL MONTE, CA 91732

AS-BUILT
PROJECT NO. 5231

REVISIONS:

#	DATE:	DESCRIPTION:

DRAWN BY: GERADO MORALES

DATE: 10/9/12
SCALE: AS SHOWN
SIZE: 11x17

TITLE:

WIRELESS ACCESS POINT PLAN


● PROPERTY OF EASY NETWORKS ●
● FOR USE BY EASY NETWORK ONLY ●

SHEET#:

T1

1 OF 12

EASY NETWORKS - 5231, 10/17/2012 4:36:50 PM, 11 x 17

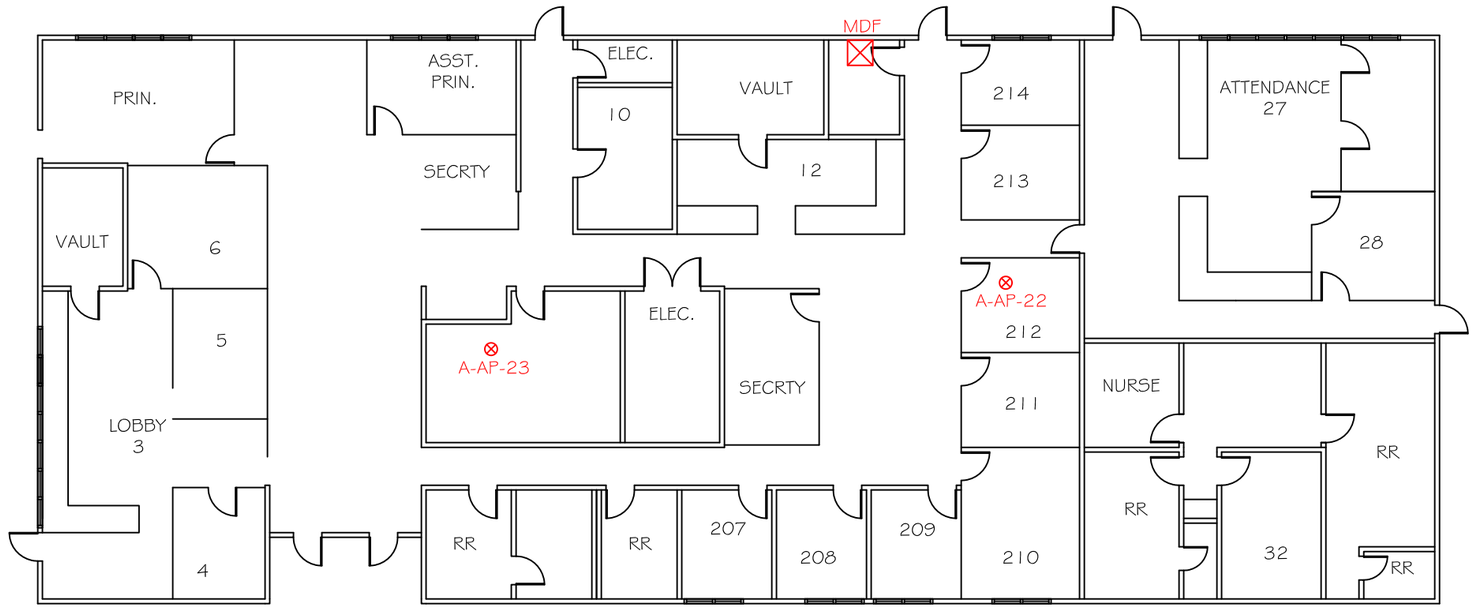

BLDG A

MDF - WIRELESS ACCESS POINT PLAN

SCALE: 1/16" = 1'-0"

LEGEND

⊗ WIRELESS ACCESS POINT

KEYMAP
NTS



EASYNETWORKS CABLING
3538 SHELLEY WAY
RIVERSIDE, CA. 92503
OFFICE : 951. 742.8119
FAX : 951.742.8125
ST. LIC. # 936770

PREPARED FOR:

EL MONTE UNION HIGH SCHOOL DISTRICT

SITE:

MOUNTAIN VIEW HIGH SCHOOL

2900 PARKWAY DRIVE
EL MONTE, CA 91732

AS-BUILT
PROJECT NO. 5231

REVISIONS:

	DATE:	DESCRIPTION:

DRAWN BY:
GERARDO MORALES

DATE: 10/9/12
SCALE: AS SHOWN
SIZE: 11x17

TITLE:

MDF WIRELESS ACCESS POINT PLAN

•PROPERTY OF EASY NETWORKS•
•FOR USE BY EASY NETWORK ONLY•

SHEET#:

T2

EASY NETWORKS - 5231 MDF, 10/17/2012 4:37:20 PM, 11 x 17



IDF-B - WIRELESS ACCESS POINT PLAN

SCALE: 3/64" = 1'-0"

LEGEND

⊗ WIRELESS ACCESS POINT

KEYMAP
NTS



EASYNETWORKS CABLING
3538 SHELLEY WAY
RIVERSIDE, CA. 92503
OFFICE : 951. 742.8119
FAX : 951.742.8125
ST. LIC. # 936770

PREPARED FOR:

EL MONTE UNION HIGH SCHOOL DISTRICT

SITE:

MOUNTAIN VIEW HIGH SCHOOL

2900 PARKWAY DRIVE
EL MONTE, CA 91732

AS-BUILT
PROJECT NO. 5231

REVISIONS:

	DATE:	DESCRIPTION:

DRAWN BY: GERARDO MORALES

DATE: 10/9/12
SCALE: AS SHOWN
SIZE: 11x17

TITLE:

IDF-B WIRELESS ACCESS POINT PLAN

• PROPERTY OF EASY NETWORKS •
• FOR USE BY EASY NETWORK ONLY •

SHEET#:

T3

3 OF 12

EASY NETWORKS - 5231 IDF B, 10/17/2012 4:37:27 PM, 11 x 17



BLDG C

IDF-C - WIRELESS ACCESS POINT PLAN

SCALE: 1/16" = 1'-0"

LEGEND

⊗ WIRELESS ACCESS POINT

KEYMAP
NTS



EASYNETWORKS CABLING
3538 SHELLEY WAY
RIVERSIDE, CA. 92503
OFFICE : 951. 742.8119
FAX : 951.742.8125
ST. LIC. # 936770

PREPARED FOR:

EL MONTE UNION HIGH SCHOOL DISTRICT

SITE:

MOUNTAIN VIEW HIGH SCHOOL

2900 PARKWAY DRIVE
EL MONTE, CA 91732

AS-BUILT
PROJECT NO. 5231

REVISIONS:

	DATE:	DESCRIPTION:

DRAWN BY:
GERARDO MORALES

DATE: 10/9/12
SCALE: AS SHOWN
SIZE: 11x17

TITLE:


IDF-C WIRELESS ACCESS POINT PLAN


•PROPERTY OF EASY NETWORKS•
•FOR USE BY EASY NETWORK ONLY•

SHEET#:

T4

EASY NETWORKS - 5231 IDF C, 10/17/2012 4:37:36 PM, 11 x 17

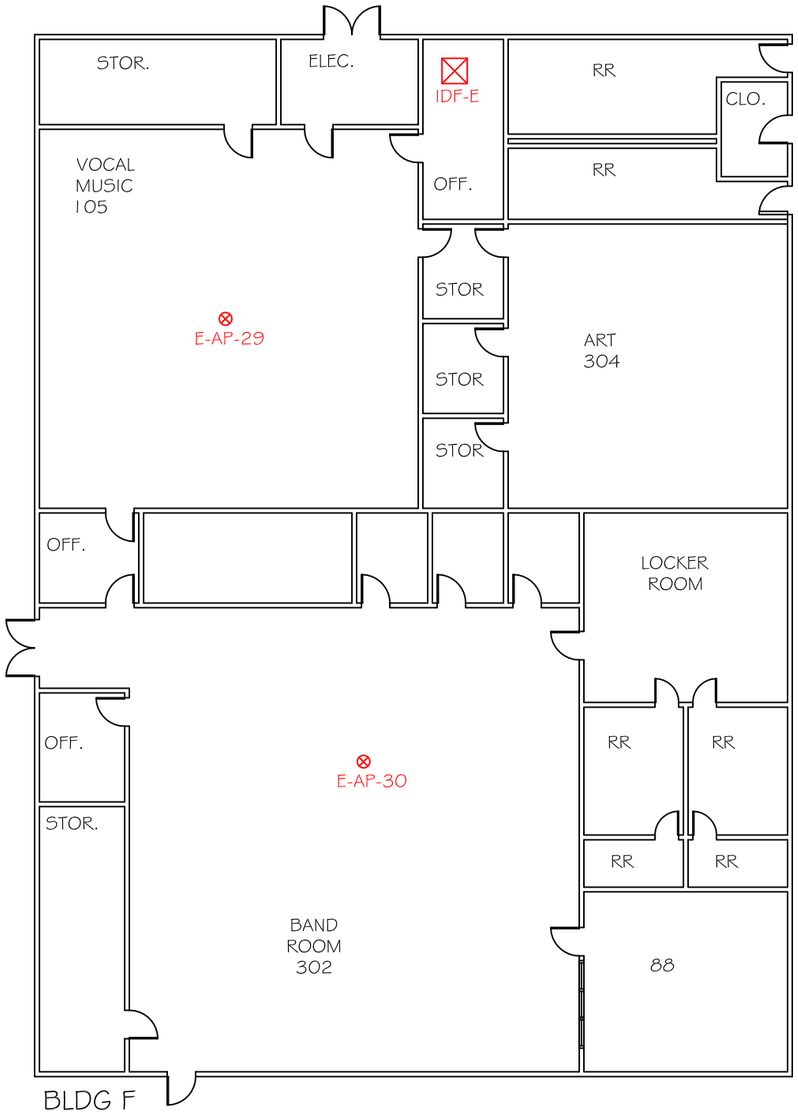

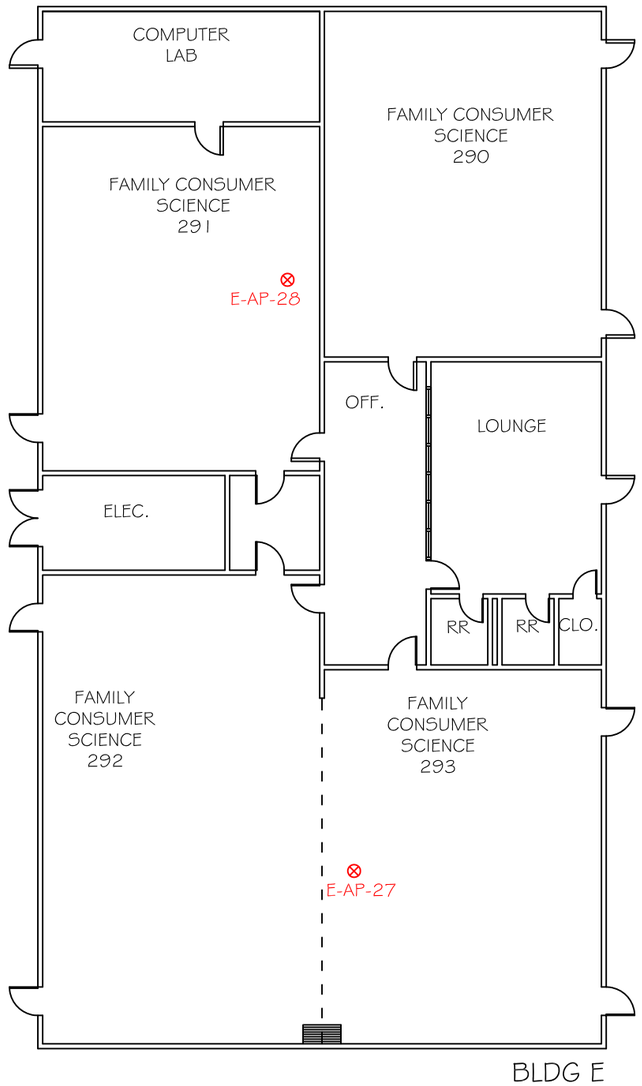

IDF-E - WIRELESS ACCESS POINT PLAN

SCALE: 1/16" = 1'-0"

LEGEND

⊗ WIRELESS ACCESS POINT

KEYMAP
NTS



EASYNETWORKS CABLING
3538 SHELLEY WAY
RIVERSIDE, CA. 92503
OFFICE : 951. 742.8119
FAX : 951.742.8125
ST. LIC. # 936770

PREPARED FOR:

EL MONTE UNION HIGH SCHOOL DISTRICT

SITE:

MOUNTAIN VIEW HIGH SCHOOL

2900 PARKWAY DRIVE
EL MONTE, CA 91732

AS-BUILT
PROJECT NO. 5231

REVISIONS:

#	DATE:	DESCRIPTION:

DRAWN BY:
GERARDO MORALES

DATE: 10/9/12
SCALE: AS SHOWN
SIZE: 11x17

TITLE:

IDF-E WIRELESS ACCESS POINT PLAN


• PROPERTY OF EASY NETWORKS •
• FOR USE BY EASY NETWORK ONLY •

SHEET#:

T5

5 OF 12

EASY NETWORKS - 5231 IDF E, 10/17/2012 4:37:44 PM, 11 x 17

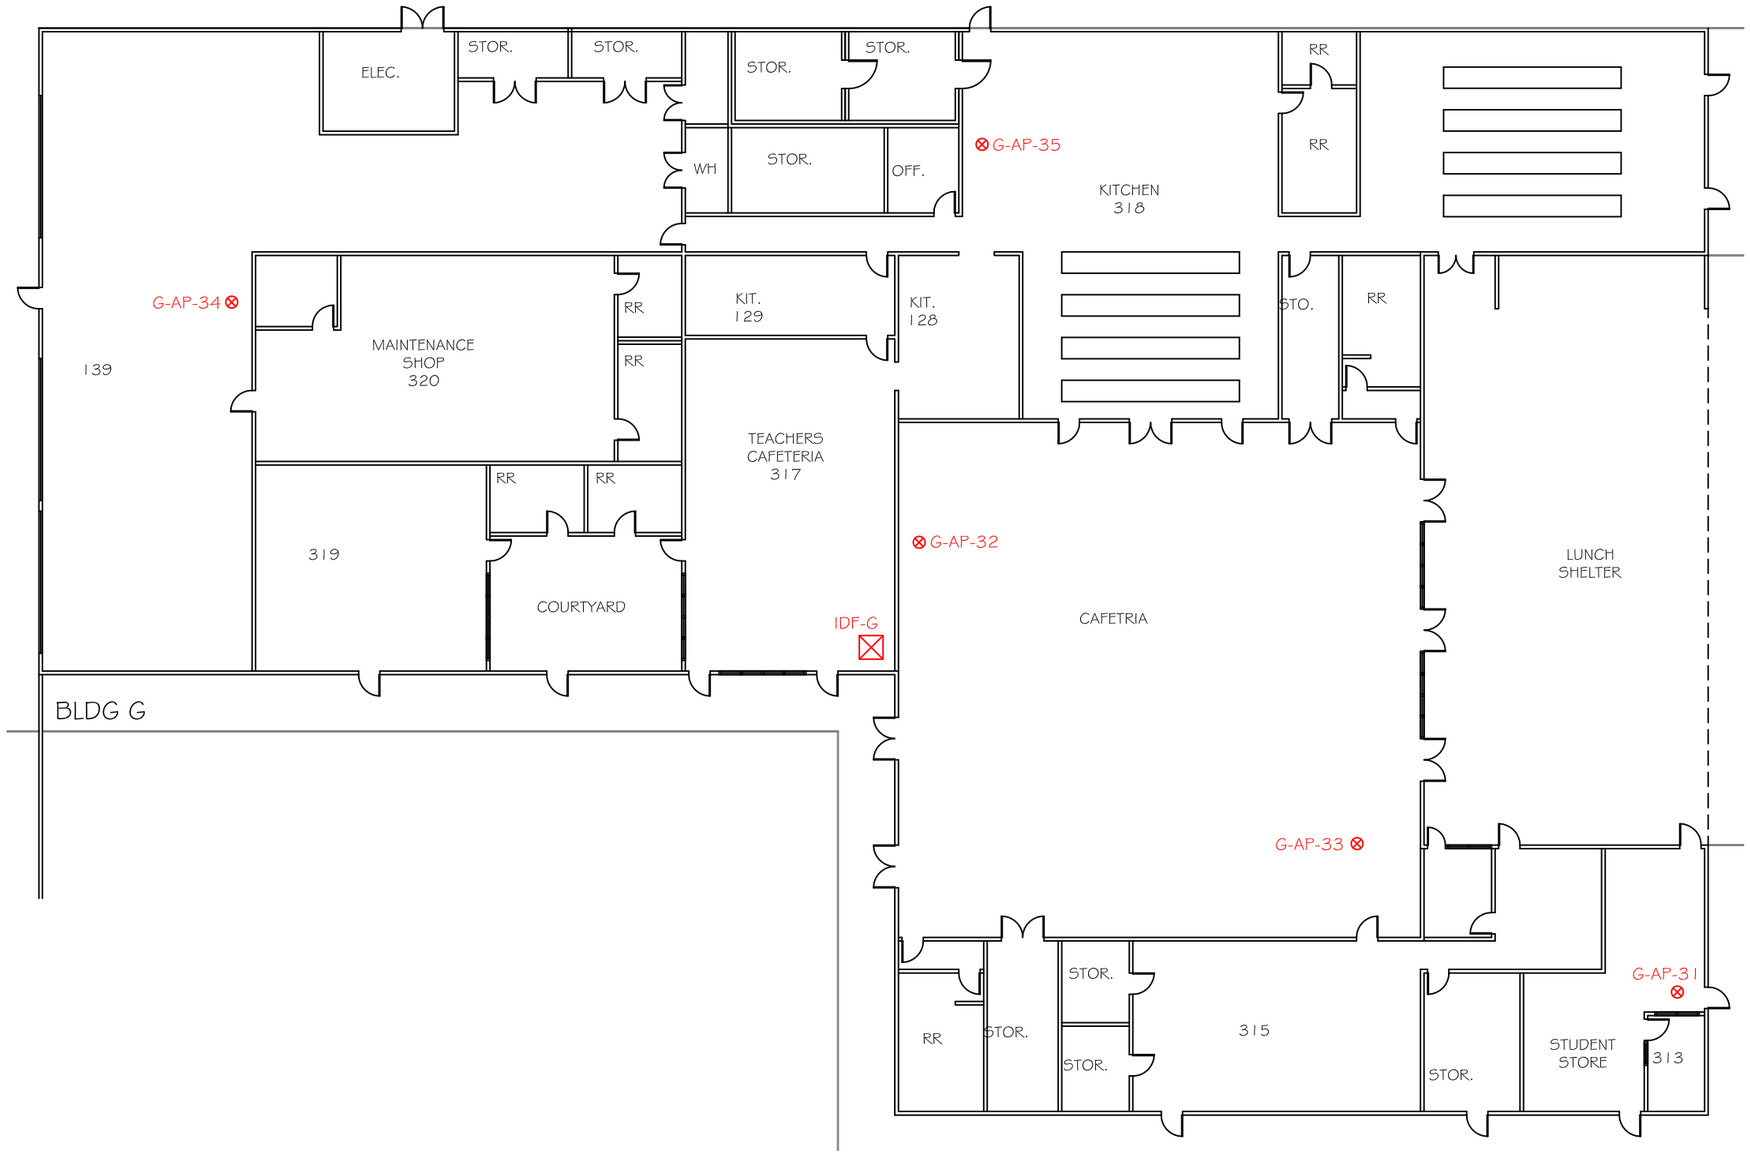

IDF-G - WIRELESS ACCESS POINT PLAN

SCALE: 3/64" = 1'-0"

LEGEND

⊗ WIRELESS ACCESS POINT

KEYMAP
NTS



EASYNETWORKS CABLING
3538 SHELLEY WAY
RIVERSIDE, CA. 92503
OFFICE : 951. 742.8119
FAX : 951.742.8125
ST. LIC. # 936770

PREPARED FOR:

EL MONTE UNION HIGH SCHOOL DISTRICT

SITE:

MOUNTAIN VIEW HIGH SCHOOL

2900 PARKWAY DRIVE
EL MONTE, CA 91732

AS-BUILT
PROJECT NO. 5231

REVISIONS:

	DATE:	DESCRIPTION:

DRAWN BY:
GERARDO MORALES

DATE: 10/9/12
SCALE: AS SHOWN
SIZE: 11x17

TITLE:

IDF-G WIRELESS ACCESS POINT PLAN


•PROPERTY OF EASY NETWORKS•
•FOR USE BY EASY NETWORK ONLY•

SHEET#:

T6

6 OF 12

EASY NETWORKS - 5231 IDF G, 10/17/2012 4:37:52 PM, 11 x 17

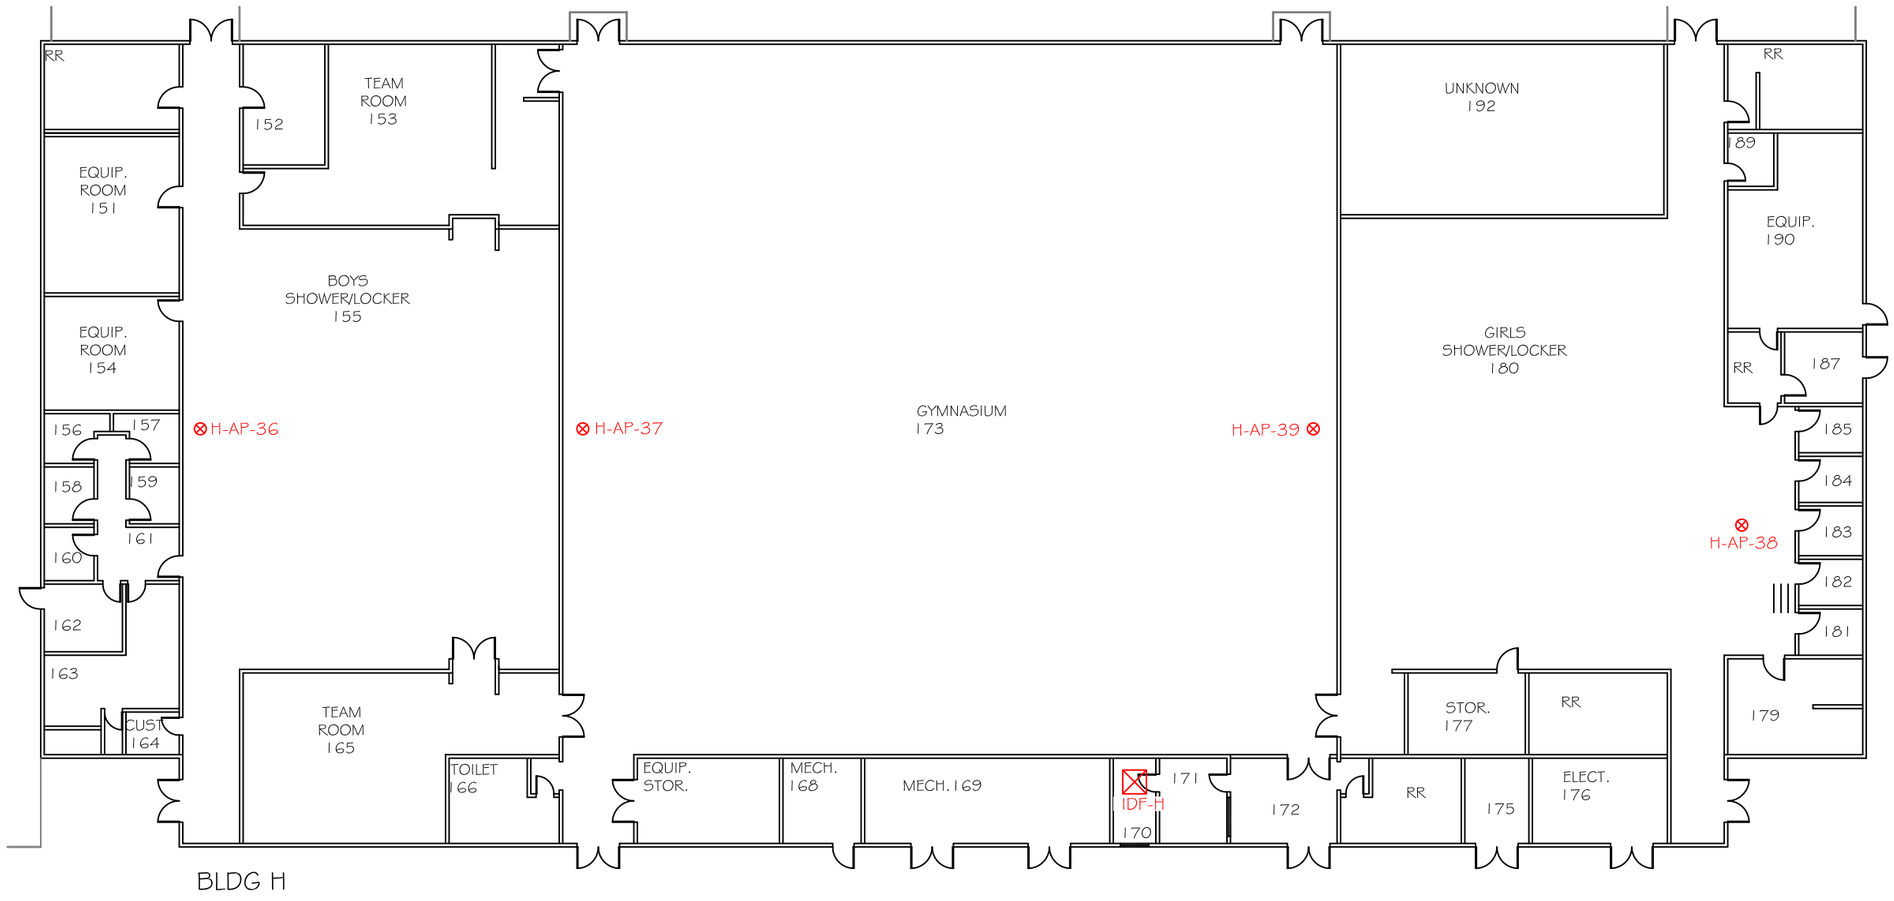

BLDG H

IDF-H - WIRELESS ACCESS POINT PLAN

SCALE: 3/64" = 1'-0"

LEGEND

⊗ WIRELESS ACCESS POINT

KEYMAP
NTS



EASYNETWORKS CABLING
3538 SHELLEY WAY
RIVERSIDE, CA. 92503
OFFICE : 951. 742.8119
FAX : 951.742.8125
ST. LIC. # 936770

PREPARED FOR:

EL MONTE UNION HIGH SCHOOL DISTRICT

SITE:

MOUNTAIN VIEW HIGH SCHOOL

2900 PARKWAY DRIVE
EL MONTE, CA 91732

AS-BUILT
PROJECT NO. 5231

REVISIONS:

#	DATE:	DESCRIPTION:

DRAWN BY: GERARDO MORALES

DATE: 10/9/12
SCALE: AS SHOWN
SIZE: 11x17

TITLE:

IDF-H WIRELESS ACCESS POINT PLAN


• PROPERTY OF EASY NETWORKS •
• FOR USE BY EASY NETWORK ONLY •

SHEET#:

T7

7 OF 12

EASY NETWORKS - 5231 IDF H, 10/17/2012 4:38:02 PM, 11 x 17

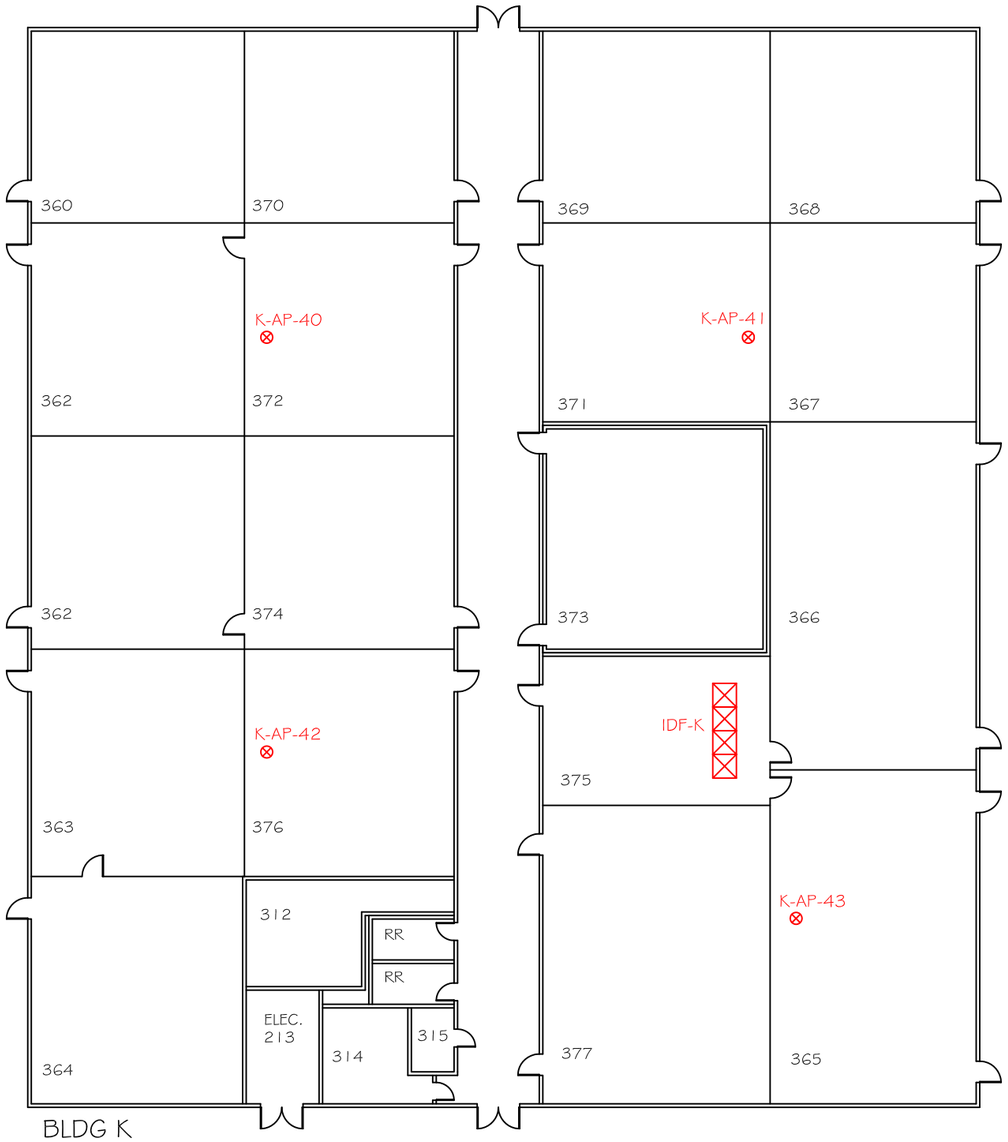

IDF-K - WIRELESS ACCESS POINT PLAN

SCALE: 3/64" = 1'-0"

LEGEND

⊗ WIRELESS ACCESS POINT

KEYMAP
NTS



EASYNETWORKS CABLING
3538 SHELLEY WAY
RIVERSIDE, CA. 92503
OFFICE : 951. 742.8119
FAX : 951.742.8125
ST. LIC. # 936770

PREPARED FOR:

EL MONTE UNION HIGH SCHOOL DISTRICT

SITE:

MOUNTAIN VIEW HIGH SCHOOL

2900 PARKWAY DRIVE
EL MONTE, CA 91732

AS-BUILT
PROJECT NO. 5231

REVISIONS:

#	DATE:	DESCRIPTION:

DRAWN BY: GERARDO MORALES

DATE: 10/9/12
SCALE: AS SHOWN
SIZE: 11x17

TITLE:

IDF-K WIRELESS ACCESS POINT PLAN

• PROPERTY OF EASY NETWORKS •
• FOR USE BY EASY NETWORK ONLY •

SHEET#:

T8

8 OF 12

EASY NETWORKS - 5231 IDF K, 10/17/2012 4:38:16 PM, 11 x 17



IDF-L1 & L2 - WIRELESS ACCESS POINT PLAN

SCALE: 3/64" = 1'-0"

LEGEND

⊗ WIRELESS ACCESS POINT

KEYMAP
NTS



EASYNETWORKS CABLING
3538 SHELLEY WAY
RIVERSIDE, CA. 92503
OFFICE : 951. 742.8119
FAX : 951.742.8125
ST. LIC. # 936770

PREPARED FOR:

EL MONTE UNION HIGH SCHOOL DISTRICT

SITE:

MOUNTAIN VIEW HIGH SCHOOL

2900 PARKWAY DRIVE
EL MONTE, CA 91732

AS-BUILT
PROJECT NO. 5231

REVISIONS:

#	DATE:	DESCRIPTION:

DRAWN BY: GERARDO MORALES

DATE: 10/9/12
SCALE: AS SHOWN
SIZE: 11x17

TITLE:

IDF-L1 & L2 WIRELESS ACCESS POINT PLAN


• PROPERTY OF EASY NETWORKS •
• FOR USE BY EASY NETWORK ONLY •

SHEET#:

T9

9 OF 12

EASY NETWORKS - 5231 IDF L, 10/17/2012 4:38:31 PM, 11 x 17

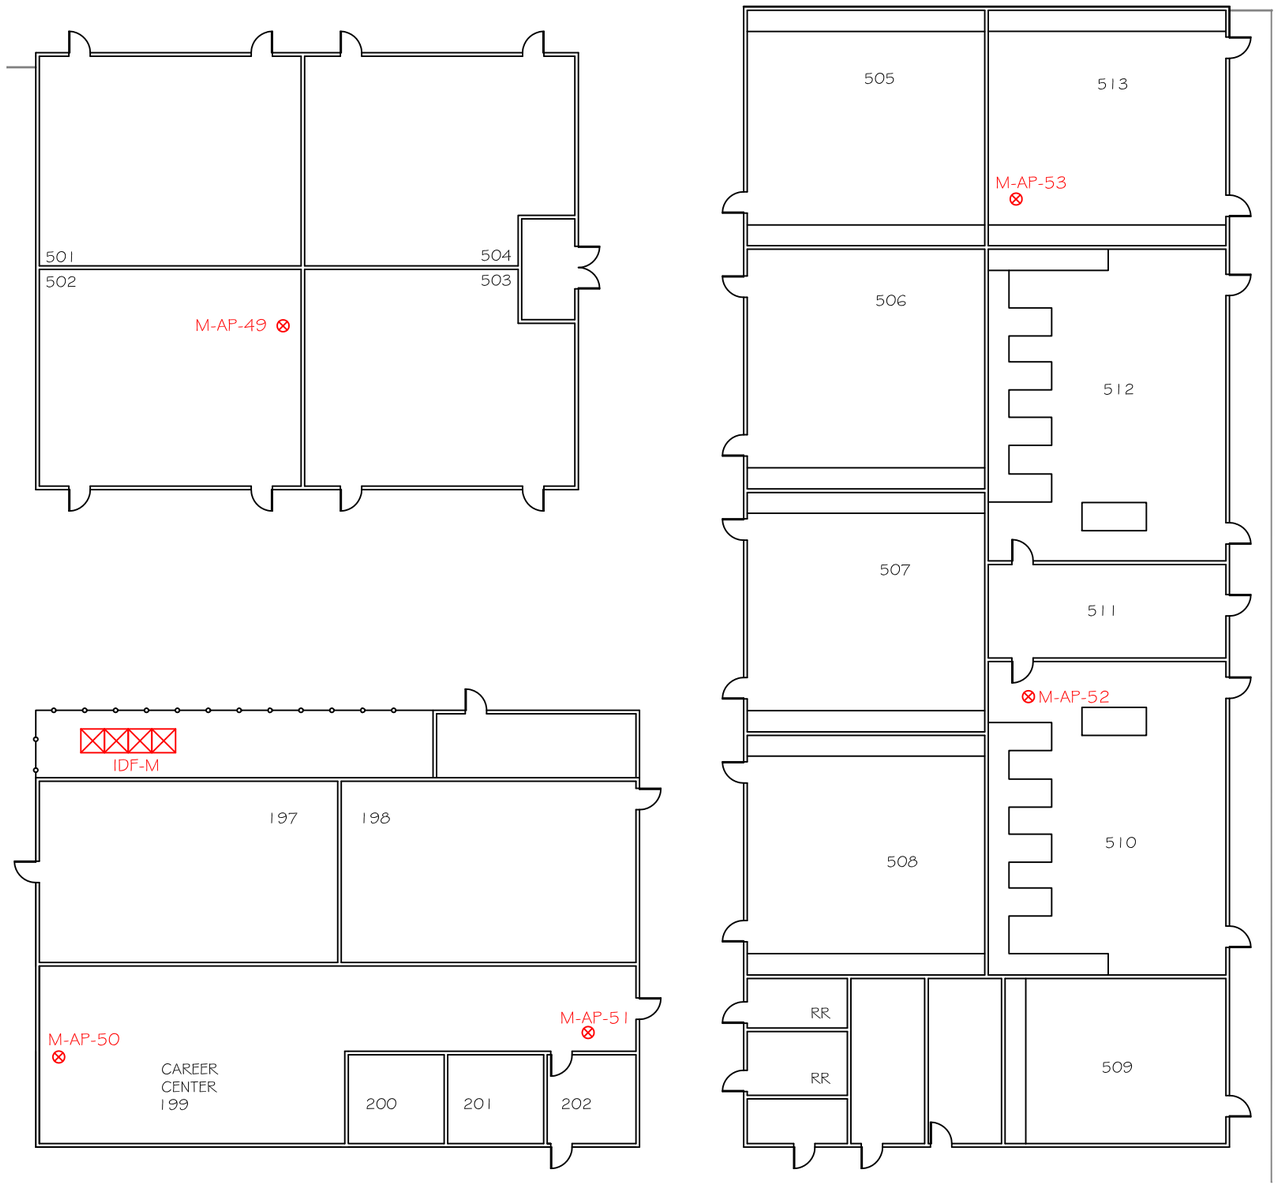

IDF-M - WIRELESS ACCESS POINT PLAN

SCALE: 3/64" = 1'-0"

LEGEND

⊗ WIRELESS ACCESS POINT

KEYMAP
NTS



EASYNETWORKS CABLING

3538 SHELLEY WAY
RIVERSIDE, CA. 92503
OFFICE : 951. 742.8119
FAX : 951.742.8125
ST. LIC. # 936770

PREPARED FOR:

EL MONTE UNION HIGH SCHOOL DISTRICT

SITE:

MOUNTAIN VIEW HIGH SCHOOL

2900 PARKWAY DRIVE
EL MONTE, CA 91732

AS-BUILT
PROJECT NO. 5231

REVISIONS:

	DATE:	DESCRIPTION:

DRAWN BY: GERARDO MORALES

DATE: 10/9/12
SCALE: AS SHOWN
SIZE: 11x17

TITLE:

IDF-M WIRELESS ACCESS POINT PLAN


•PROPERTY OF EASY NETWORKS•
•FOR USE BY EASY NETWORK ONLY•

SHEET#:

T10

10 OF 12

EASY NETWORKS - 5231 IDF M, 10/17/2012 4:38:39 PM, 11 x 17

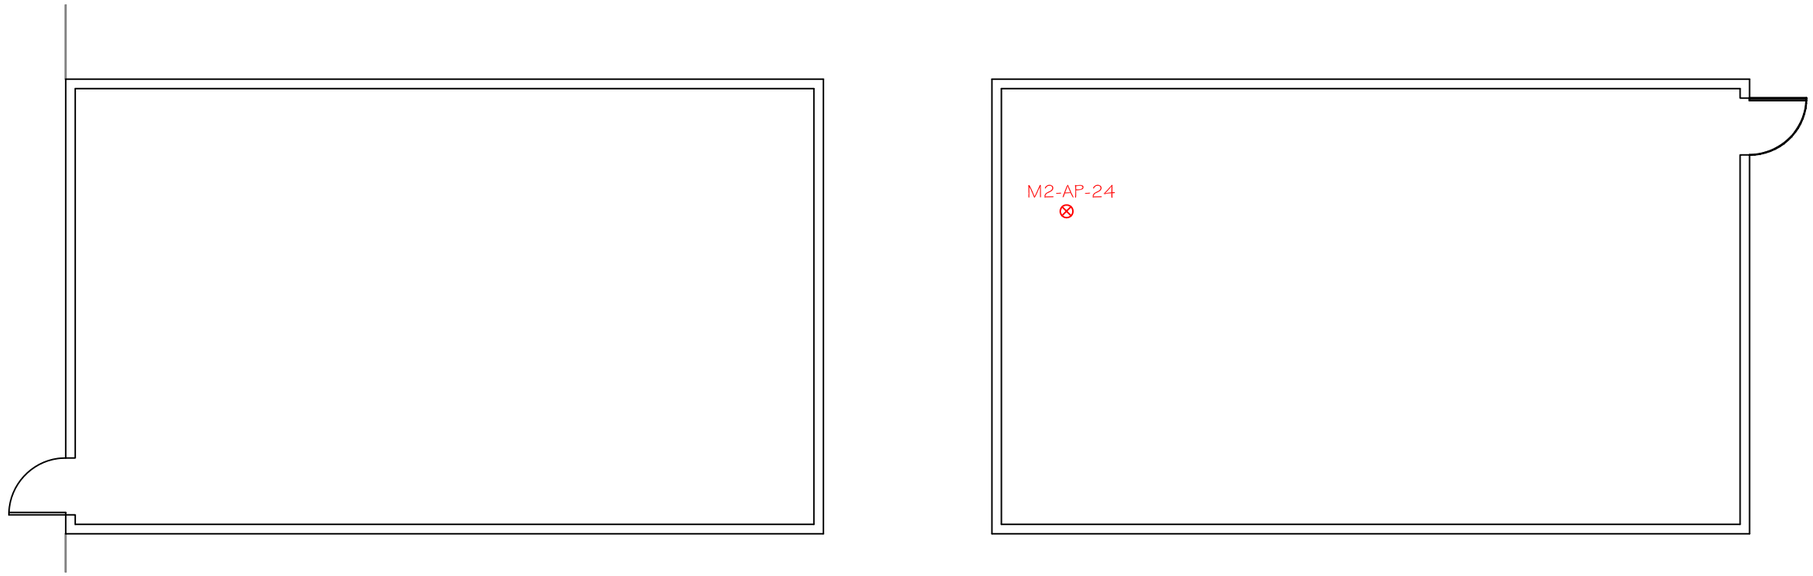

IDF-M2

IDF-M2 - WIRELESS ACCESS POINT PLAN

SCALE: 1/8" = 1'-0"

LEGEND

⊗ WIRELESS ACCESS POINT

KEYMAP
NTS



EASYNETWORKS CABLING
3538 SHELLEY WAY
RIVERSIDE, CA. 92503
OFFICE : 951. 742.8119
FAX : 951.742.8125
ST. LIC. # 936770

PREPARED FOR:

EL MONTE UNION HIGH SCHOOL DISTRICT

SITE:

MOUNTAIN VIEW HIGH SCHOOL

2900 PARKWAY DRIVE
EL MONTE, CA 91732

AS-BUILT
PROJECT NO. 5231

REVISIONS:

	DATE:	DESCRIPTION:
1		

DRAWN BY:
GERARDO MORALES

DATE: 10/9/12
SCALE: AS SHOWN
SIZE: 11x17

TITLE:

IDF-M2 WIRELESS ACCESS POINT PLAN


• PROPERTY OF EASY NETWORKS •
• FOR USE BY EASY NETWORK ONLY •

SHEET#:

T11

11 OF 12

EASY NETWORKS - 5231 IDF M2, 10/17/2012 4:38:48 PM, 11 x 17

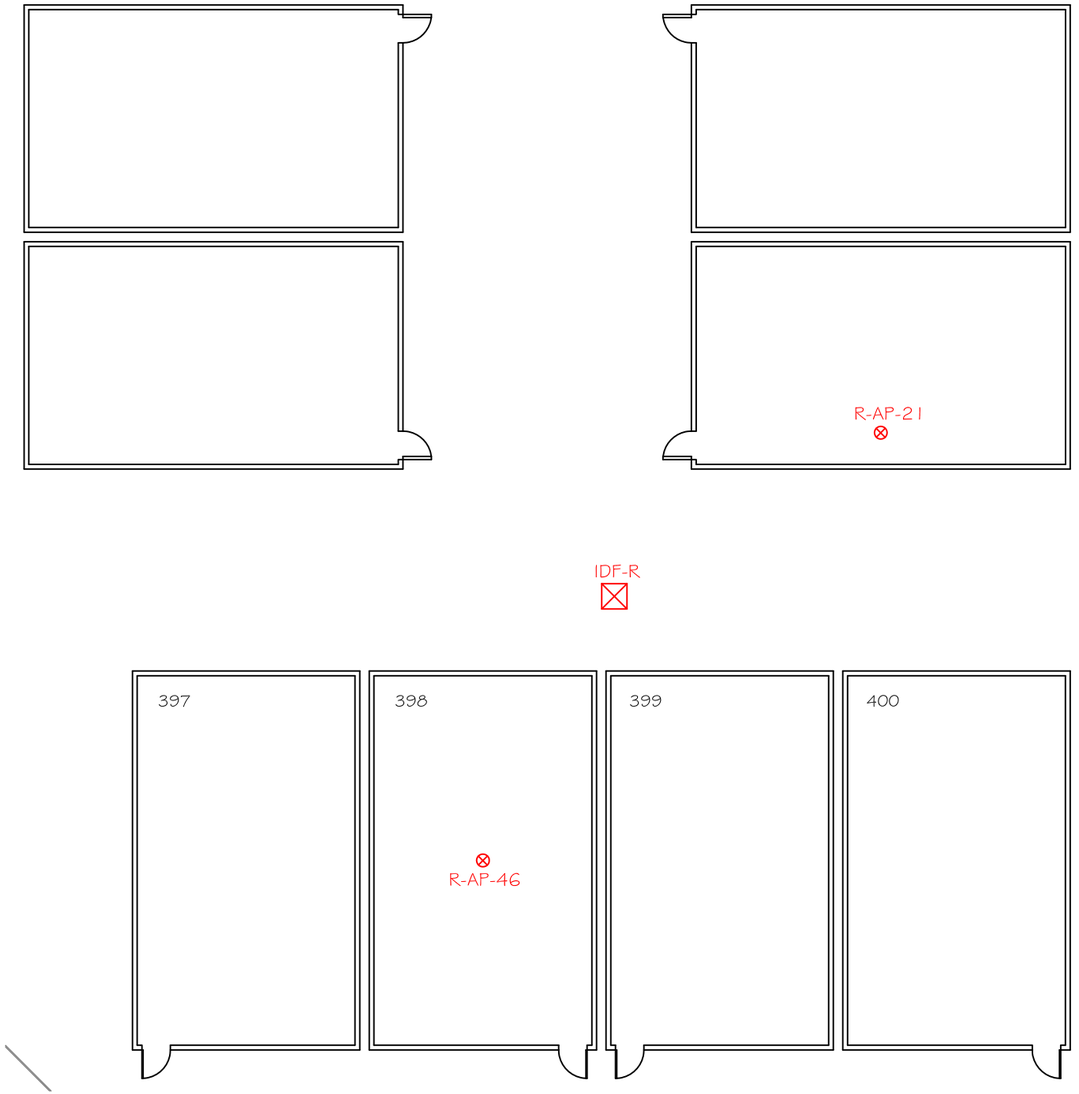

IDF-R - WIRELESS ACCESS POINT PLAN

SCALE: 1/8" = 1'-0"

LEGEND

⊗ WIRELESS ACCESS POINT

KEYMAP
NTS



EASYNETWORKS CABLING

3538 SHELLEY WAY
RIVERSIDE, CA. 92503
OFFICE : 951. 742.8119
FAX : 951.742.8125
ST. LIC. # 936770

PREPARED FOR:

EL MONTE UNION HIGH SCHOOL DISTRICT

SITE:

MOUNTAIN VIEW HIGH SCHOOL

2900 PARKWAY DRIVE
EL MONTE, CA 91732

AS-BUILT
PROJECT NO. 5231

REVISIONS:

	DATE:	DESCRIPTION:

DRAWN BY:
GERARDO MORALES

DATE: 10/9/12
SCALE: AS SHOWN
SIZE: 11x17

TITLE:

IDF-R WIRELESS ACCESS POINT PLAN


● PROPERTY OF EASY NETWORKS ●
● FOR USE BY EASY NETWORK ONLY ●

SHEET#:

T12

12 OF 12

EASY NETWORKS - 5231 IDF R, 10/17/2012 4:38:58 PM, 11 x 17

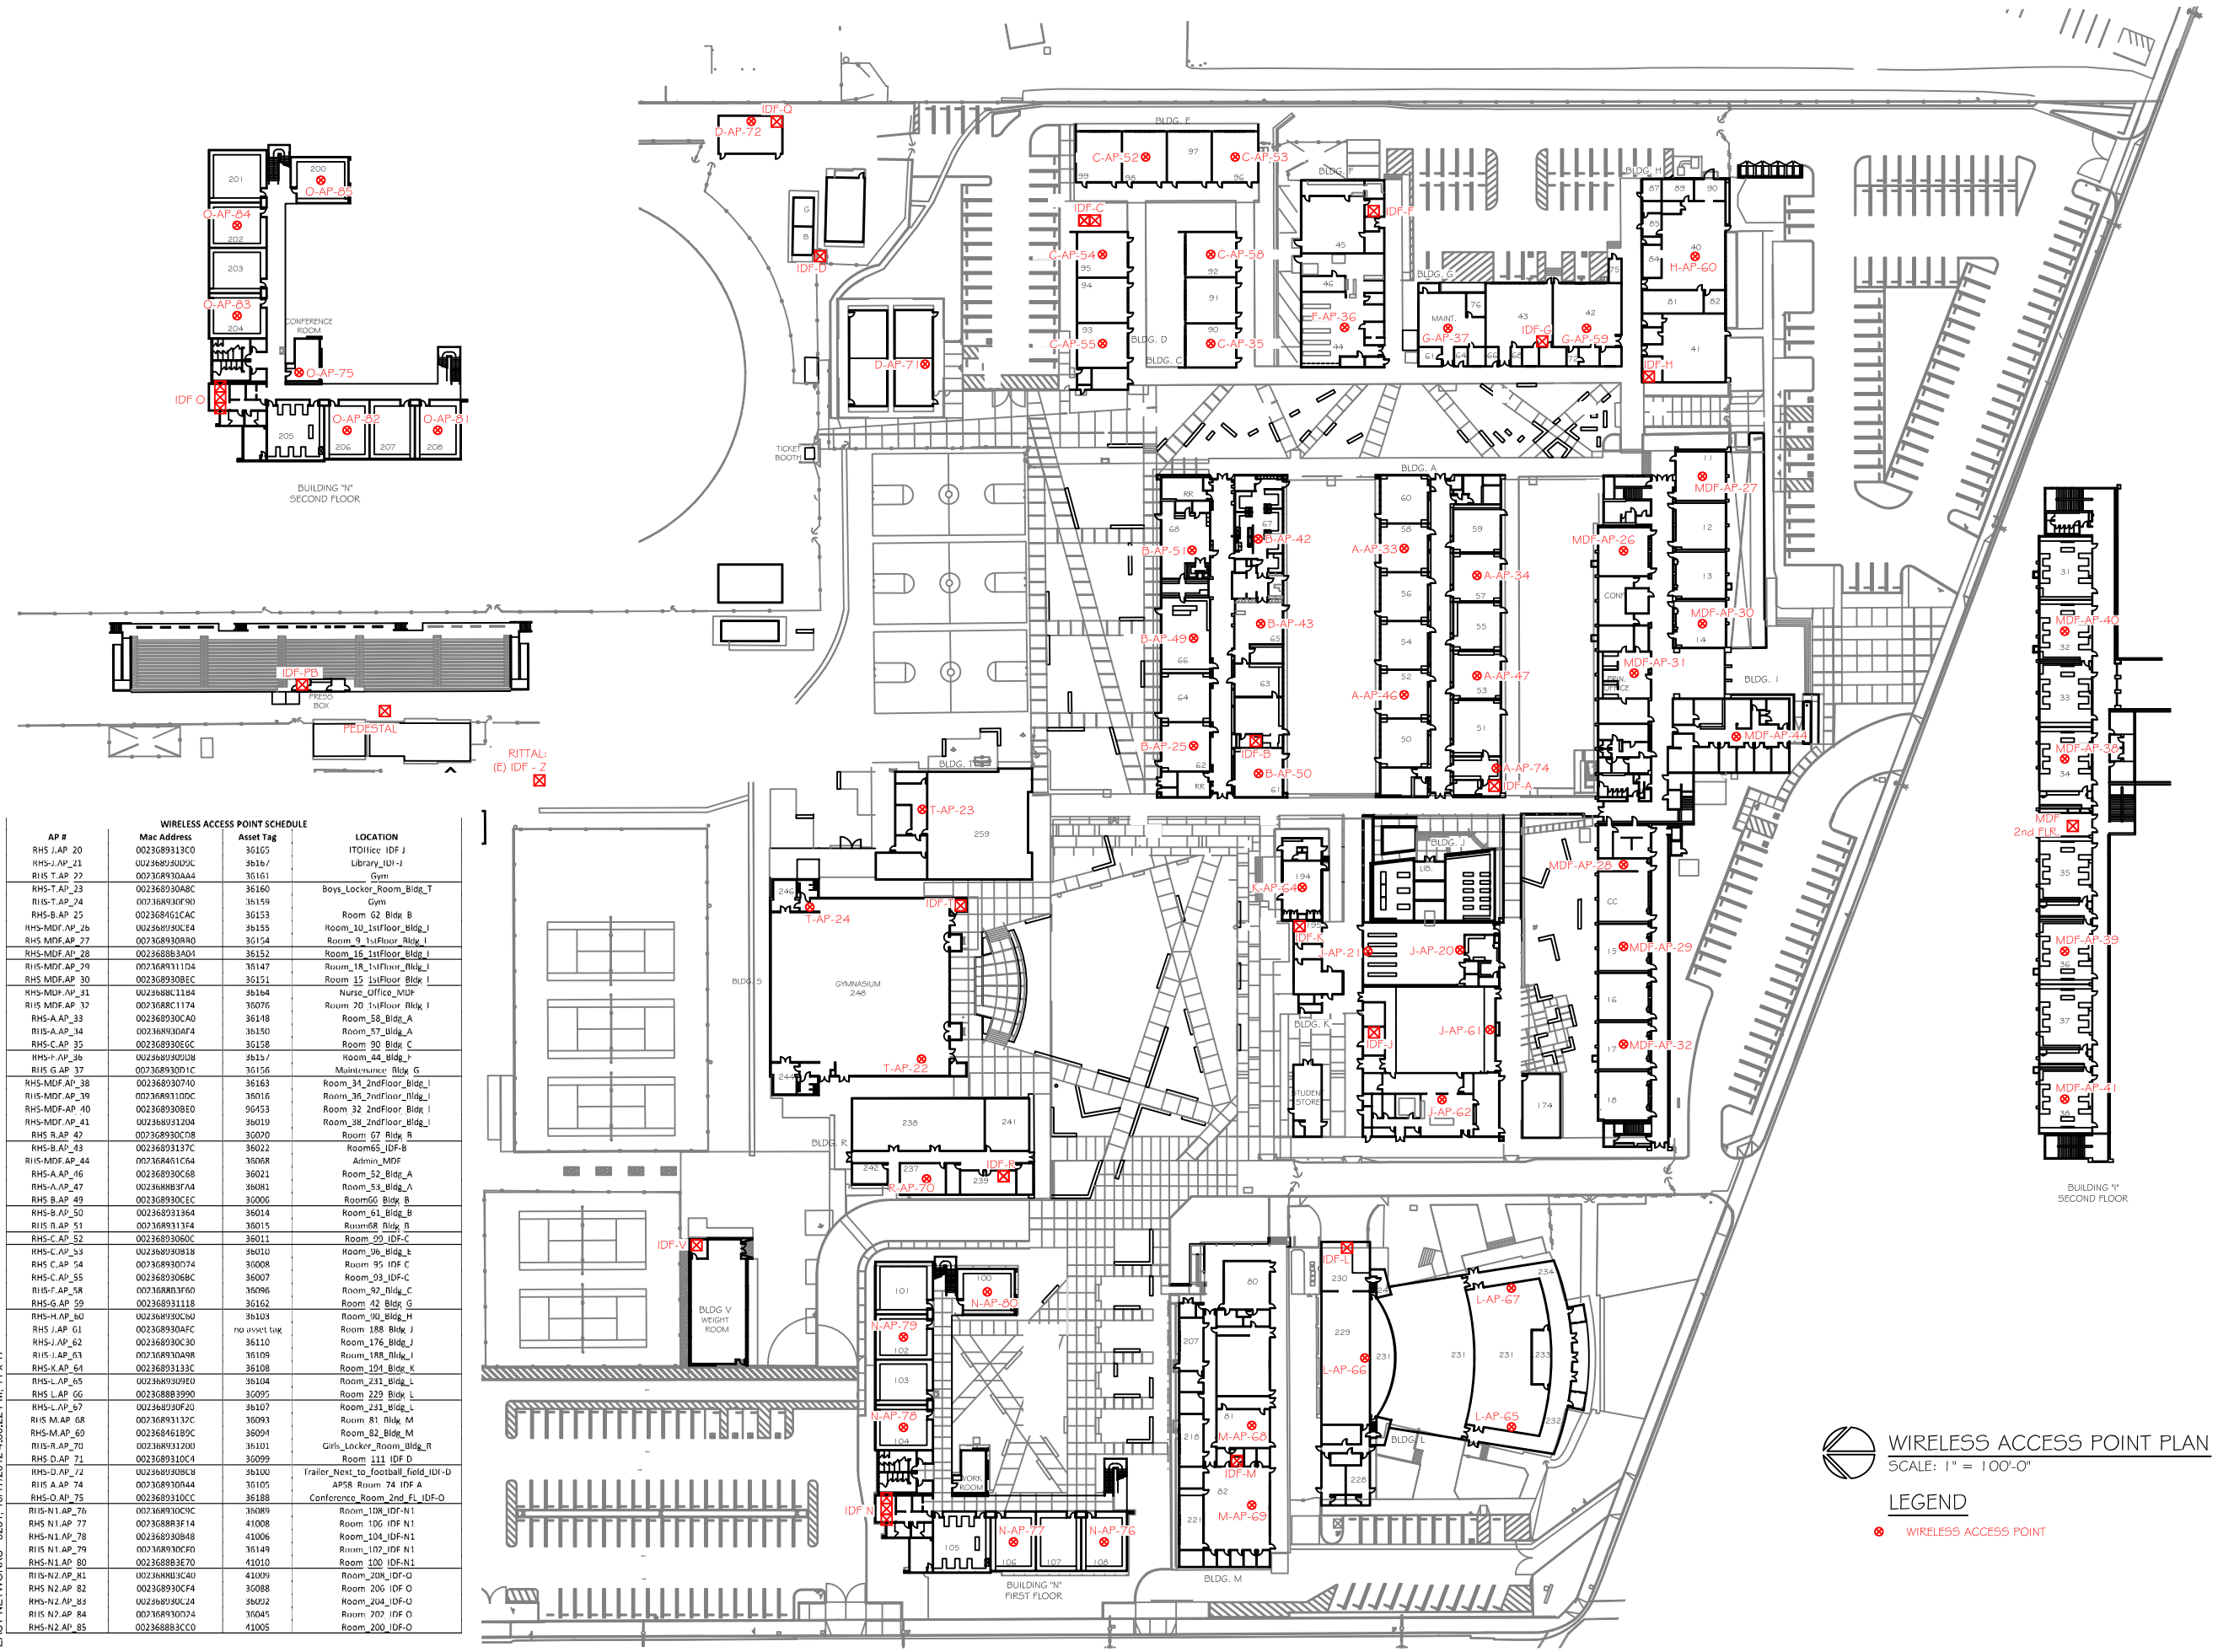

WIRELESS ACCESS POINT SCHEDULE

AP #	Mac Address	Asset Tag	LOCATION
RHS J.AP_20	002368931 3C0	36165	ITOffice IDF J
RHS-J.AP_21	002368936D0C	36167	Library_IDF-J
RHS T.AP_22	002368930AA4	36161	Gym
RHS-T.AP_23	002368930A8C	36160	Boys_Locker_Room_Bldg_T
RHS-T.AP_24	002368930F90	36159	Gym
RHS-B.AP_25	002368461CAC	36153	Room_62_Bldg_B
RHS-MDF.AP_26	002368930CE4	36155	Room_10_1stFloor_Bldg_I
RHS MDF.AP_27	002368930A90	36154	Room_9_1stFloor_Bldg_I
RHS-MDF.AP_28	002368B8A804	36152	Room_16_1stFloor_Bldg_I
RHS-MDF.AP_29	002368931 1D4	36147	Room_18_1stFloor_Bldg_I
RHS MDF.AP_30	002368930BEC	36151	Room_15_1stFloor_Bldg_I
RHS-MDF.AP_31	002368BC11B4	36164	Nurse_Office_MDF
RHS MDF.AP_32	002368BC1174	36076	Room_20_1stFloor_Bldg_I
RHS-A.AP_33	002368930CA0	36148	Room_58_Bldg_A
RHS-A.AP_34	002368930AF4	36150	Room_57_Bldg_A
RHS-C.AP_35	002368930E6C	36158	Room_90_Bldg_C
RHS-F.AP_36	002368930D38	36157	Room_44_Bldg_F
RHS G.AP_37	002368930D1C	36156	Maintenance_Bldg_G
RHS-MDF.AP_38	002368930740	36163	Room_34_2ndFloor_Bldg_I
RHS-MDF.AP_39	002368931 0DC	36016	Room_36_2ndFloor_Bldg_I
RHS-MDF.AP_40	002368930BE0	36453	Room_32_2ndFloor_Bldg_I
RHS-MDF.AP_41	002368931204	36019	Room_38_2ndFloor_Bldg_I
RHS B.AP_42	002368930CD8	36020	Room_67_Bldg_B
RHS-B.AP_43	002368931 37C	36022	Room65_IDF-B
RHS-MDF.AP_44	002368461C64	36068	Admin_MDF
RHS-A.AP_46	002368930C68	36021	Room_52_Bldg_A
RHS-A.AP_47	002368B83FA4	36081	Room_53_Bldg_A
RHS B.AP_49	002368930CEC	36006	Room66_Bldg_B
RHS-B.AP_50	002368931364	36014	Room_61_Bldg_B
RHS B.AP_51	002368931 3F4	36015	Room68_Bldg_B
RHS-C.AP_52	002368930E0C	36011	Room_89_IDF-C
RHS-C.AP_53	002368930B38	36010	Room_96_Bldg_C
RHS C.AP_54	002368930D74	36008	Room_95_IDF C
RHS-C.AP_55	002368930BBC	36007	Room_93_IDF-C
RHS-F.AP_58	002368B83F60	36096	Room_92_Bldg_C
RHS-G.AP_59	002368931118	36162	Room_42_Bldg_G
RHS-H.AP_60	002368930C60	36103	Room_90_Bldg_H
RHS J.AP_61	002368930AFC	no asset tag	Room_188_Bldg_J
RHS-J.AP_62	002368930C30	36110	Room_176_Bldg_J
RHS J.AP_63	002368930A98	36109	Room_188_Bldg_J
RHS-K.AP_64	002368931 33C	36108	Room_194_Bldg_K
RHS-L.AP_65	002368930E0	36104	Room_233_Bldg_L
RHS L.AP_66	002368B83990	36095	Room_229_Bldg_L
RHS-L.AP_67	002368930F20	36107	Room_233_Bldg_L
RHS M.AP_68	002368931 32C	36093	Room_81_Bldg_M
RHS-M.AP_69	002368461B9C	36094	Room_82_Bldg_M
RHS-R.AP_70	002368931200	36101	Girls_Locker_Room_Bldg_R
RHS D.AP_71	002368931 0C4	36099	Room_111_IDF-D
RHS-D.AP_72	002368930BC8	36100	Trailer_Next_to_football_field_IDF-D
RHS A.AP_74	002368930A44	36105	AP58_Room_74_IDF A
RHS-O.AP_75	002368931 0CC	36188	Conference_Room_2nd_FL_IDF-O
RHS-N1.AP_76	002368930C9C	36089	Room_108_IDF-N1
RHS N1.AP_77	002368B83F14	41008	Room_106_IDF N1
RHS-N1.AP_78	002368930A48	41006	Room_104_IDF-N1
RHS N1.AP_79	002368930CF0	36149	Room_102_IDF N1
RHS-N1.AP_80	002368B83E70	41010	Room_100_IDF-N1
RHS-N2.AP_81	002368B83C40	41009	Room_208_IDF-O
RHS N2.AP_82	002368930CF4	36088	Room_206_IDF O
RHS-N2.AP_83	002368930C24	36092	Room_204_IDF-O
RHS N2.AP_84	002368930D74	36045	Room_202_IDF O
RHS-N2.AP_85	002368B83CC0	41005	Room_200_IDF-O

WIRELESS ACCESS POINT PLAN

SCALE: 1" = 100'-0"

LEGEND

⊗ WIRELESS ACCESS POINT

EASY NETWORKS - 5231, 10/17/2012 4:30:22 PM, 11 x 17

EASYNETWORKS CABLING

3538 SHELLEY WAY
RIVERSIDE, CA. 92503
OFFICE : 951. 742.8119
FAX : 951.742.8125
ST. LIC. # 936770

PREPARED FOR:

EL MONTE UNION HIGH SCHOOL DISTRICT

SITE:

ROSEMEAD HIGH SCHOOL

9063 MISSION DRIVE
ROSEMEAD, CA 91770

AS-BUILT
PROJECT NO. 5231

REVISIONS:

	DATE:	DESCRIPTION:

DRAWN BY: GERARDO MORALES

DATE: 10/9/12
SCALE: AS SHOWN
SIZE: 11x17

TITLE:


WIRELESS ACCESS POINT PLAN

● PROPERTY OF EASY NETWORKS ●
● FOR USE BY EASY NETWORK ONLY ●


SHEET#:

T1

1 OF 17

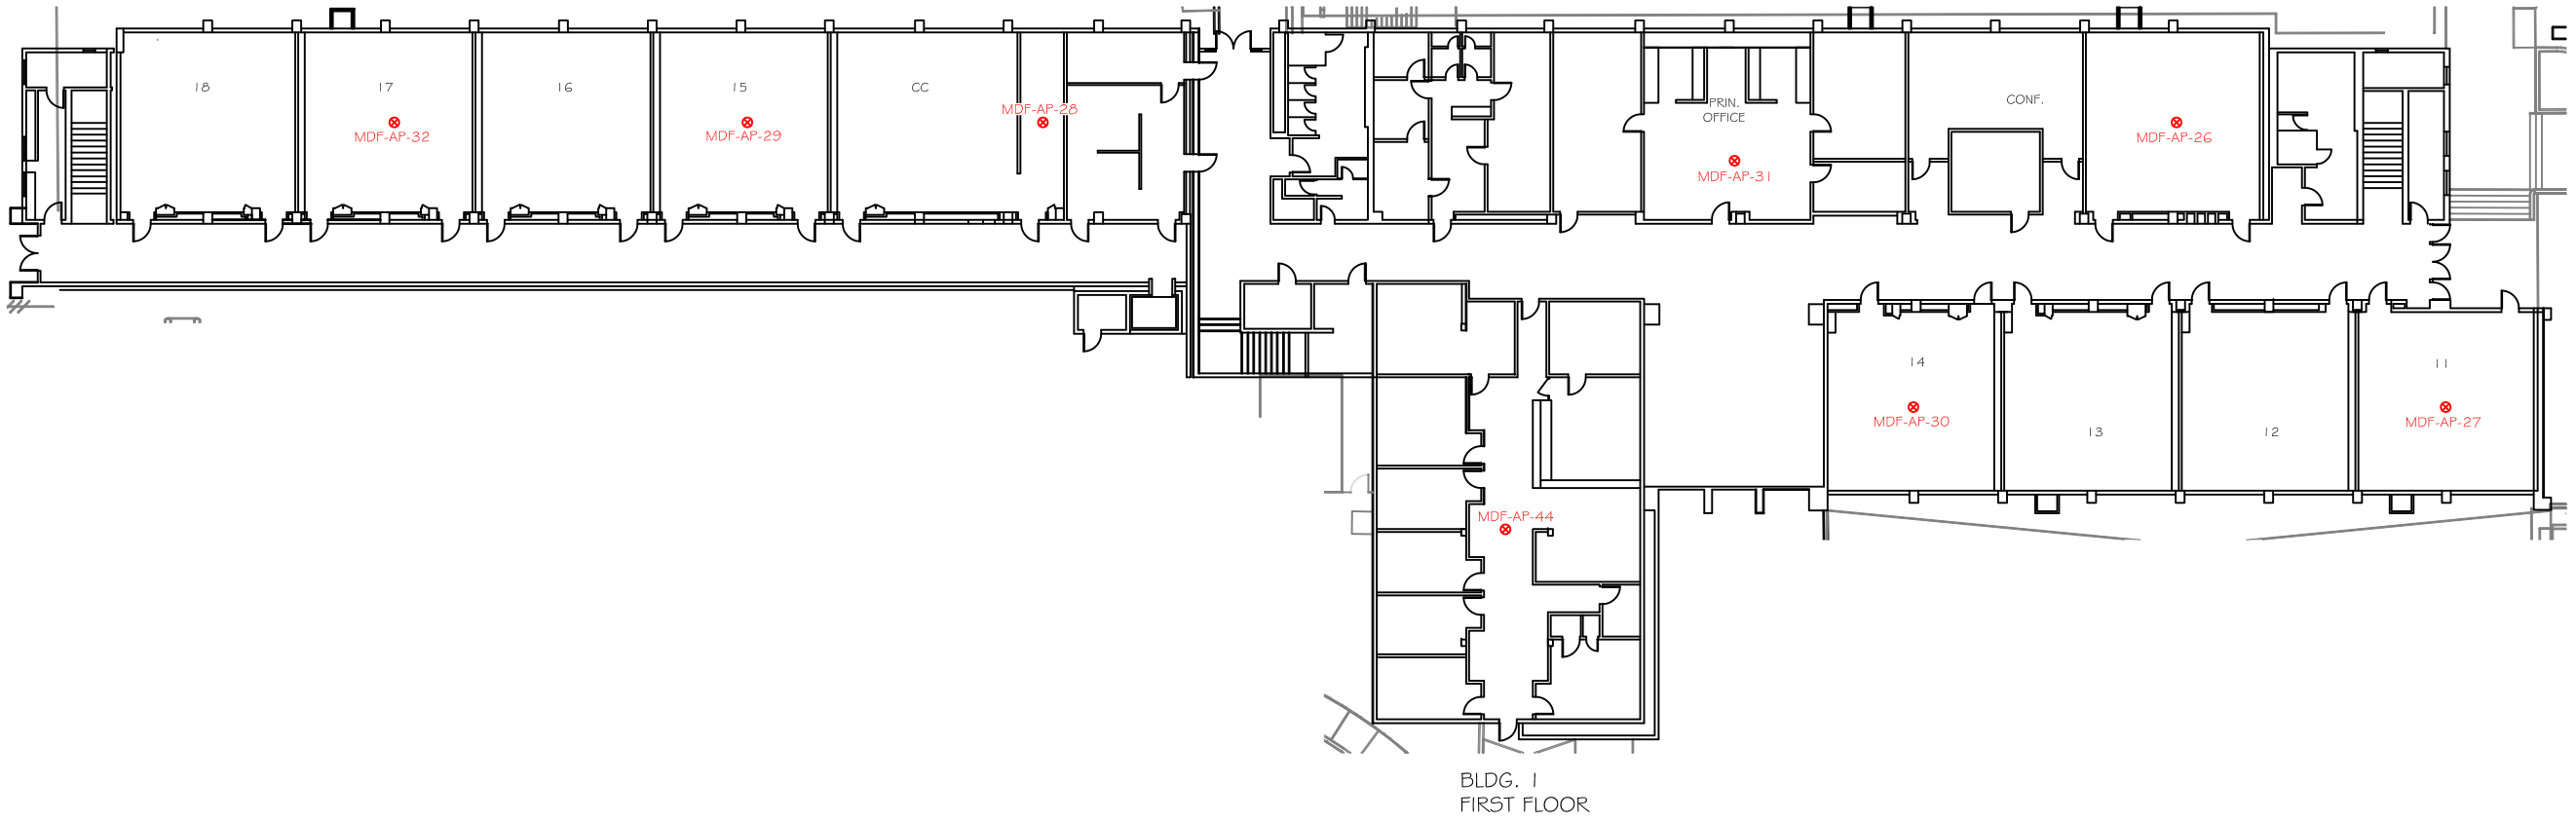

BLDG. 1
FIRST FLOOR

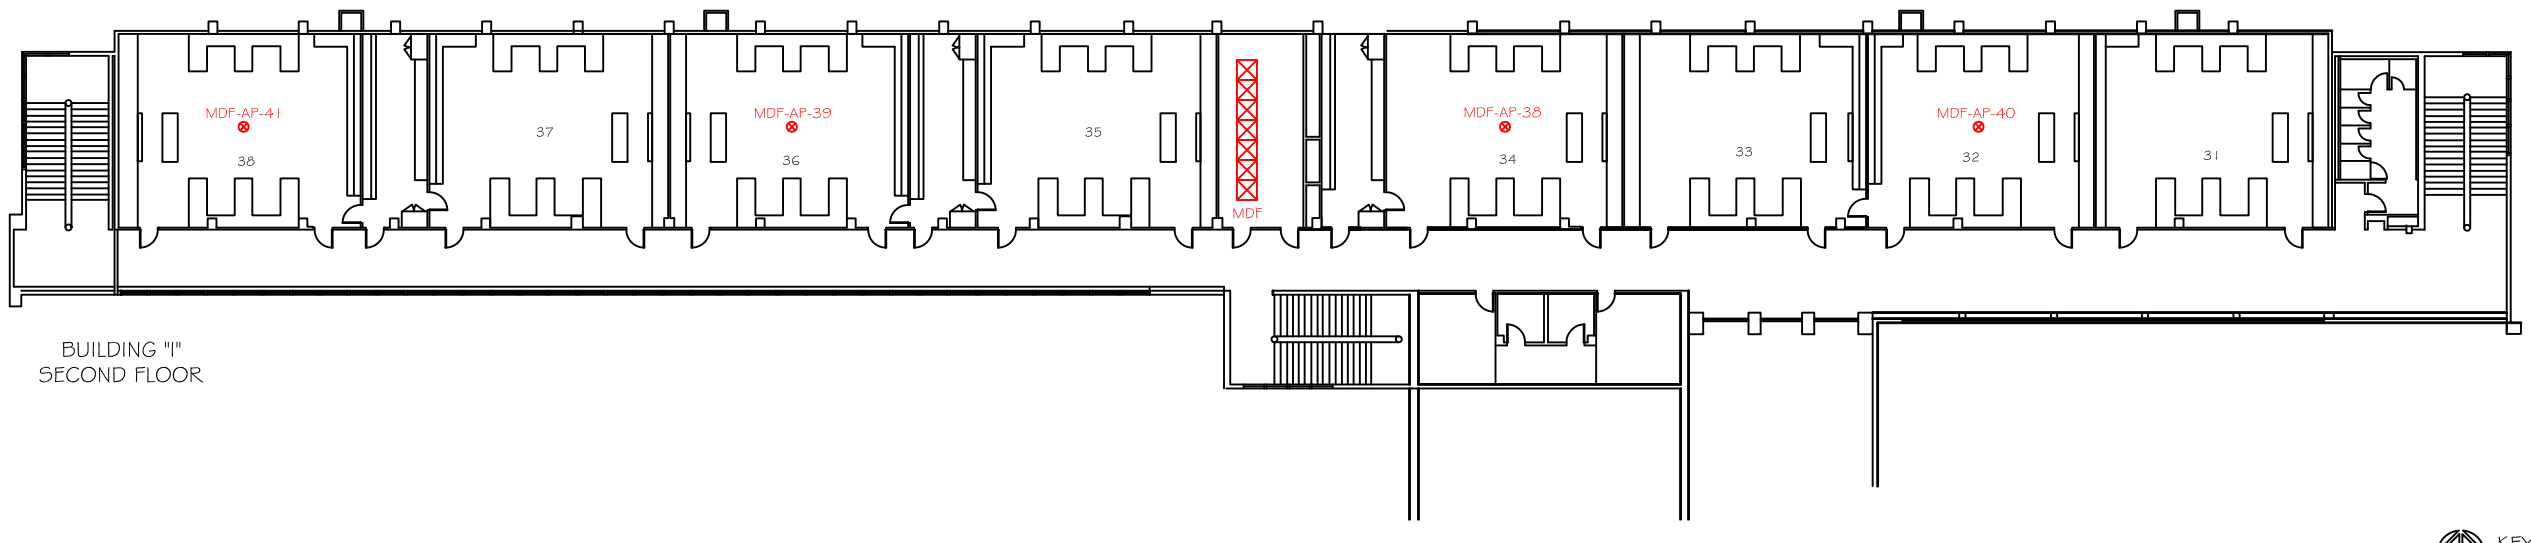

BUILDING "I"
SECOND FLOOR


MDF - WIRELESS ACCESS POINT PLAN

SCALE: 1/32" = 1'-0"

LEGEND

⊗ WIRELESS ACCESS POINT

KEYMAP
NTS

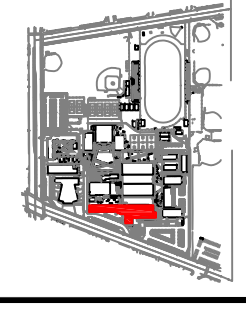

EASYNETWORKS CABLING
3538 SHELLEY WAY
RIVERSIDE, CA. 92503
OFFICE : 951. 742.8119
FAX : 951.742.8125
ST. LIC. # 936770

PREPARED FOR:

EL MONTE UNION HIGH SCHOOL DISTRICT

SITE:

ROSEMEAD HIGH SCHOOL

9063 MISSION DRIVE
ROSEMEAD, CA 91770

AS-BUILT
PROJECT NO. 5231

REVISIONS:

	DATE:	DESCRIPTION:

DRAWN BY:
GERARDO MORALES

DATE: 10/9/12
SCALE: AS SHOWN
SIZE: 11x17

TITLE:

MDF WIRELESS ACCESS POINT PLAN


● PROPERTY OF EASY NETWORKS ●
● FOR USE BY EASY NETWORK ONLY ●

SHEET#:

T2

2 OF 17

EASY NETWORKS - 5231 MDF, 10/17/2012 4:26:33 PM, 11 x 17

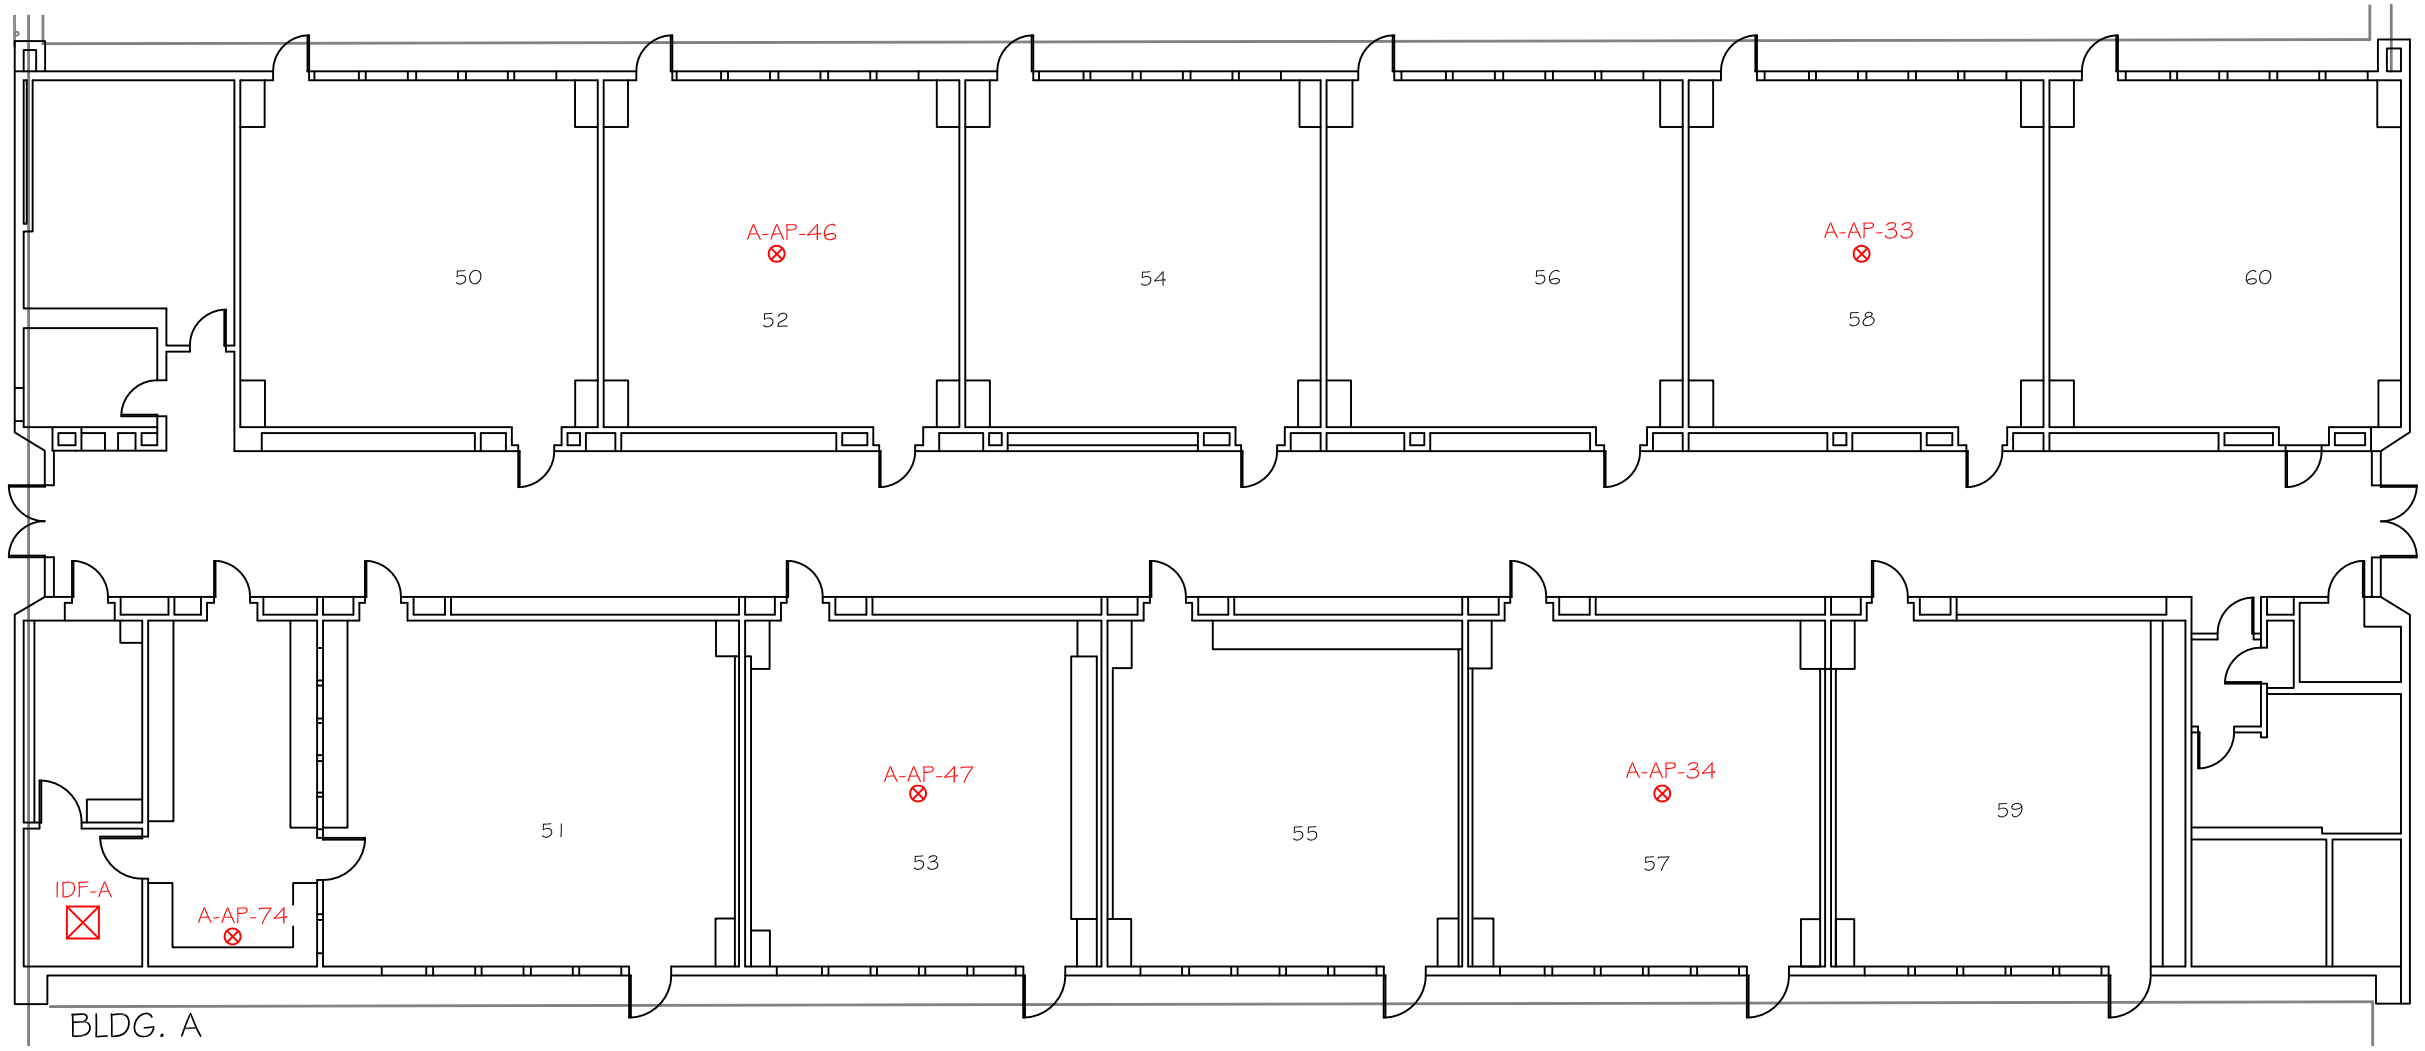


IDF-A - WIRELESS ACCESS POINT PLAN

SCALE: 1/16" = 1'-0"

LEGEND

⊗ WIRELESS ACCESS POINT

KEYMAP
NTS

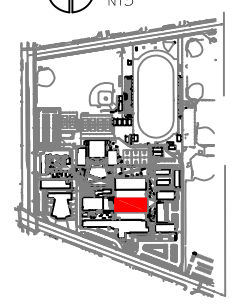

EASYNETWORKS CABLING
3538 SHELLEY WAY
RIVERSIDE, CA. 92503
OFFICE : 951. 742.8119
FAX : 951.742.8125
ST. LIC. # 936770

PREPARED FOR:

EL MONTE UNION HIGH SCHOOL DISTRICT

SITE:

ROSEMEAD HIGH SCHOOL

9063 MISSION DRIVE
ROSEMEAD, CA 91770

AS-BUILT
PROJECT NO. 5231

REVISIONS:

#	DATE:	DESCRIPTION:

DRAWN BY: GERARDO MORALES

DATE: 10/9/12
SCALE: AS SHOWN
SIZE: 11x17

TITLE:

IDF-A WIRELESS ACCESS POINT PLAN


● PROPERTY OF EASY NETWORKS ●
● FOR USE BY EASY NETWORK ONLY ●

SHEET#:

T3

3 OF 17

EASY NETWORKS - 5231 IDFA, 10/17/2012 4:26:43 PM, 11 x 17

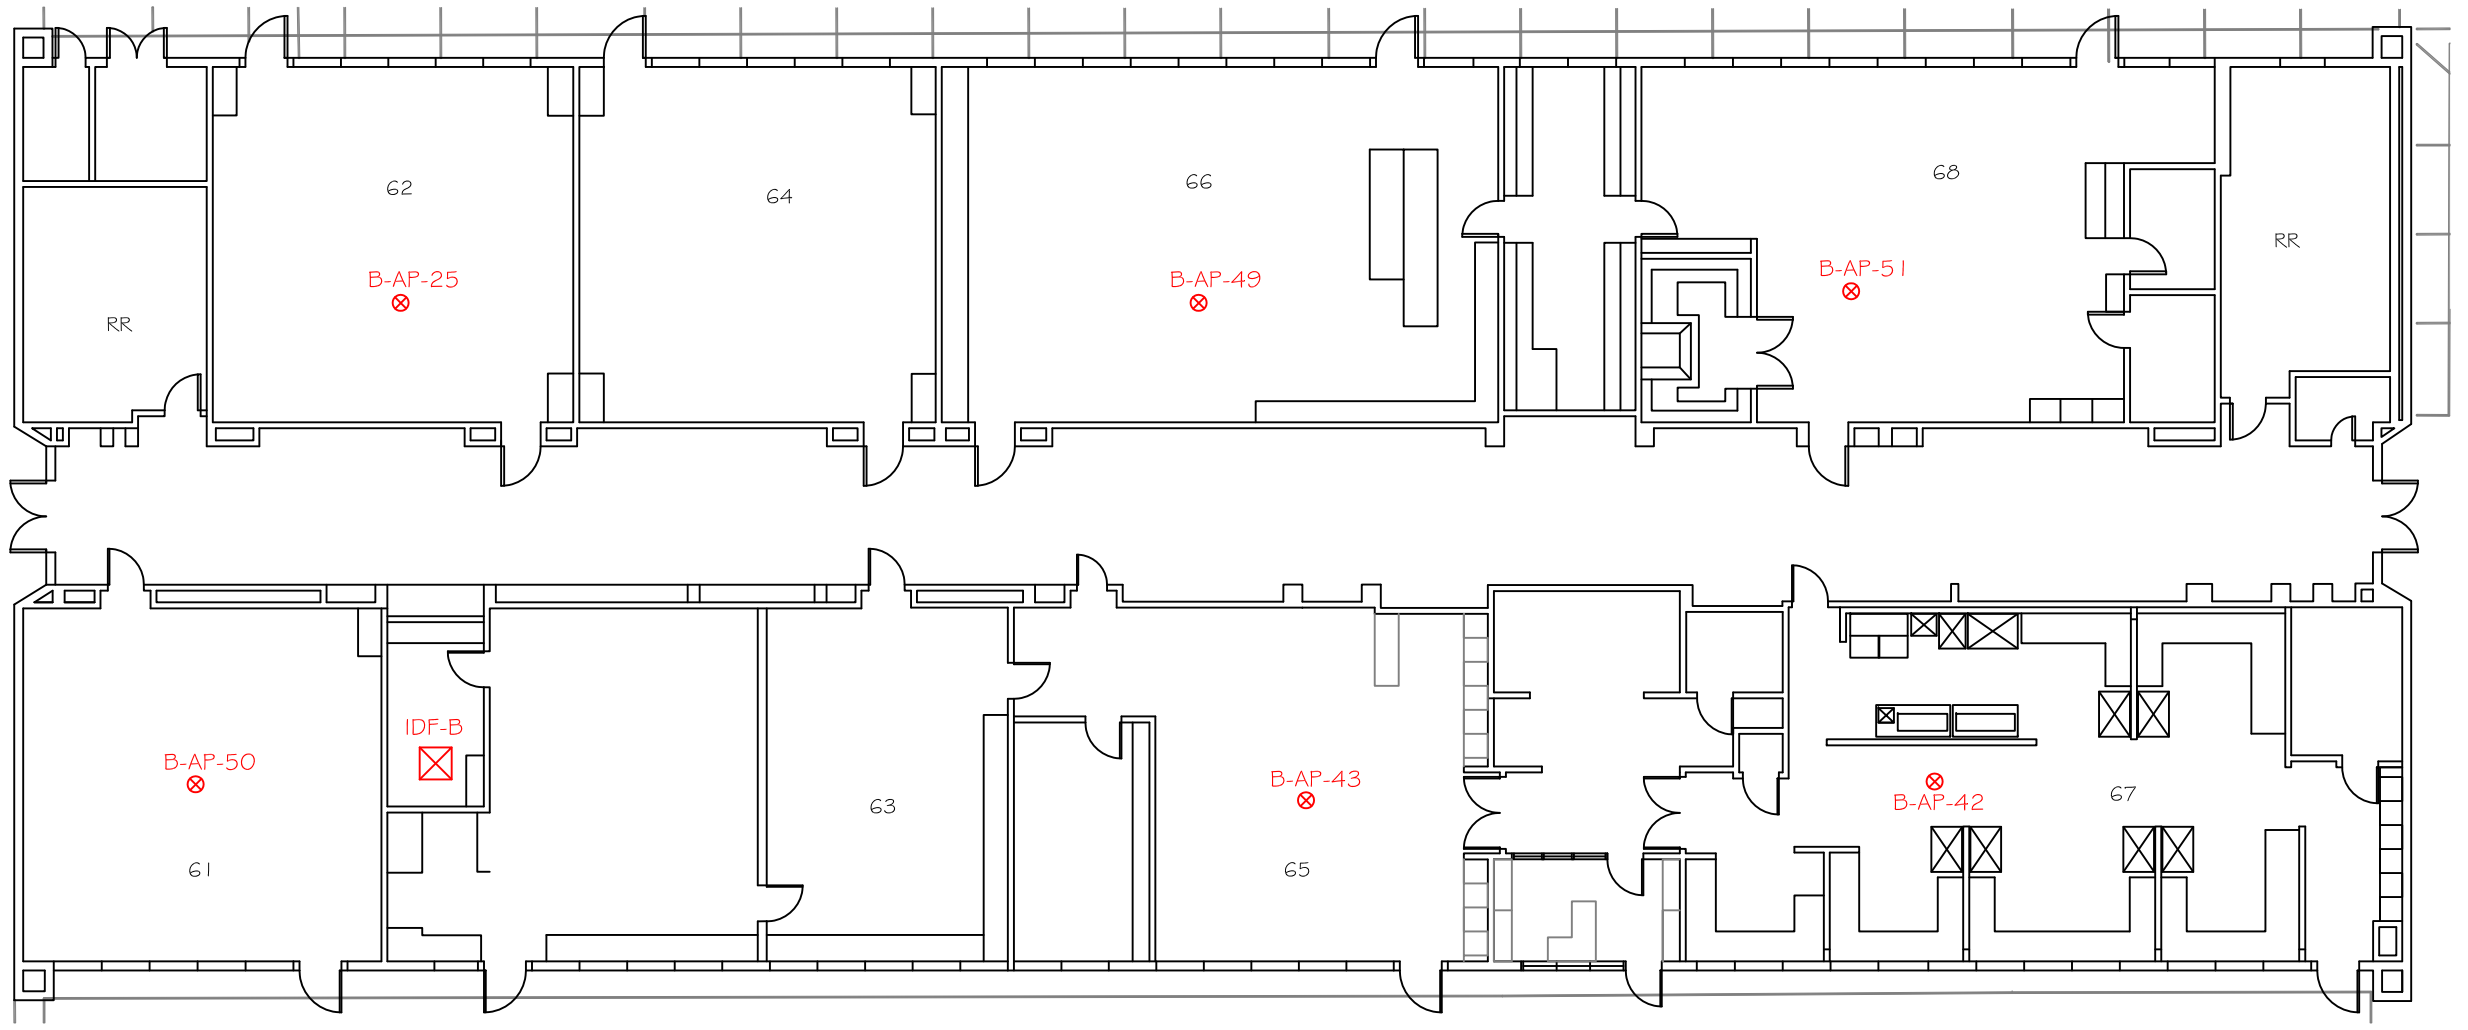


IDF-B - WIRELESS ACCESS POINT PLAN

SCALE: 1/16" = 1'-0"

LEGEND

⊗ WIRELESS ACCESS POINT

KEYMAP
NTS

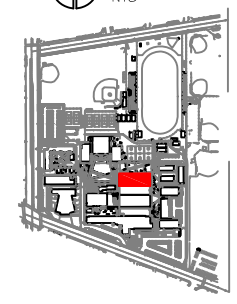

EASYNETWORKS CABLING

3538 SHELLEY WAY
RIVERSIDE, CA. 92503
OFFICE : 951. 742.8119
FAX : 951.742.8125
ST. LIC. # 936770

PREPARED FOR:

EL MONTE UNION HIGH SCHOOL DISTRICT

SITE:

ROSEMEAD HIGH SCHOOL

9063 MISSION DRIVE
ROSEMEAD, CA 91770

AS-BUILT
PROJECT NO. 5231

REVISIONS:

#	DATE:	DESCRIPTION:

DRAWN BY: GERARDO MORALES

DATE: 10/9/12
SCALE: AS SHOWN
SIZE: 11x17

TITLE:

IDF-B WIRELESS ACCESS POINT PLAN


● PROPERTY OF EASY NETWORKS ●
● FOR USE BY EASY NETWORK ONLY ●

SHEET#:

T4

4 OF 17

EASY NETWORKS - 5231 IDF B, 10/17/2012 4:26:55 PM, 11 x 17

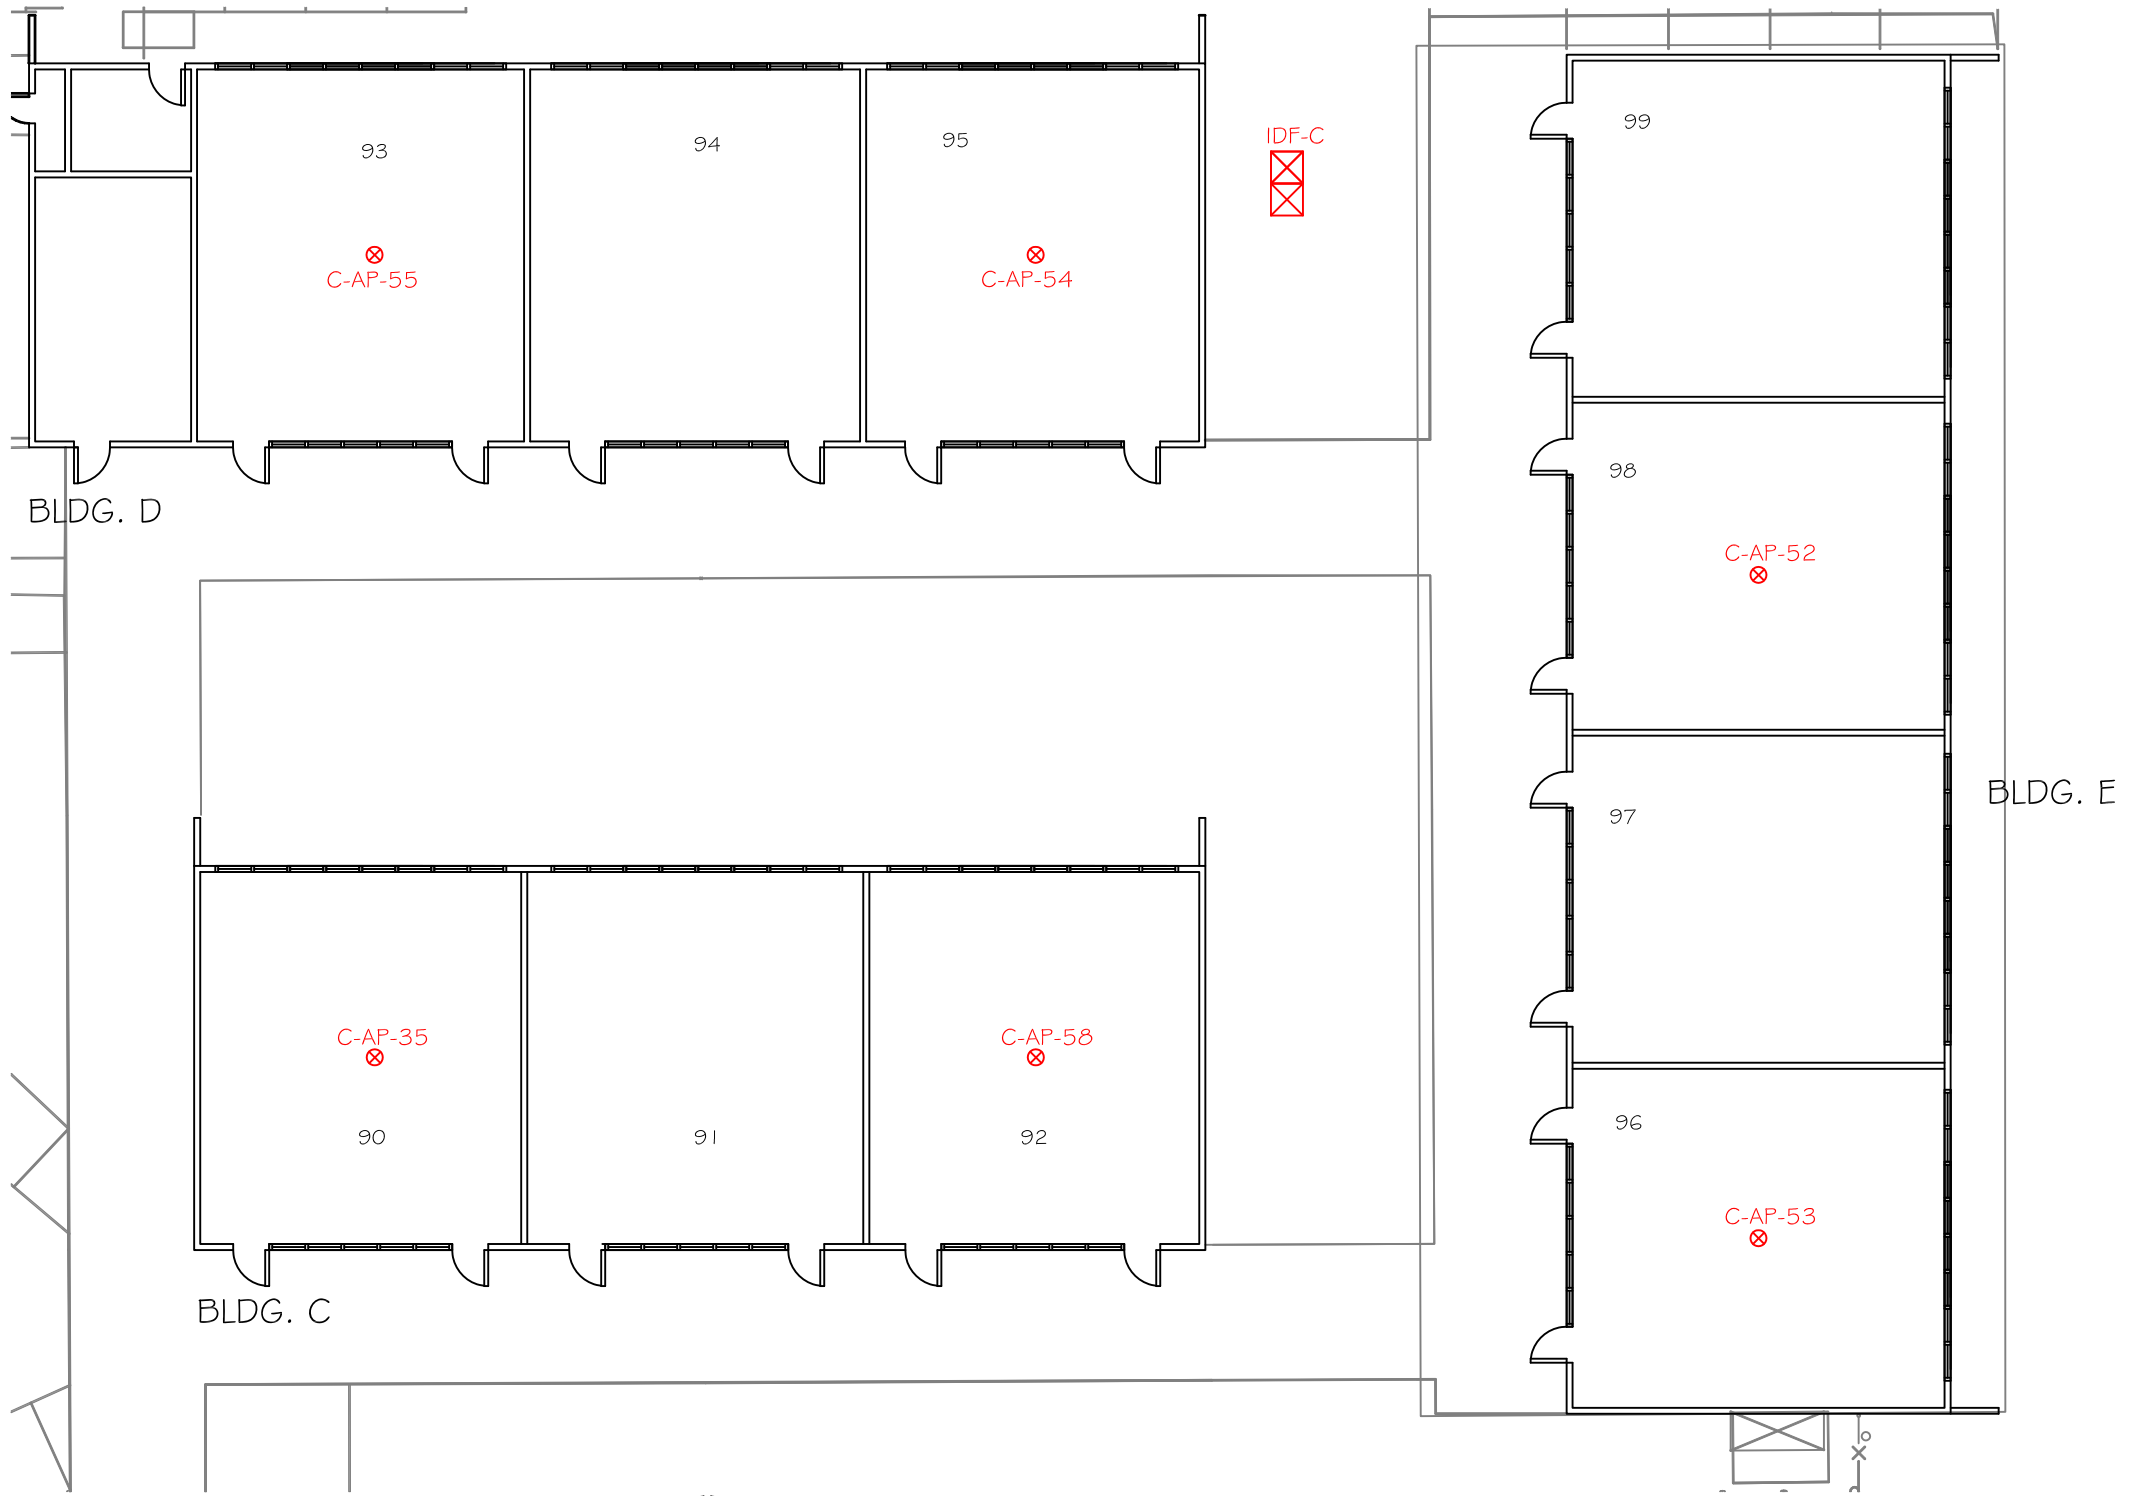


IDF-C - WIRELESS ACCESS POINT PLAN

SCALE: 1/16" = 1'-0"

LEGEND

⊗ WIRELESS ACCESS POINT

KEYMAP
NTS

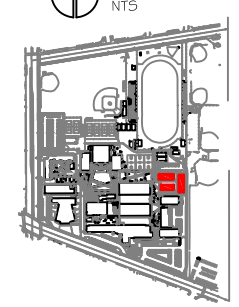

EASYNETWORKS CABLING
3538 SHELLEY WAY
RIVERSIDE, CA. 92503
OFFICE : 951. 742.8119
FAX : 951.742.8125
ST. LIC. # 936770

PREPARED FOR:

EL MONTE UNION HIGH SCHOOL DISTRICT

SITE:

ROSEMEAD HIGH SCHOOL

9063 MISSION DRIVE
ROSEMEAD, CA 91770

AS-BUILT
PROJECT NO. 5231

REVISIONS:

#	DATE:	DESCRIPTION:

DRAWN BY:
GERARDO MORALES

DATE: 10/9/12
SCALE: AS SHOWN
SIZE: 11x17

TITLE:

IDF-C WIRELESS ACCESS POINT PLAN


• PROPERTY OF EASY NETWORKS •
• FOR USE BY EASY NETWORK ONLY •

SHEET#:

T5

5 OF 17

EASY NETWORKS - 5231 IDF C, 10/17/2012 4:27:06 PM, 11 x 17

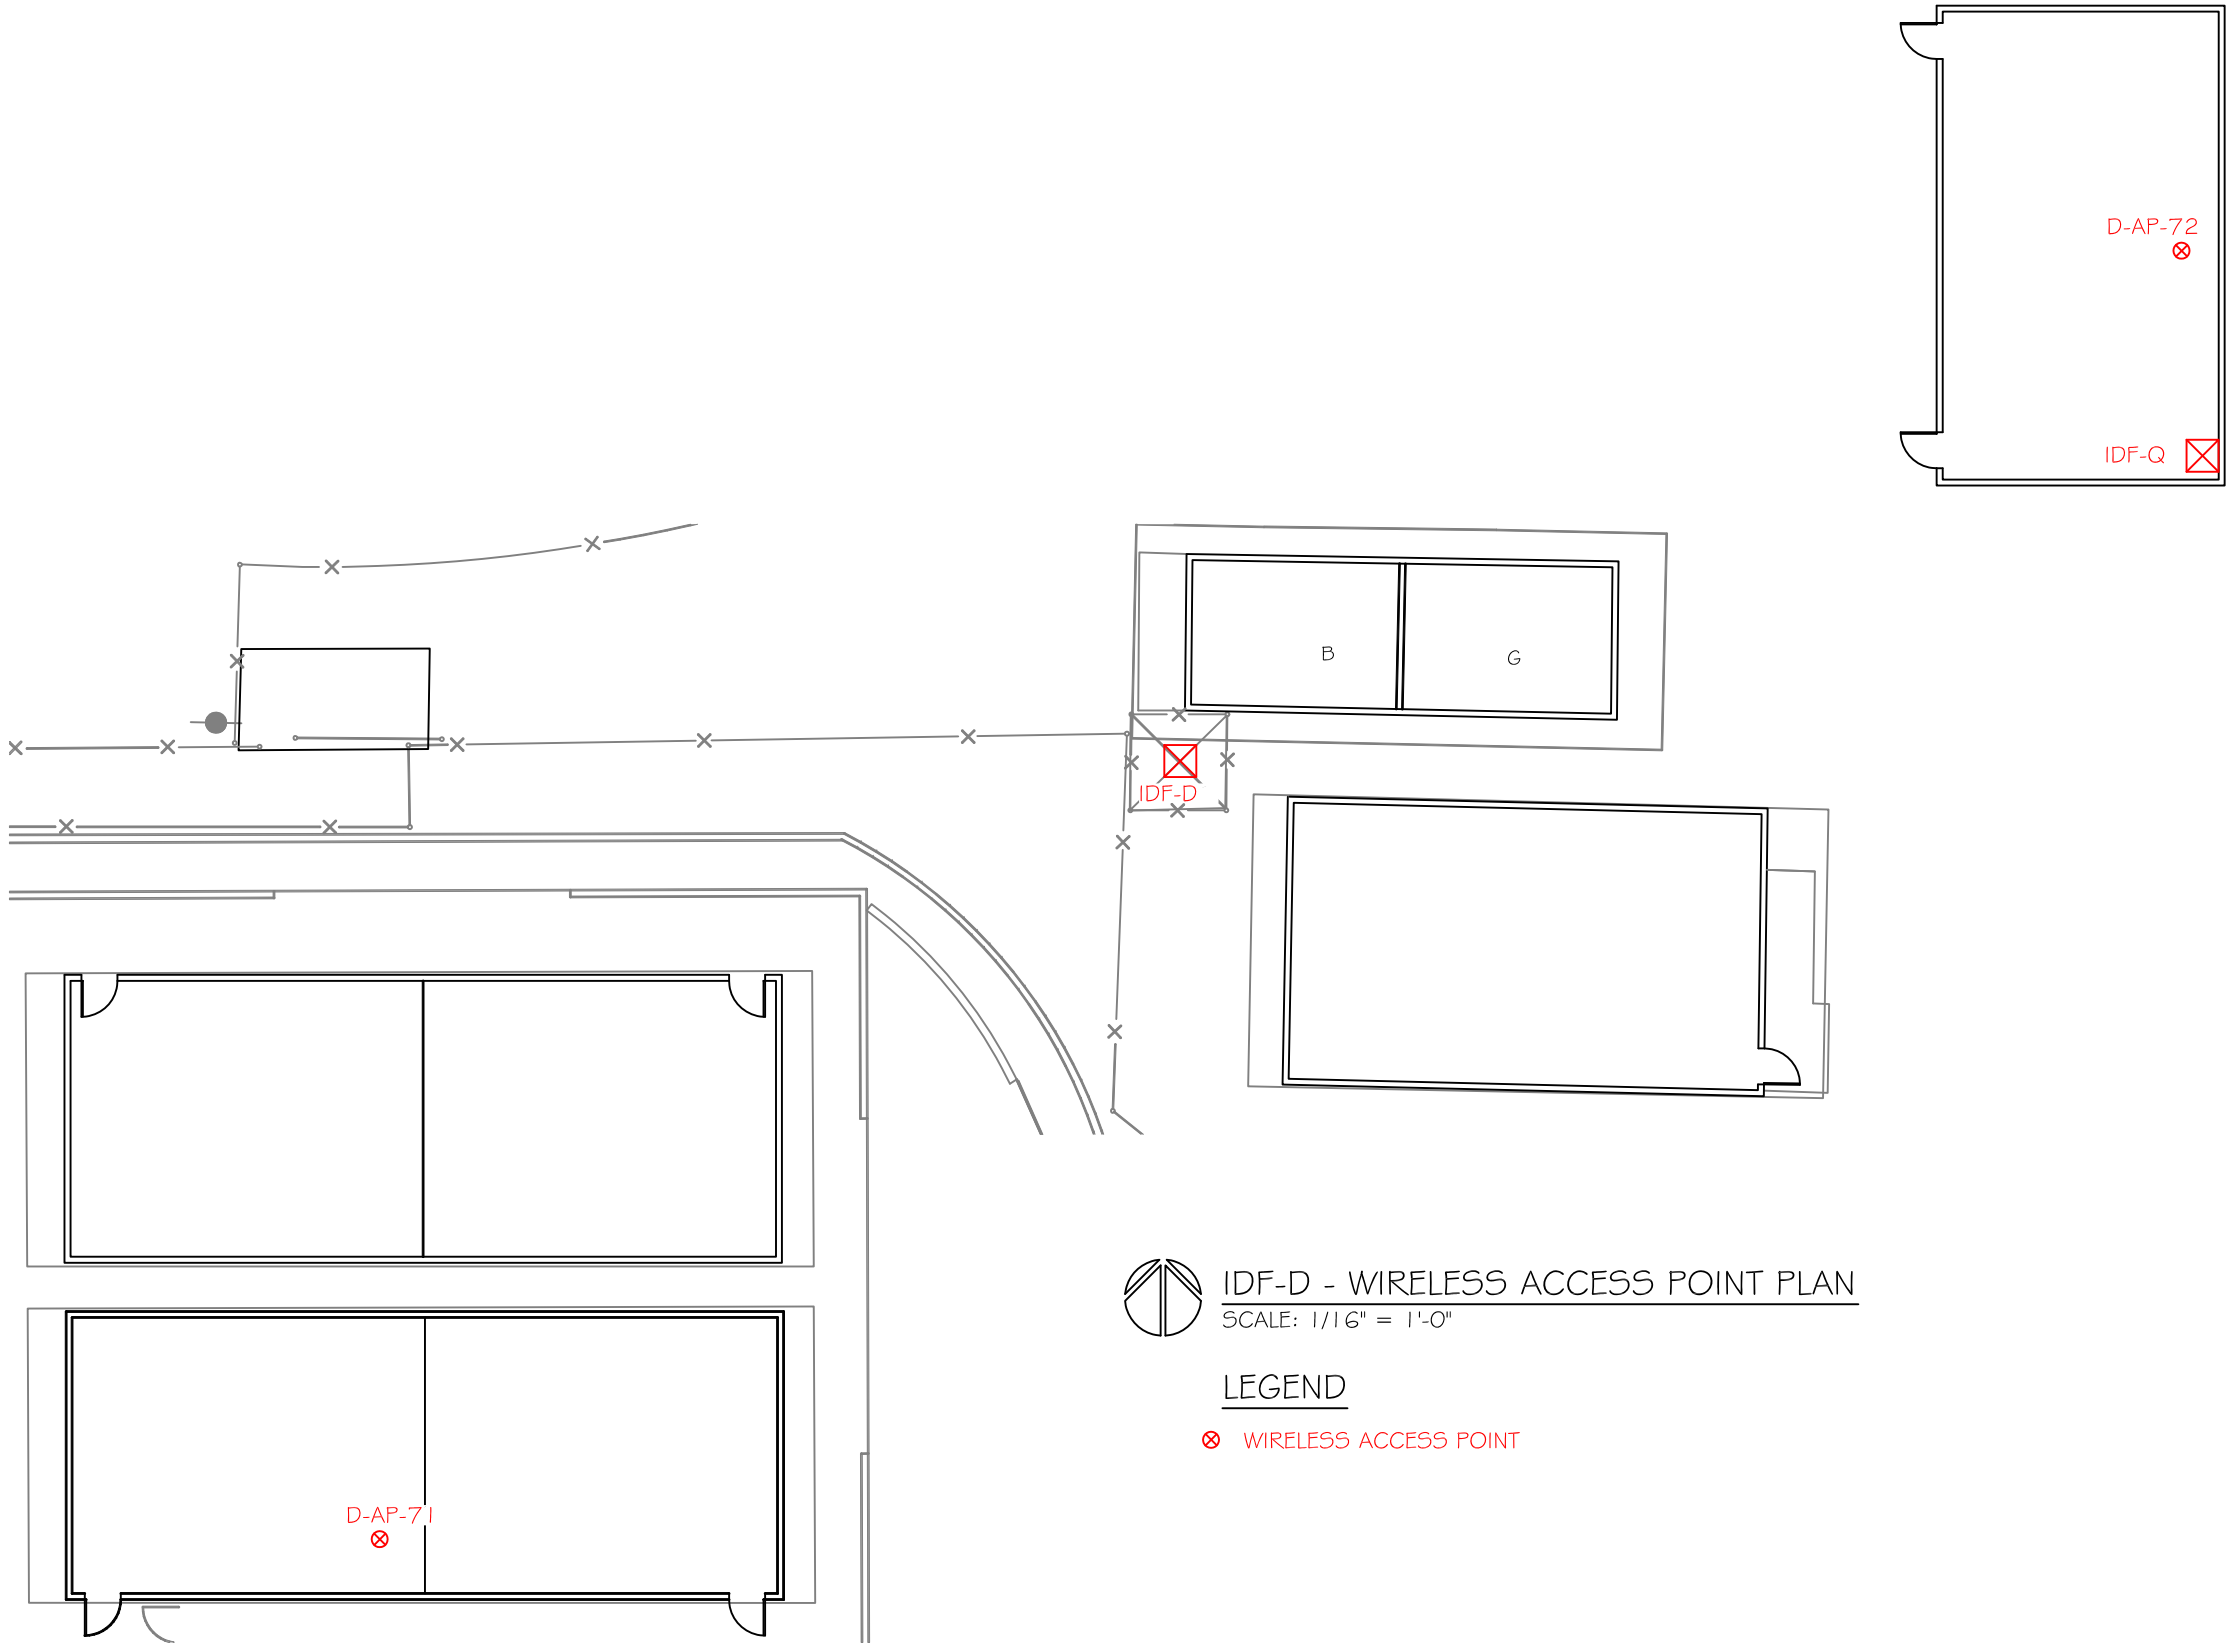


IDF-D - WIRELESS ACCESS POINT PLAN

SCALE: 1/16" = 1'-0"

LEGEND

⊗ WIRELESS ACCESS POINT

KEYMAP
NTS

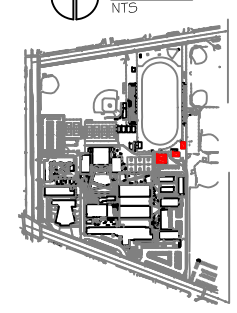

EASYNETWORKS CABLING
3538 SHELLEY WAY
RIVERSIDE, CA. 92503
OFFICE : 951. 742.8119
FAX : 951.742.8125
ST. LIC. # 936770

PREPARED FOR:

EL MONTE UNION HIGH SCHOOL DISTRICT

SITE:

ROSEMEAD HIGH SCHOOL

9063 MISSION DRIVE
ROSEMEAD, CA 91770

AS-BUILT
PROJECT NO. 5231

REVISIONS:

#	DATE:	DESCRIPTION:

DRAWN BY: GERARDO MORALES

DATE: 10/9/12
SCALE: AS SHOWN
SIZE: 11x17

TITLE:

IDF-D WIRELESS ACCESS POINT PLAN


● PROPERTY OF EASY NETWORKS ●
● FOR USE BY EASY NETWORK ONLY ●

SHEET#:

T6

6 OF 17

EASY NETWORKS - 5231 IDF D, 10/17/2012 4:27:17 PM, 11 x 17

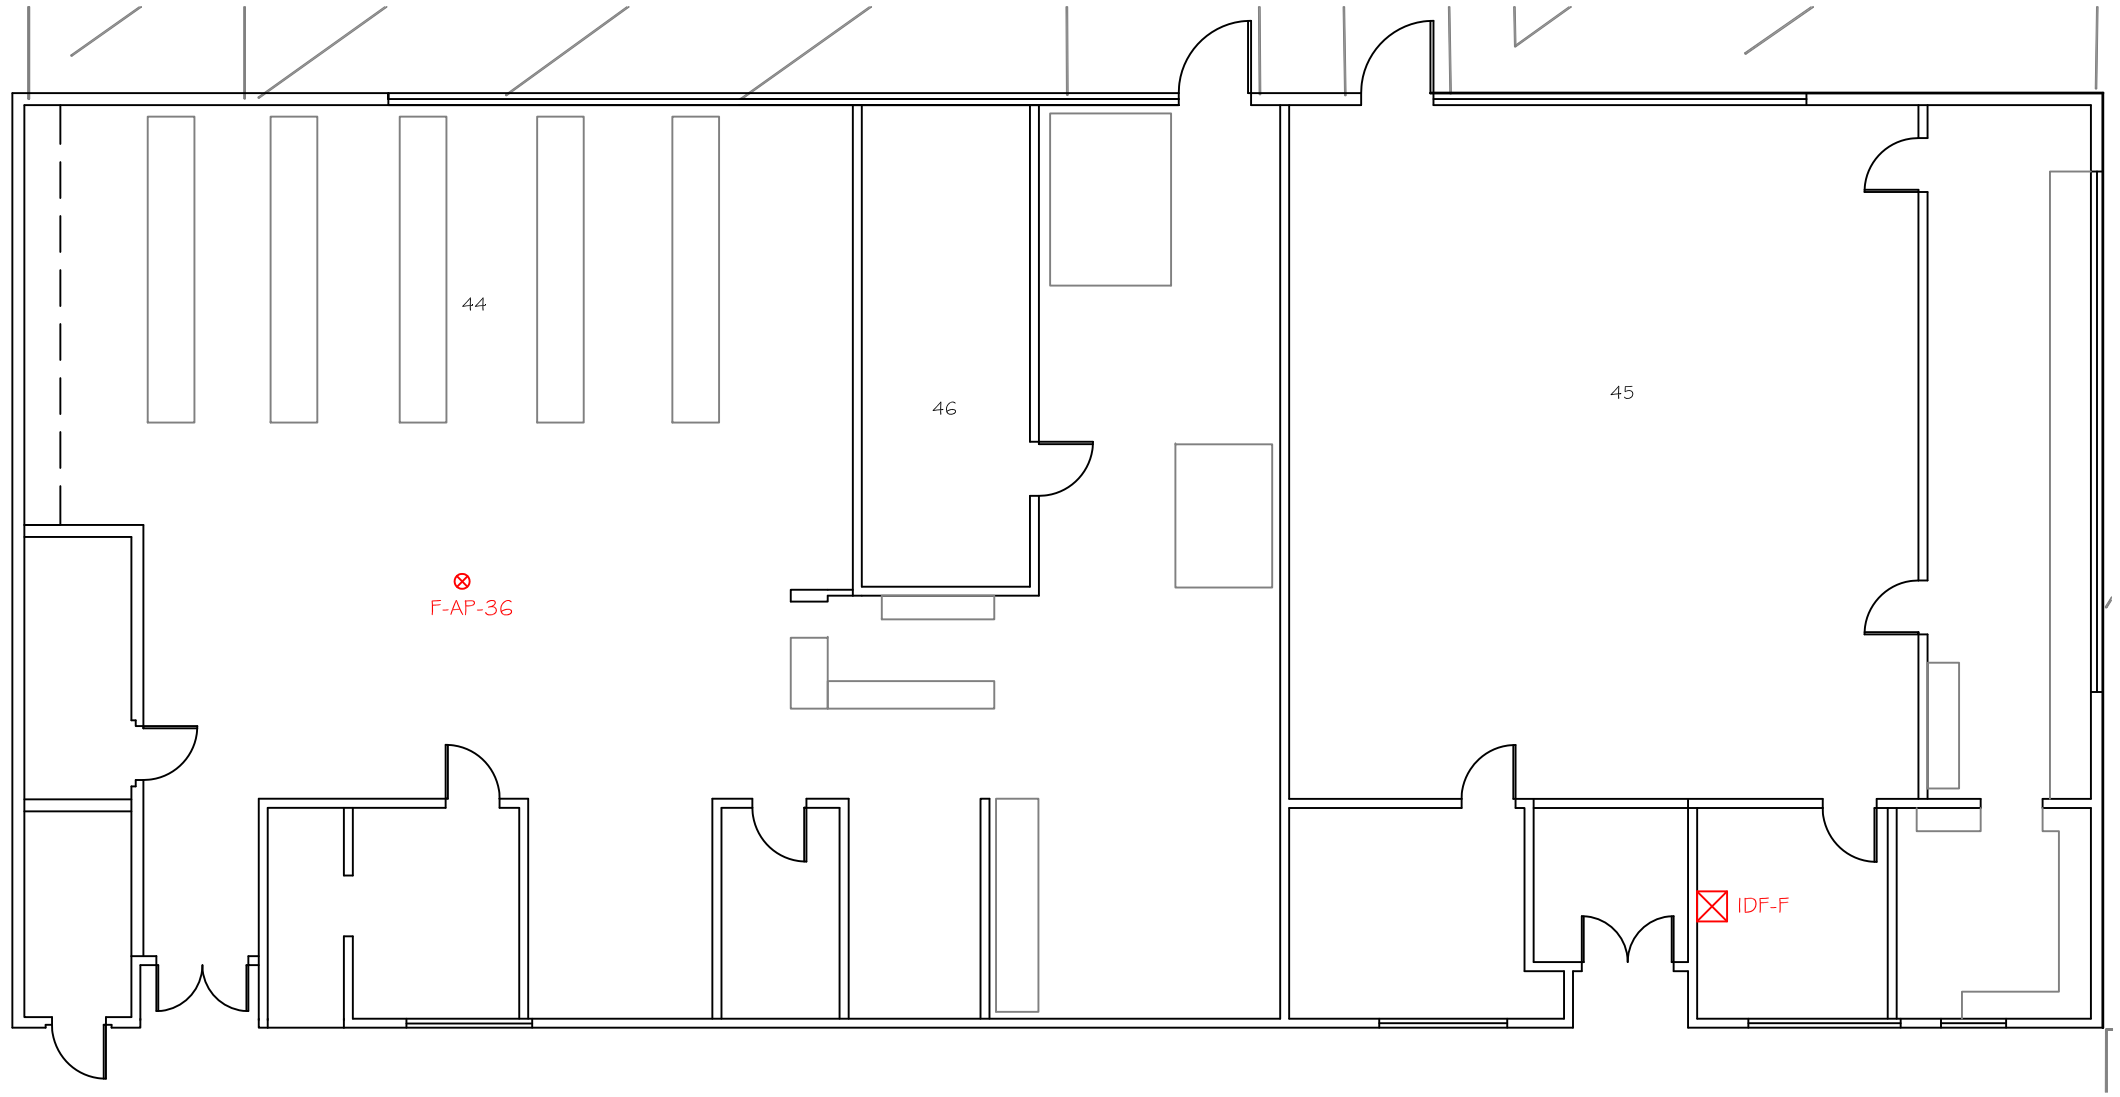


IDF-F - WIRELESS ACCESS POINT PLAN

SCALE: 3/32" = 1'-0"

LEGEND

⊗ WIRELESS ACCESS POINT

KEYMAP
NTS

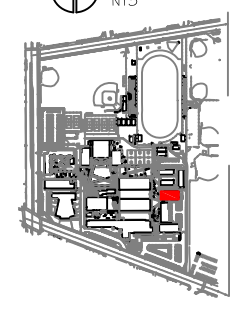

EASYNETWORKS CABLING
3538 SHELLEY WAY
RIVERSIDE, CA. 92503
OFFICE : 951. 742.8119
FAX : 951.742.8125
ST. LIC. # 936770

PREPARED FOR:

EL MONTE UNION HIGH SCHOOL DISTRICT

SITE:

ROSEMEAD HIGH SCHOOL

9063 MISSION DRIVE
ROSEMEAD, CA 91770

AS-BUILT
PROJECT NO. 5231

REVISIONS:

#	DATE:	DESCRIPTION:

DRAWN BY: GERARDO MORALES

DATE: 10/9/12
SCALE: AS SHOWN
SIZE: 11x17

TITLE:

IDF-F WIRELESS ACCESS POINT PLAN


• PROPERTY OF EASY NETWORKS •
• FOR USE BY EASY NETWORK ONLY •

SHEET#:

T7

7 OF 17

EASY NETWORKS - 5231 IDF F, 10/17/2012 4:27:27 PM, 11 x 17

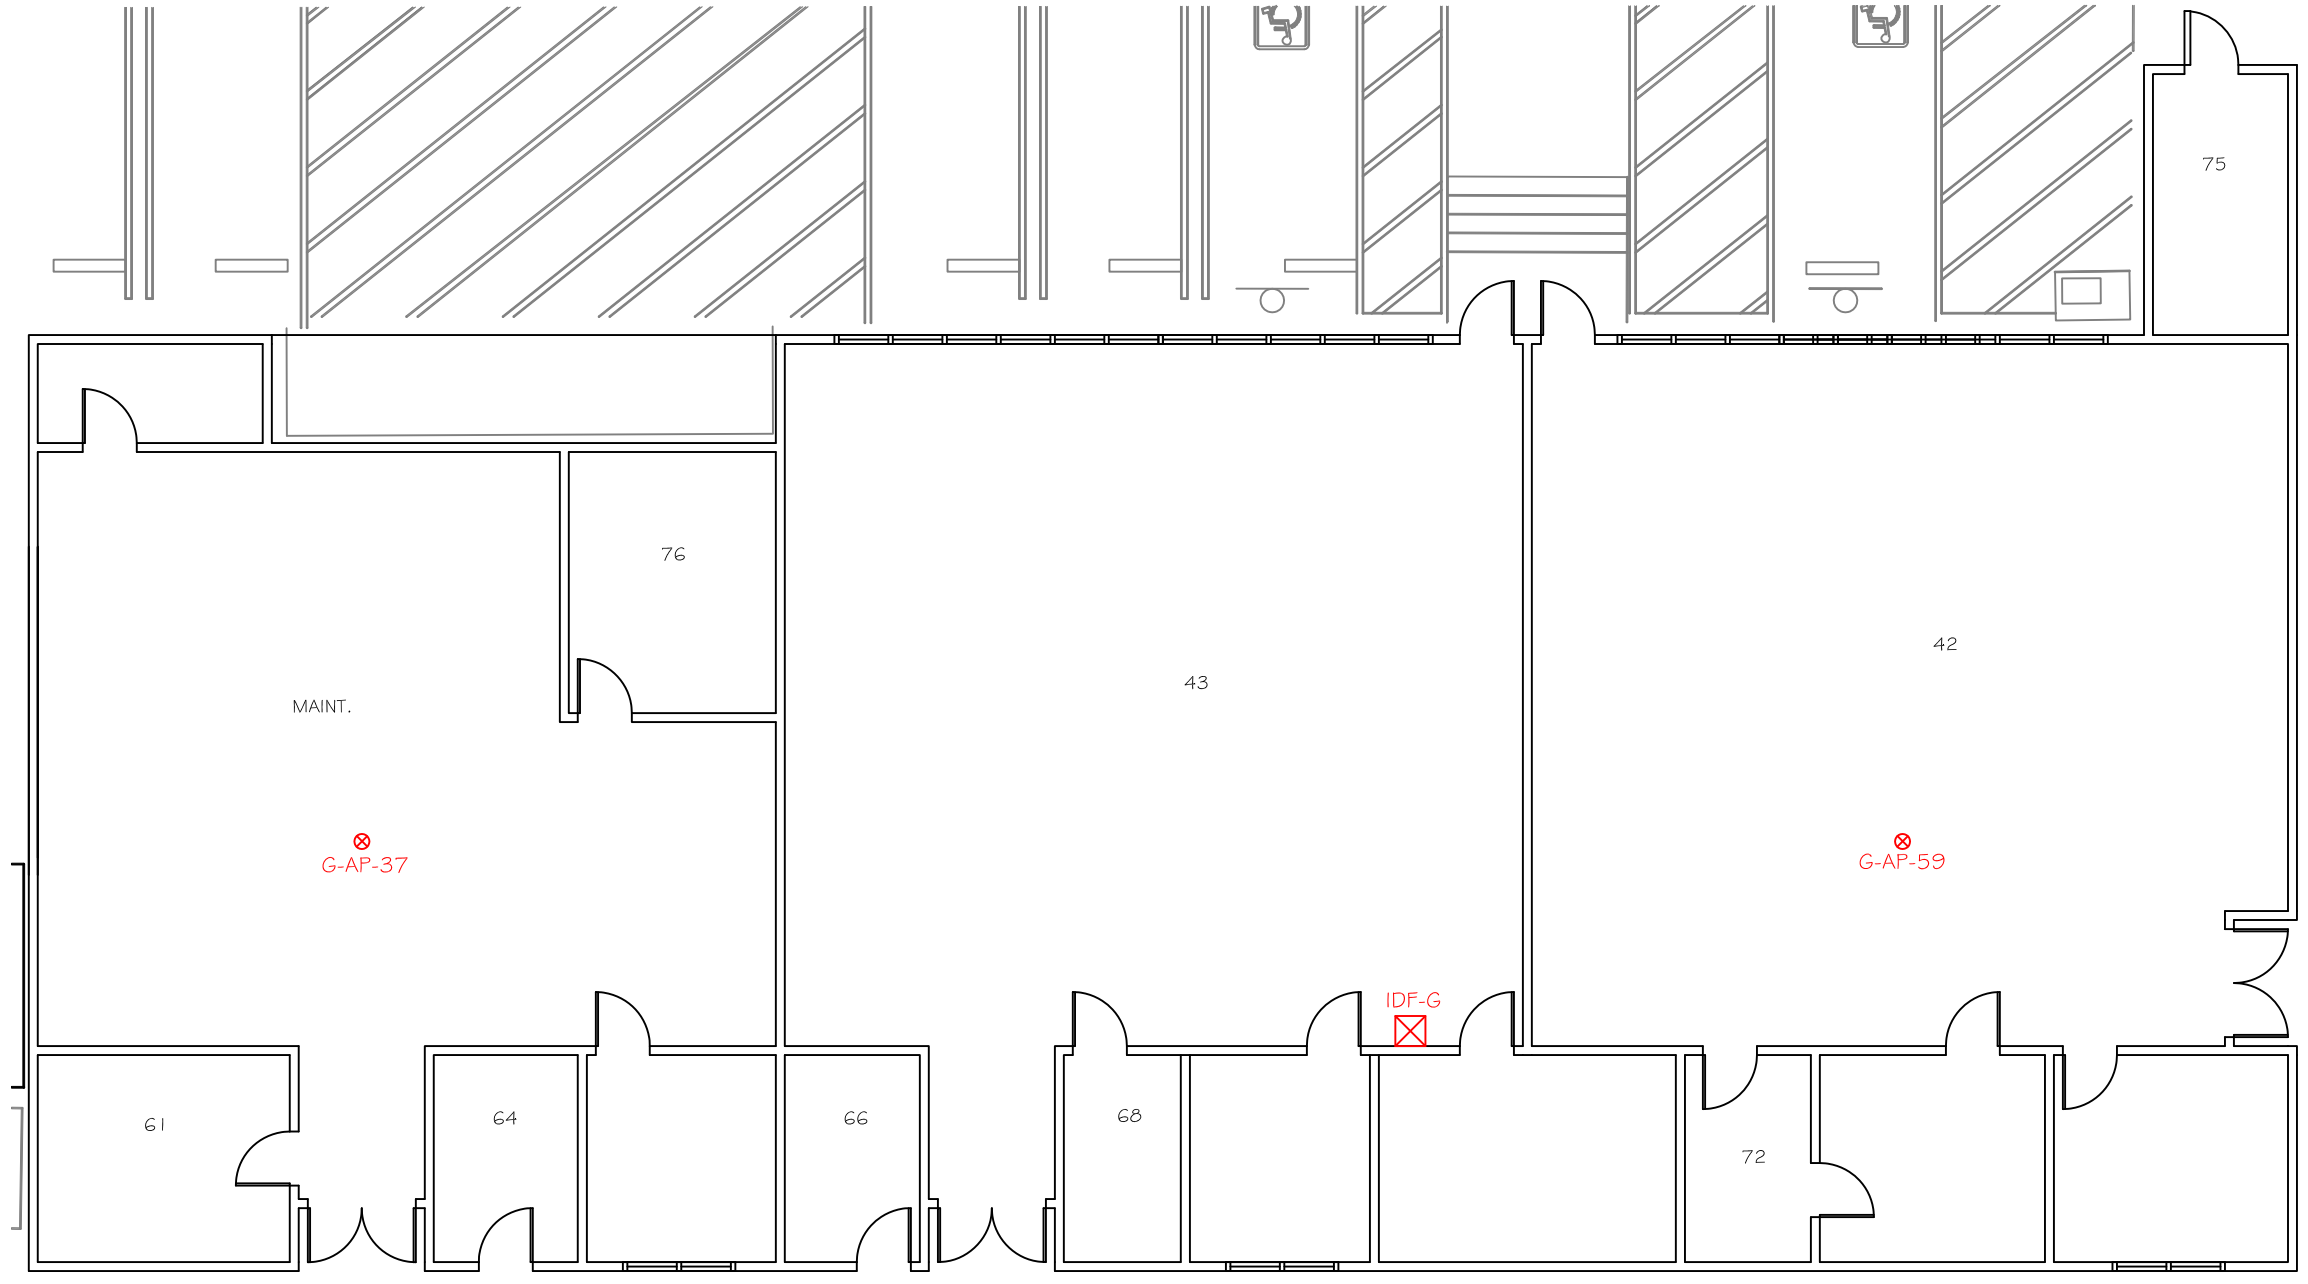

BLDG. G


IDF-G - WIRELESS ACCESS POINT PLAN

SCALE: 3/32" = 1'-0"

LEGEND

⊗ WIRELESS ACCESS POINT

KEYMAP
NTS

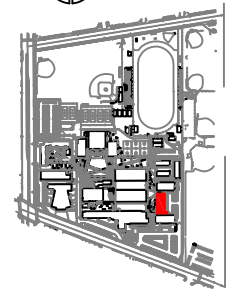

EASYNETWORKS CABLING

3538 SHELLEY WAY
RIVERSIDE, CA. 92503
OFFICE : 951. 742.8119
FAX : 951.742.8125
ST. LIC. # 936770

PREPARED FOR:

EL MONTE UNION HIGH SCHOOL DISTRICT

SITE:

ROSEMEAD HIGH SCHOOL

9063 MISSION DRIVE
ROSEMEAD, CA 91770

AS-BUILT
PROJECT NO. 5231

REVISIONS:

	DATE:	DESCRIPTION:

DRAWN BY:
GERARDO MORALES

DATE: 10/9/12
SCALE: AS SHOWN
SIZE: 11x17

TITLE:

IDF-G WIRELESS ACCESS POINT PLAN


● PROPERTY OF EASY NETWORKS ●
● FOR USE BY EASY NETWORK ONLY ●

SHEET#:

T8

8 OF 17

EASY NETWORKS - 5231 IDF G, 10/17/2012 4:27:42 PM, 11 x 17

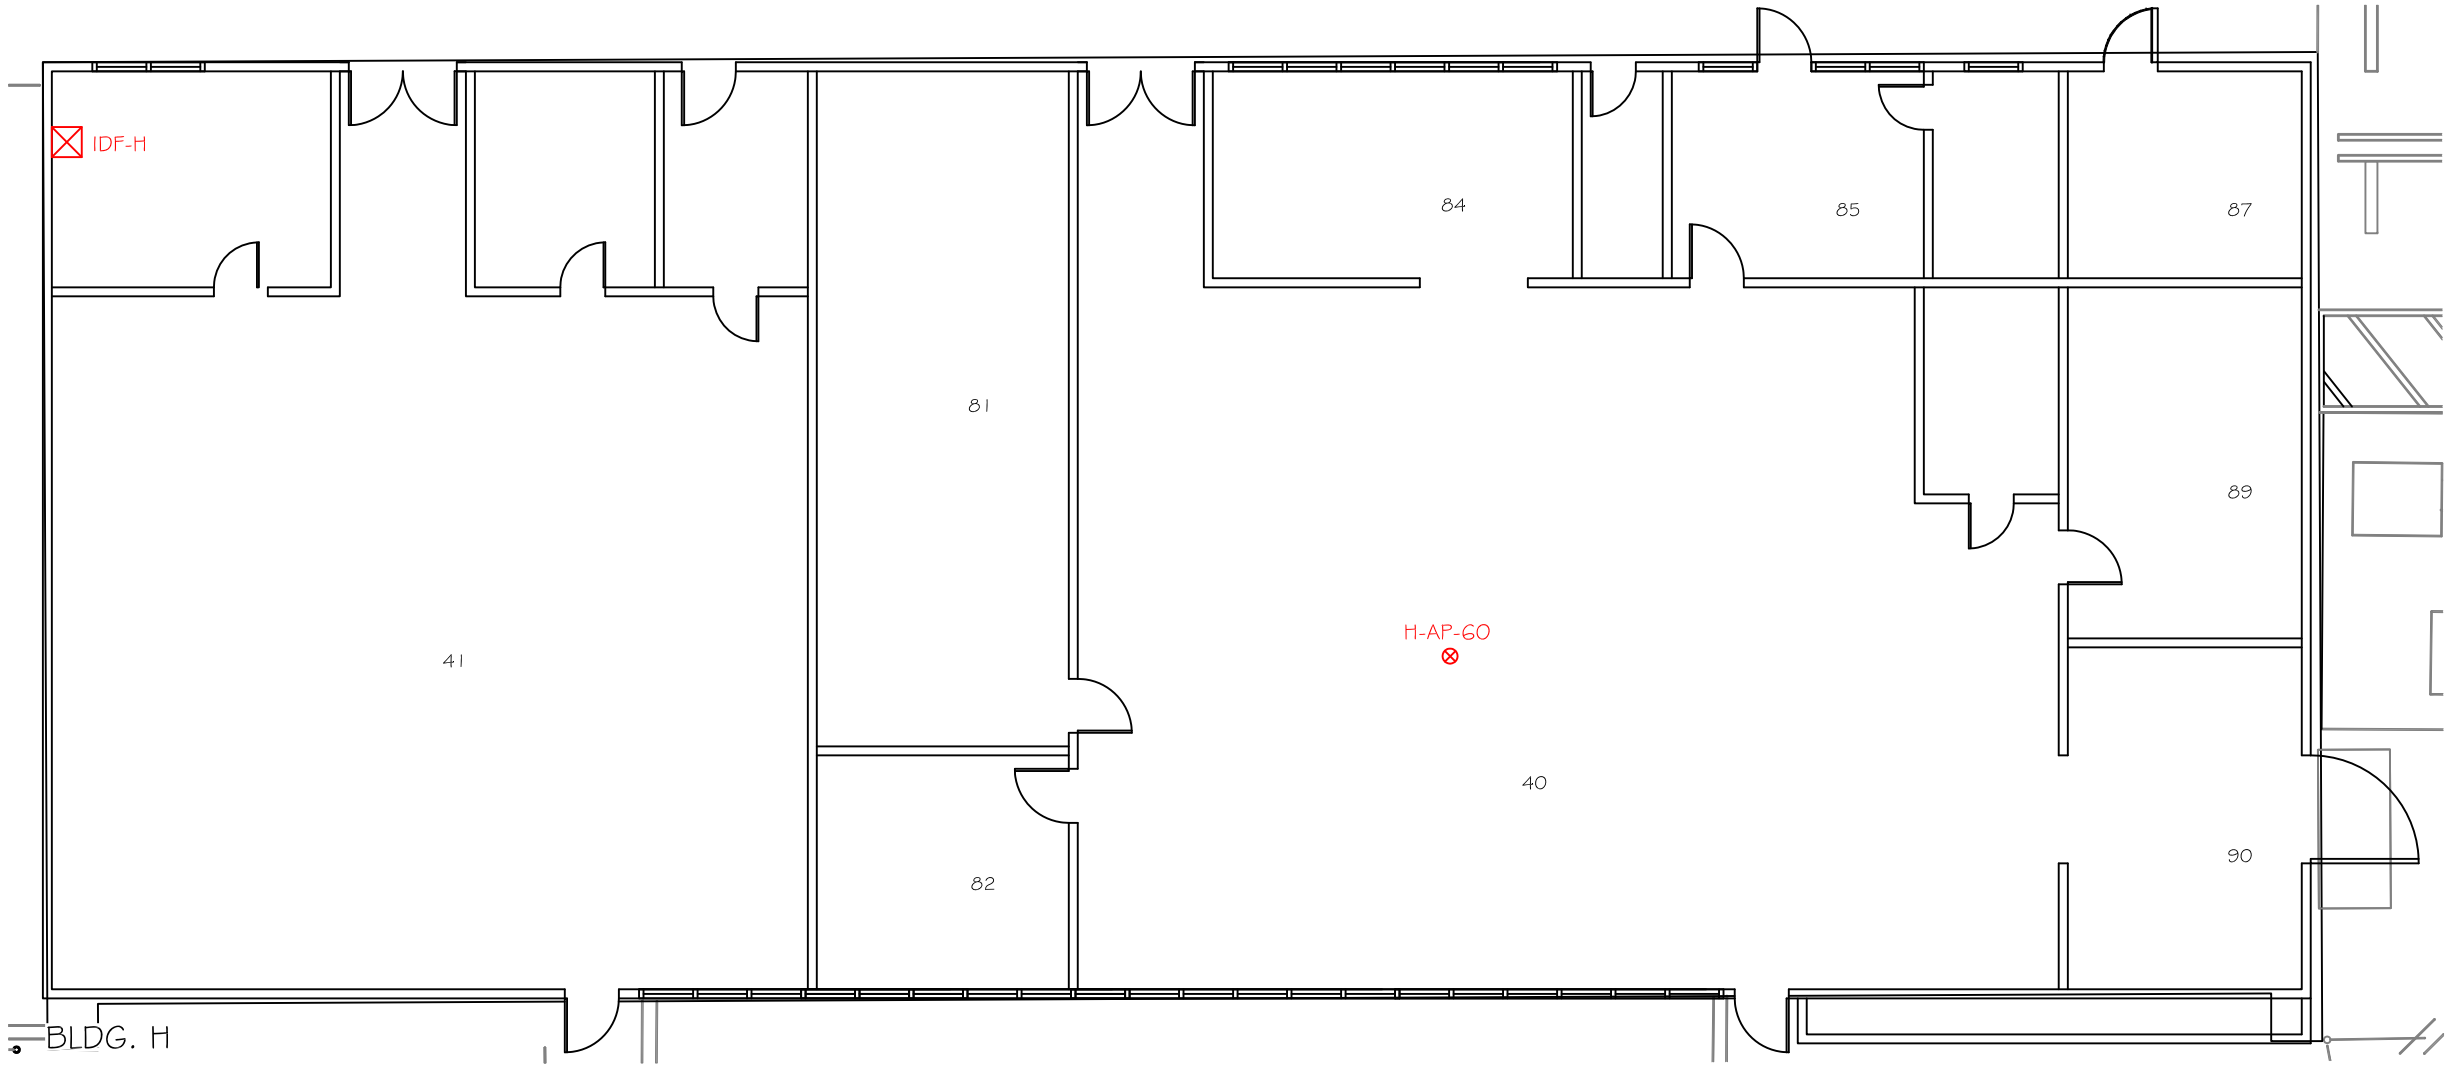


IDF-H - WIRELESS ACCESS POINT PLAN

SCALE: 3/32" = 1'-0"

LEGEND

⊗ WIRELESS ACCESS POINT

KEYMAP
NTS

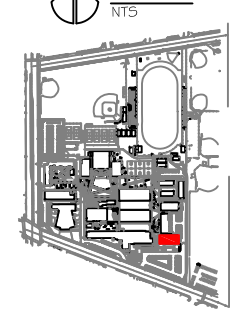

EASYNETWORKS CABLING
3538 SHELLEY WAY
RIVERSIDE, CA. 92503
OFFICE : 951. 742.8119
FAX : 951.742.8125
ST. LIC. # 936770

PREPARED FOR:

EL MONTE UNION HIGH SCHOOL DISTRICT

SITE:

ROSEMEAD HIGH SCHOOL

9063 MISSION DRIVE
ROSEMEAD, CA 91770

AS-BUILT
PROJECT NO. 5231

REVISIONS:

#	DATE:	DESCRIPTION:

DRAWN BY:
GERARDO MORALES

DATE: 10/9/12
SCALE: AS SHOWN
SIZE: 11x17

TITLE:

IDF-H WIRELESS ACCESS POINT PLAN


• PROPERTY OF EASY NETWORKS •
• FOR USE BY EASY NETWORK ONLY •

SHEET#:

T9

9 OF 17

EASY NETWORKS - 5231 IDF H, 10/17/2012 4:28:01 PM, 11 x 17

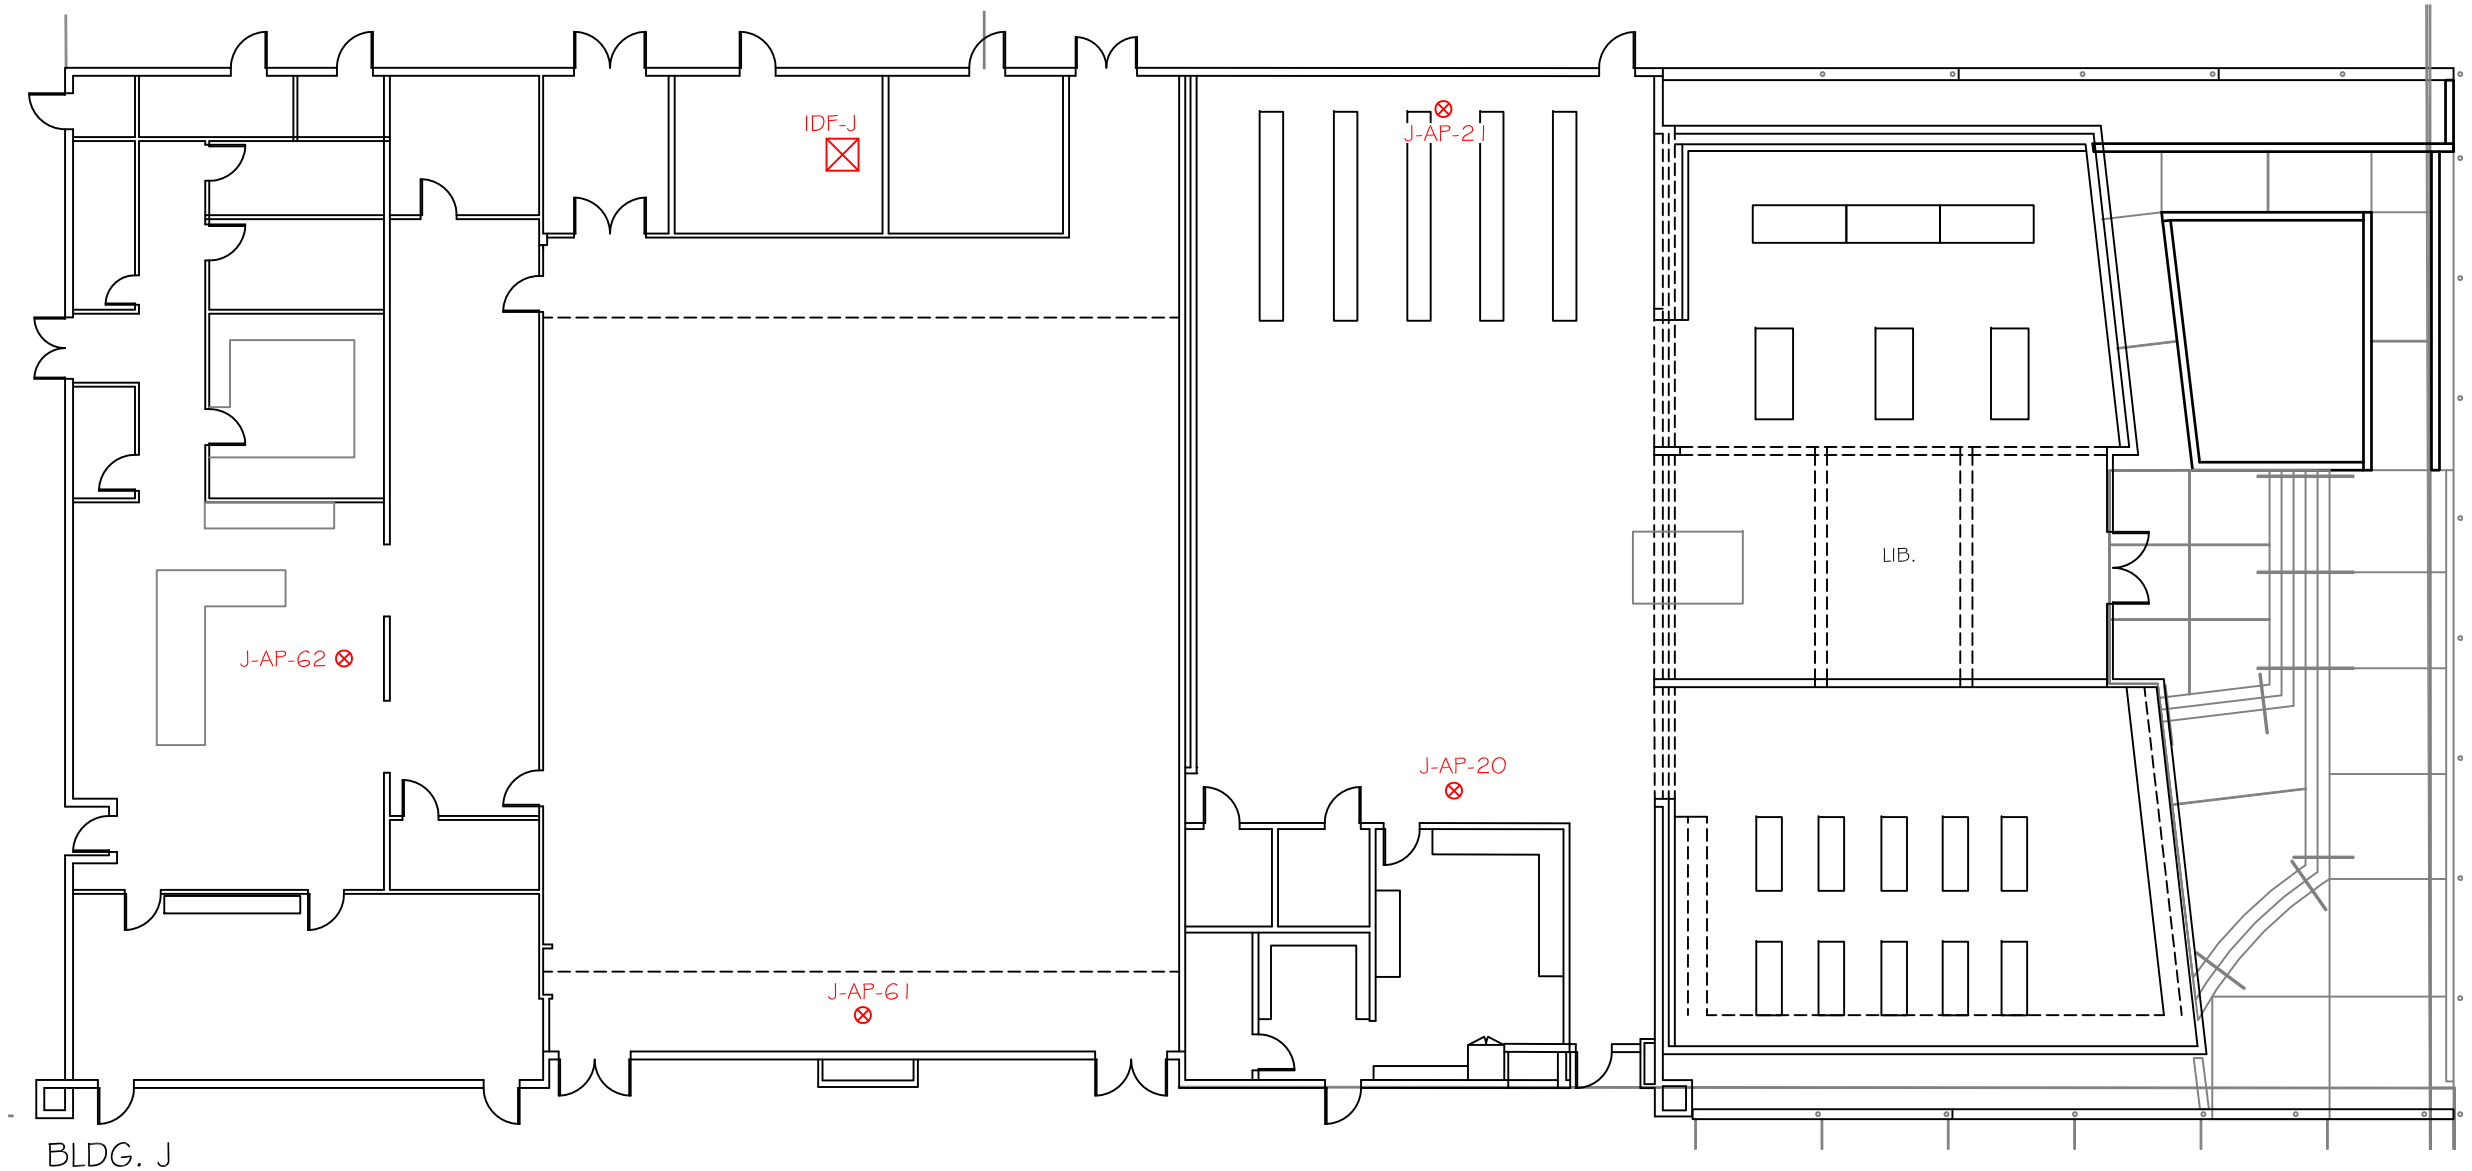


IDF-J - WIRELESS ACCESS POINT PLAN

SCALE: 1/16" = 1'-0"

LEGEND

⊗ WIRELESS ACCESS POINT

KEYMAP
NTS

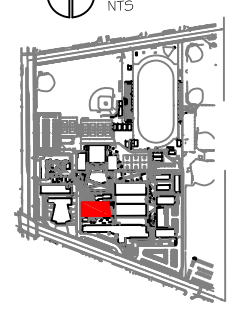

EASYNETWORKS CABLING
3538 SHELLEY WAY
RIVERSIDE, CA. 92503
OFFICE : 951. 742.8119
FAX : 951.742.8125
ST. LIC. # 936770

PREPARED FOR:

EL MONTE UNION HIGH SCHOOL DISTRICT

SITE:

ROSEMEAD HIGH SCHOOL

9063 MISSION DRIVE
ROSEMEAD, CA 91770

AS-BUILT
PROJECT NO. 5231

REVISIONS:

	DATE:	DESCRIPTION:

DRAWN BY:
GERARDO MORALES

DATE: 10/9/12
SCALE: AS SHOWN
SIZE: 11x17

TITLE:

IDF-J WIRELESS ACCESS POINT PLAN


● PROPERTY OF EASY NETWORKS ●
● FOR USE BY EASY NETWORK ONLY ●

SHEET#:

T10

10 OF 17

EASY NETWORKS - 5231 IDF J, 10/17/2012 4:28:11 PM, 11 x 17

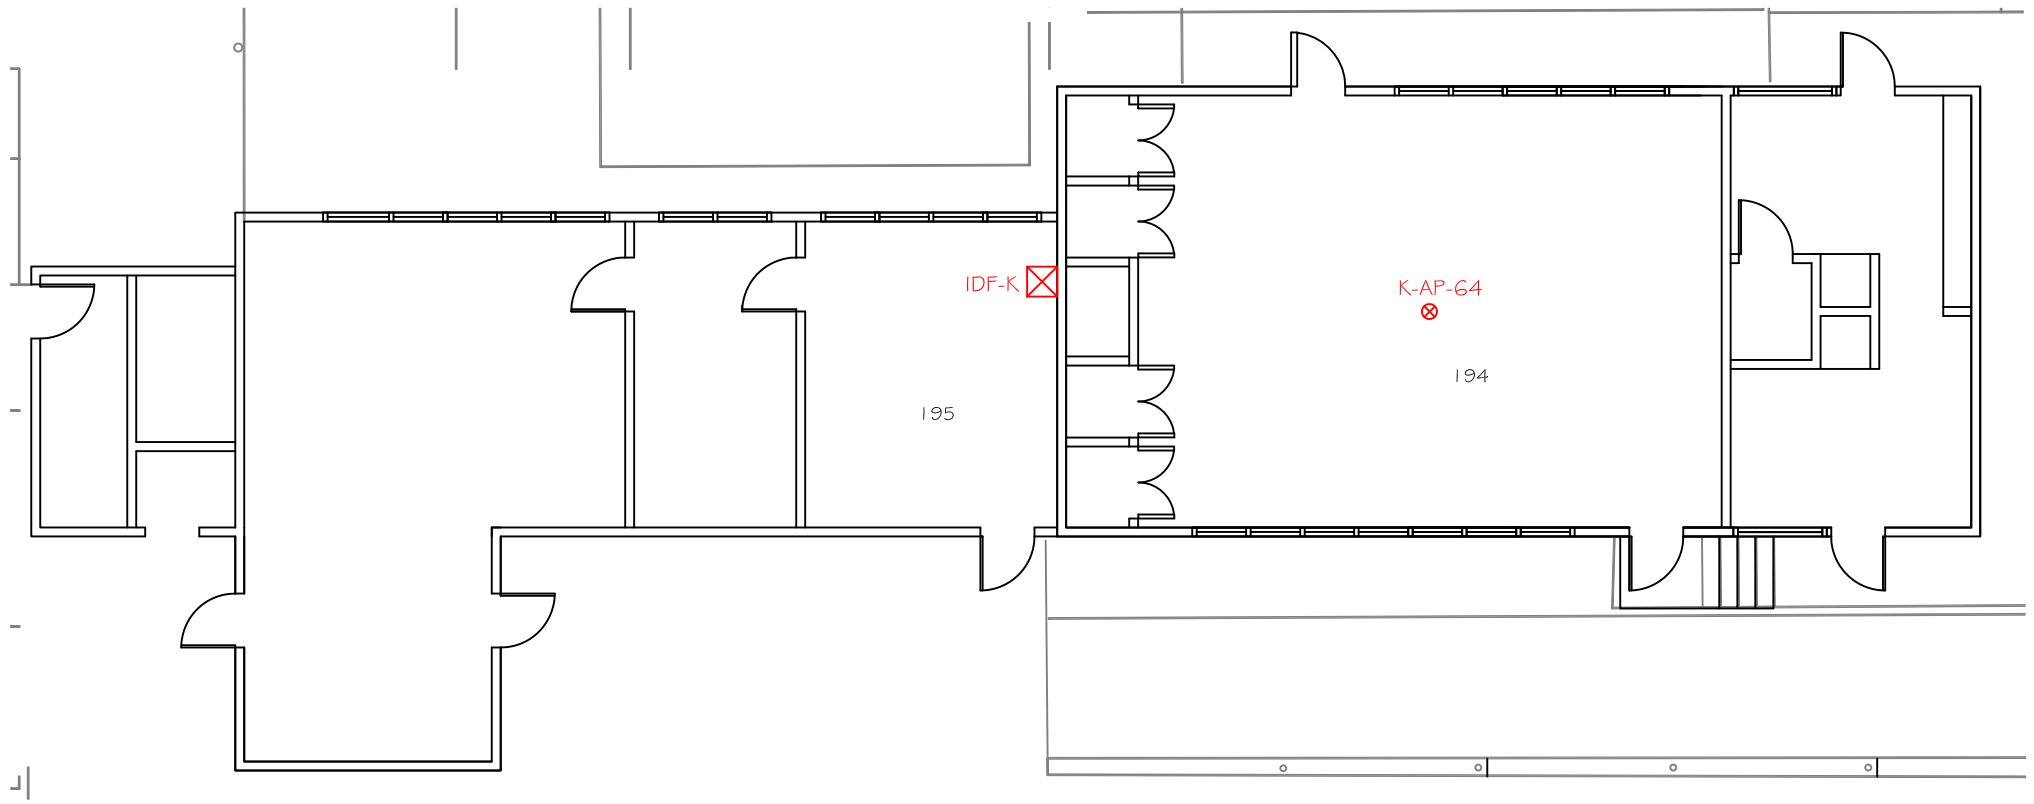


IDF-K - WIRELESS ACCESS POINT PLAN
SCALE: 3/32" = 1'-0"

LEGEND

⊗ WIRELESS ACCESS POINT

KEYMAP
NTS

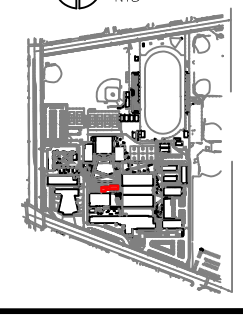

EASYNETWORKS CABLING
3538 SHELLEY WAY
RIVERSIDE, CA. 92503
OFFICE : 951. 742.8119
FAX : 951.742.8125
ST. LIC. # 936770

PREPARED FOR:
EL MONTE UNION HIGH SCHOOL DISTRICT

SITE:
ROSEMEAD HIGH SCHOOL

9063 MISSION DRIVE
ROSEMEAD, CA 91770

AS-BUILT
PROJECT NO. 5231

REVISIONS:

	DATE:	DESCRIPTION:
1		

DRAWN BY:
GERARDO MORALES


DATE: 10/9/12
SCALE: AS SHOWN
SIZE: 11x17

TITLE:
IDF-K WIRELESS ACCESS POINT PLAN

● PROPERTY OF EASY NETWORKS ●
● FOR USE BY EASY NETWORK ONLY ●

SHEET#:
T11
11 OF 17

EASY NETWORKS - 5231 IDF K, 10/17/2012 4:28:23 PM, 11 x 17

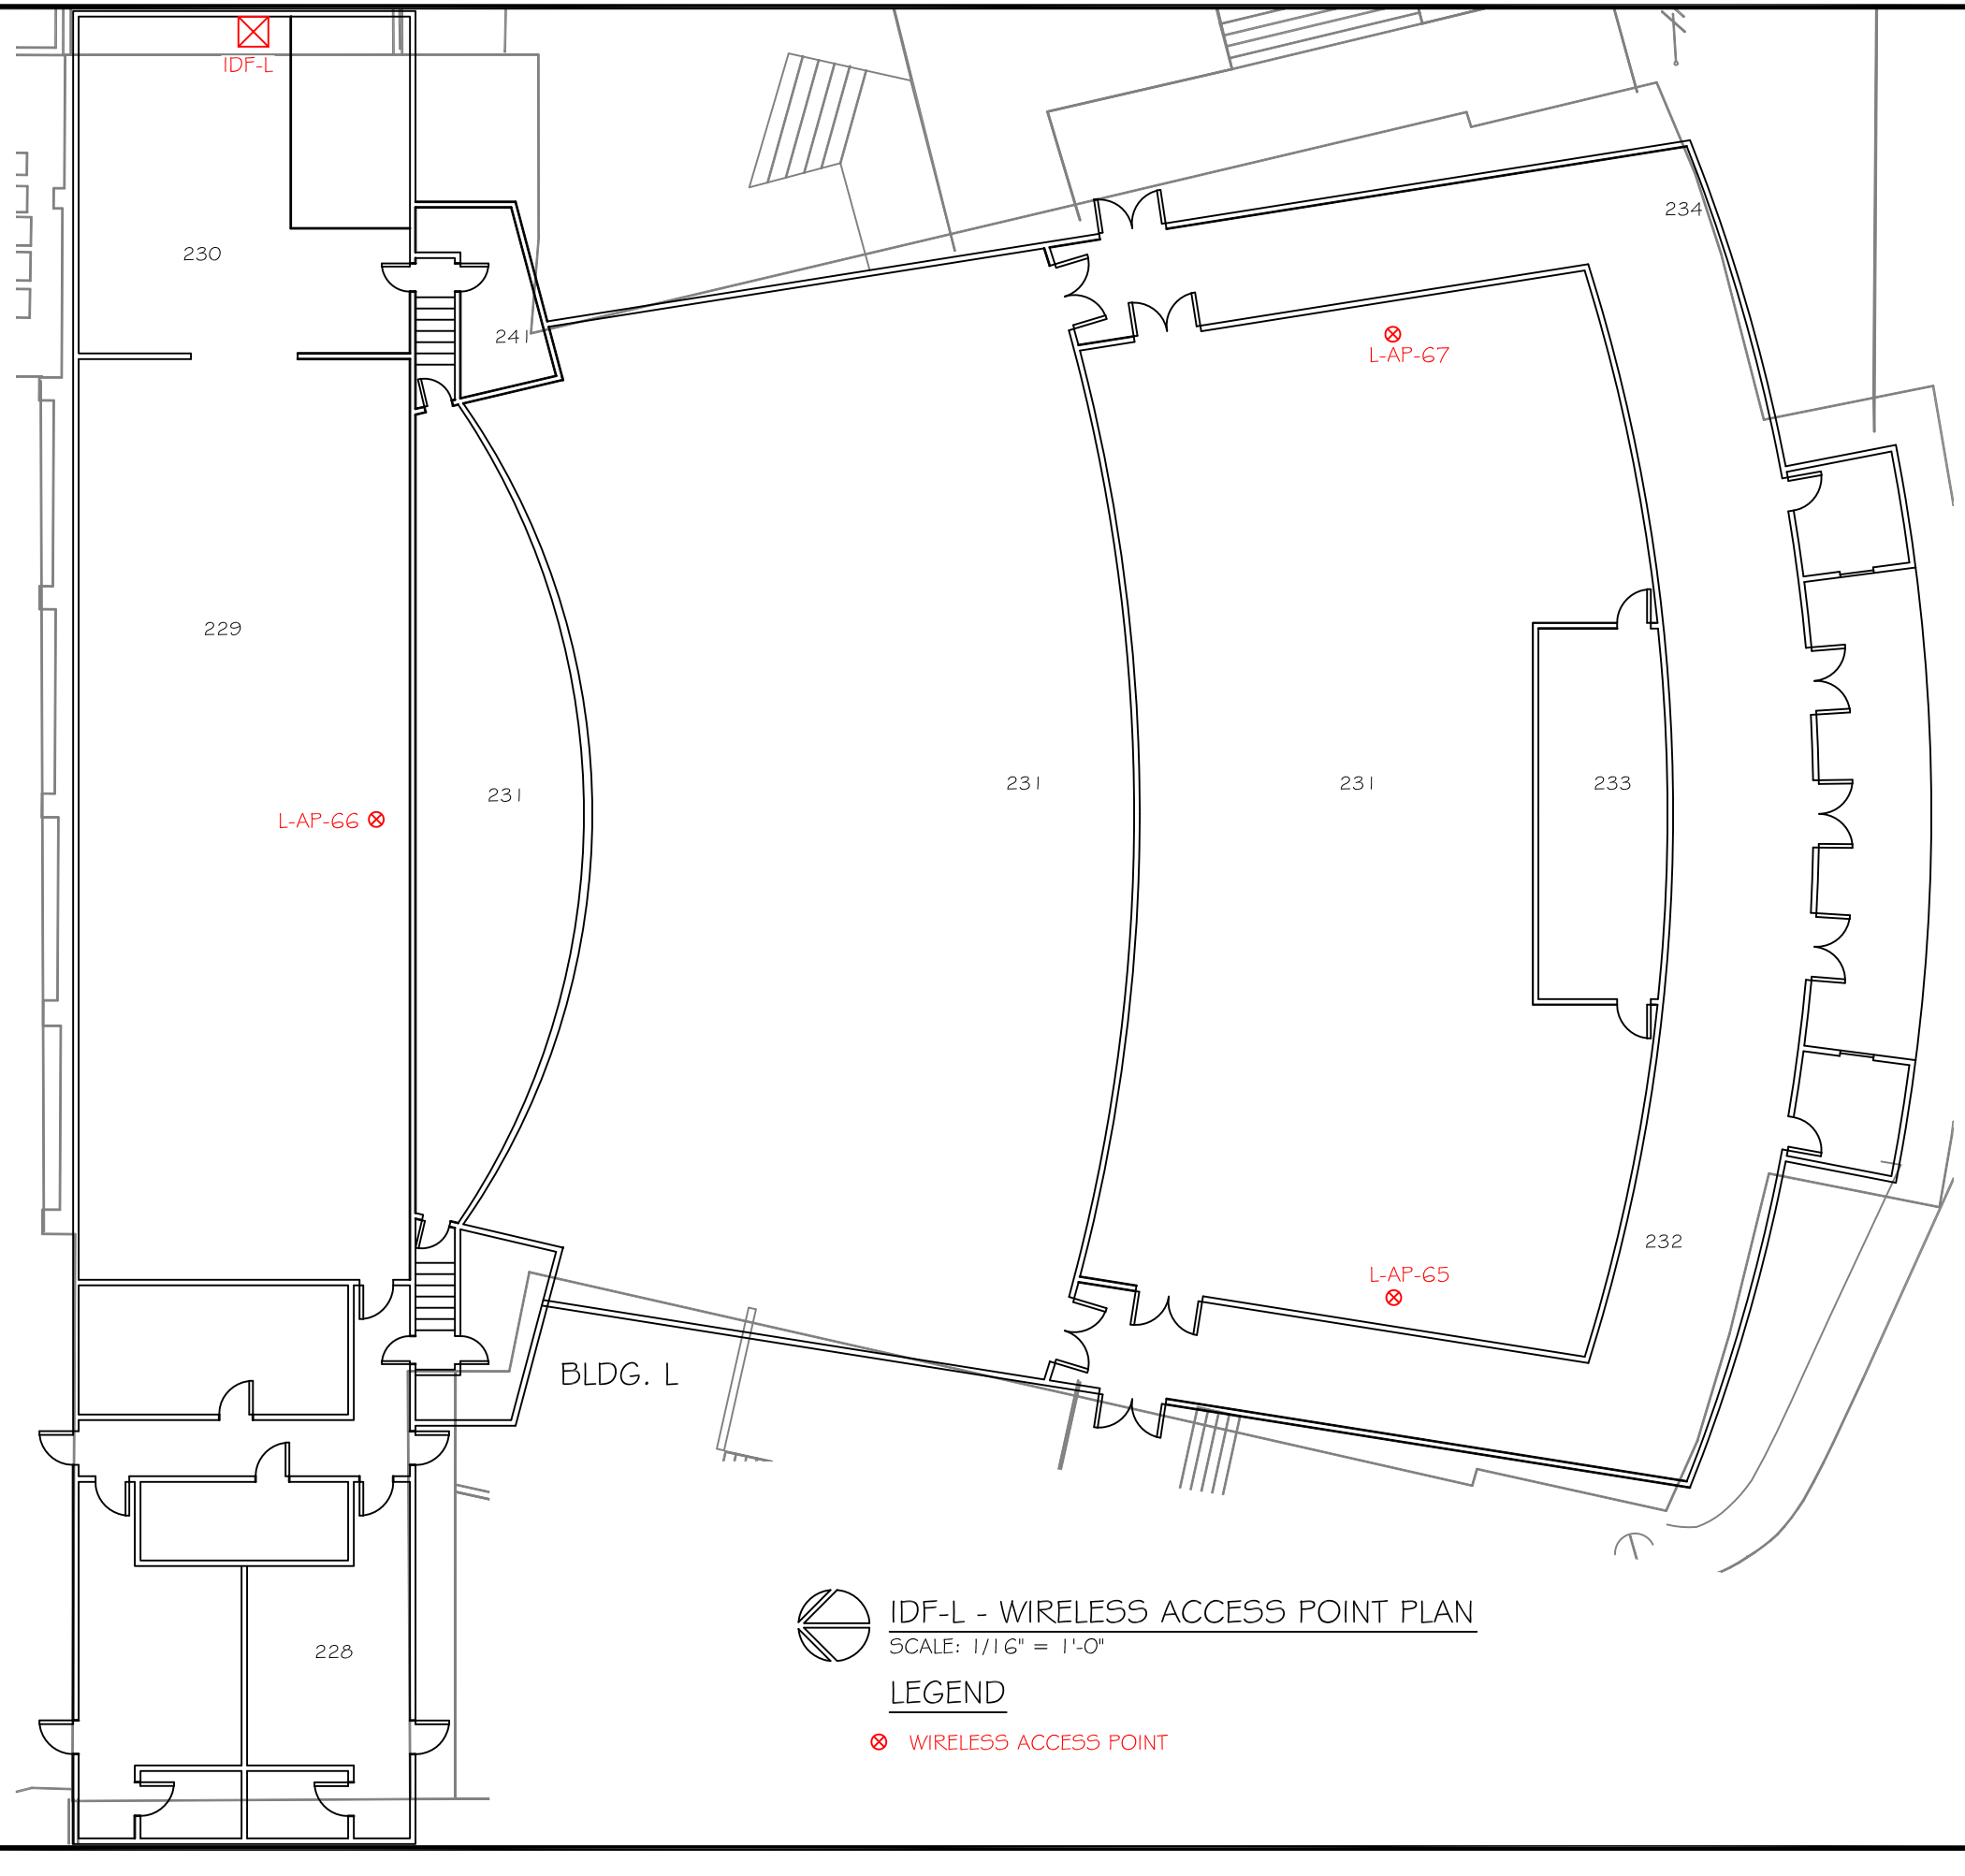


IDF-L - WIRELESS ACCESS POINT PLAN

SCALE: 1/16" = 1'-0"

LEGEND

⊗ WIRELESS ACCESS POINT

KEYMAP NTS

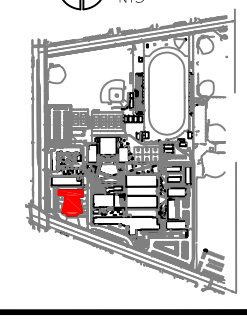

EASYNETWORKS CABLING

3538 SHELLEY WAY
RIVERSIDE, CA. 92503
OFFICE : 951. 742.8119
FAX : 951.742.8125
ST. LIC. # 936770

PREPARED FOR:

EL MONTE UNION HIGH SCHOOL DISTRICT

SITE:

ROSEMEAD HIGH SCHOOL

9063 MISSION DRIVE
ROSEMEAD, CA 91770

AS-BUILT
PROJECT NO. 5231

REVISIONS:

	DATE:	DESCRIPTION:

DRAWN BY: GERARDO MORALES

DATE: 10/9/12
SCALE: AS SHOWN
SIZE: 11x17

TITLE:

IDF-L WIRELESS ACCESS POINT PLAN


● PROPERTY OF EASY NETWORKS ●
● FOR USE BY EASY NETWORK ONLY ●

SHEET#:

T12

12 OF 17

EASY NETWORKS - 5231 IDF L, 10/17/2012 4:28:38 PM, 11 x 17

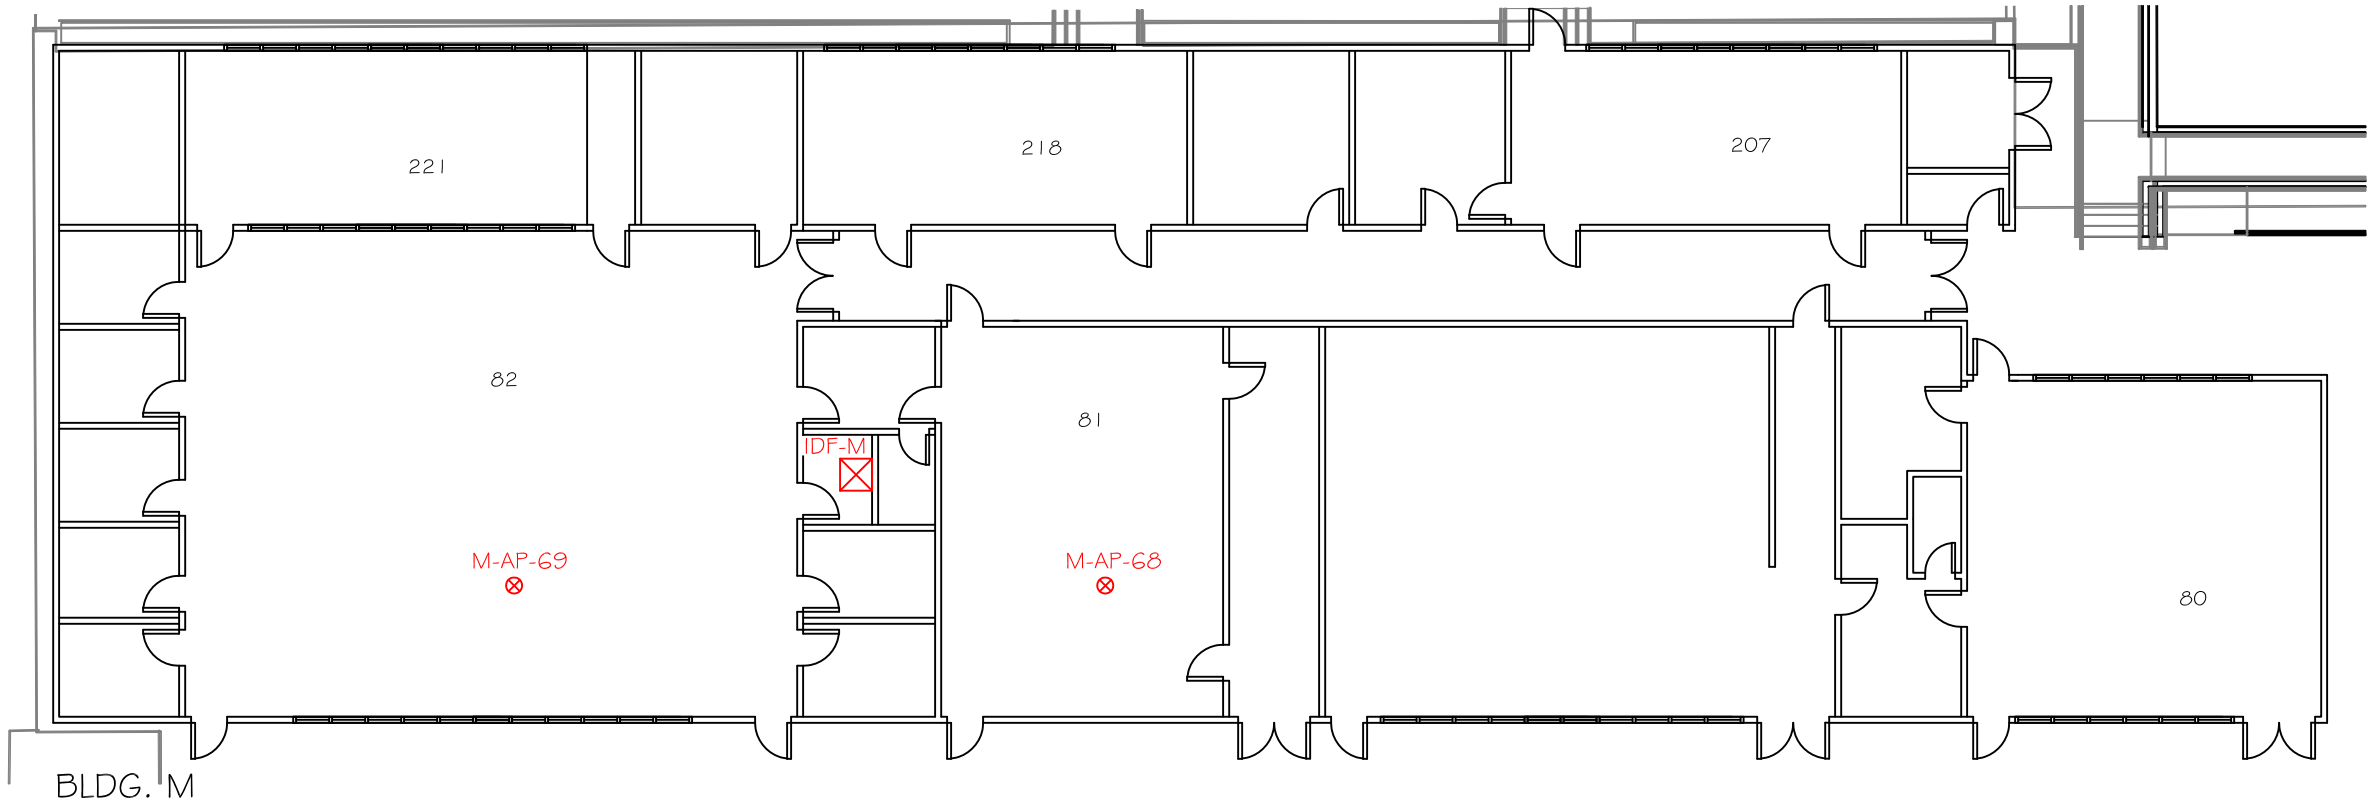


IDF-M - WIRELESS ACCESS POINT PLAN

SCALE: 1/16" = 1'-0"

LEGEND

⊗ WIRELESS ACCESS POINT

KEYMAP
NTS

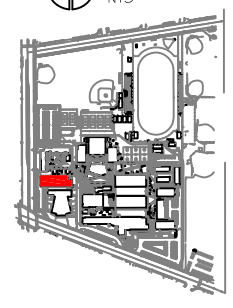

EASYNETWORKS CABLING
3538 SHELLEY WAY
RIVERSIDE, CA. 92503
OFFICE : 951. 742.8119
FAX : 951.742.8125
ST. LIC. # 936770

PREPARED FOR:

EL MONTE UNION HIGH SCHOOL DISTRICT

SITE:

ROSEMEAD HIGH SCHOOL

9063 MISSION DRIVE
ROSEMEAD, CA 91770

AS-BUILT
PROJECT NO. 5231

REVISIONS:

	DATE:	DESCRIPTION:

DRAWN BY:
GERARDO MORALES

DATE: 10/9/12
SCALE: AS SHOWN
SIZE: 11x17

TITLE:

IDF-M WIRELESS ACCESS POINT PLAN


● PROPERTY OF EASY NETWORKS ●
● FOR USE BY EASY NETWORK ONLY ●

SHEET#:

T13

13 OF 17

EASY NETWORKS - 5231 IDF M, 10/17/2012 4:28:58 PM, 11 x 17

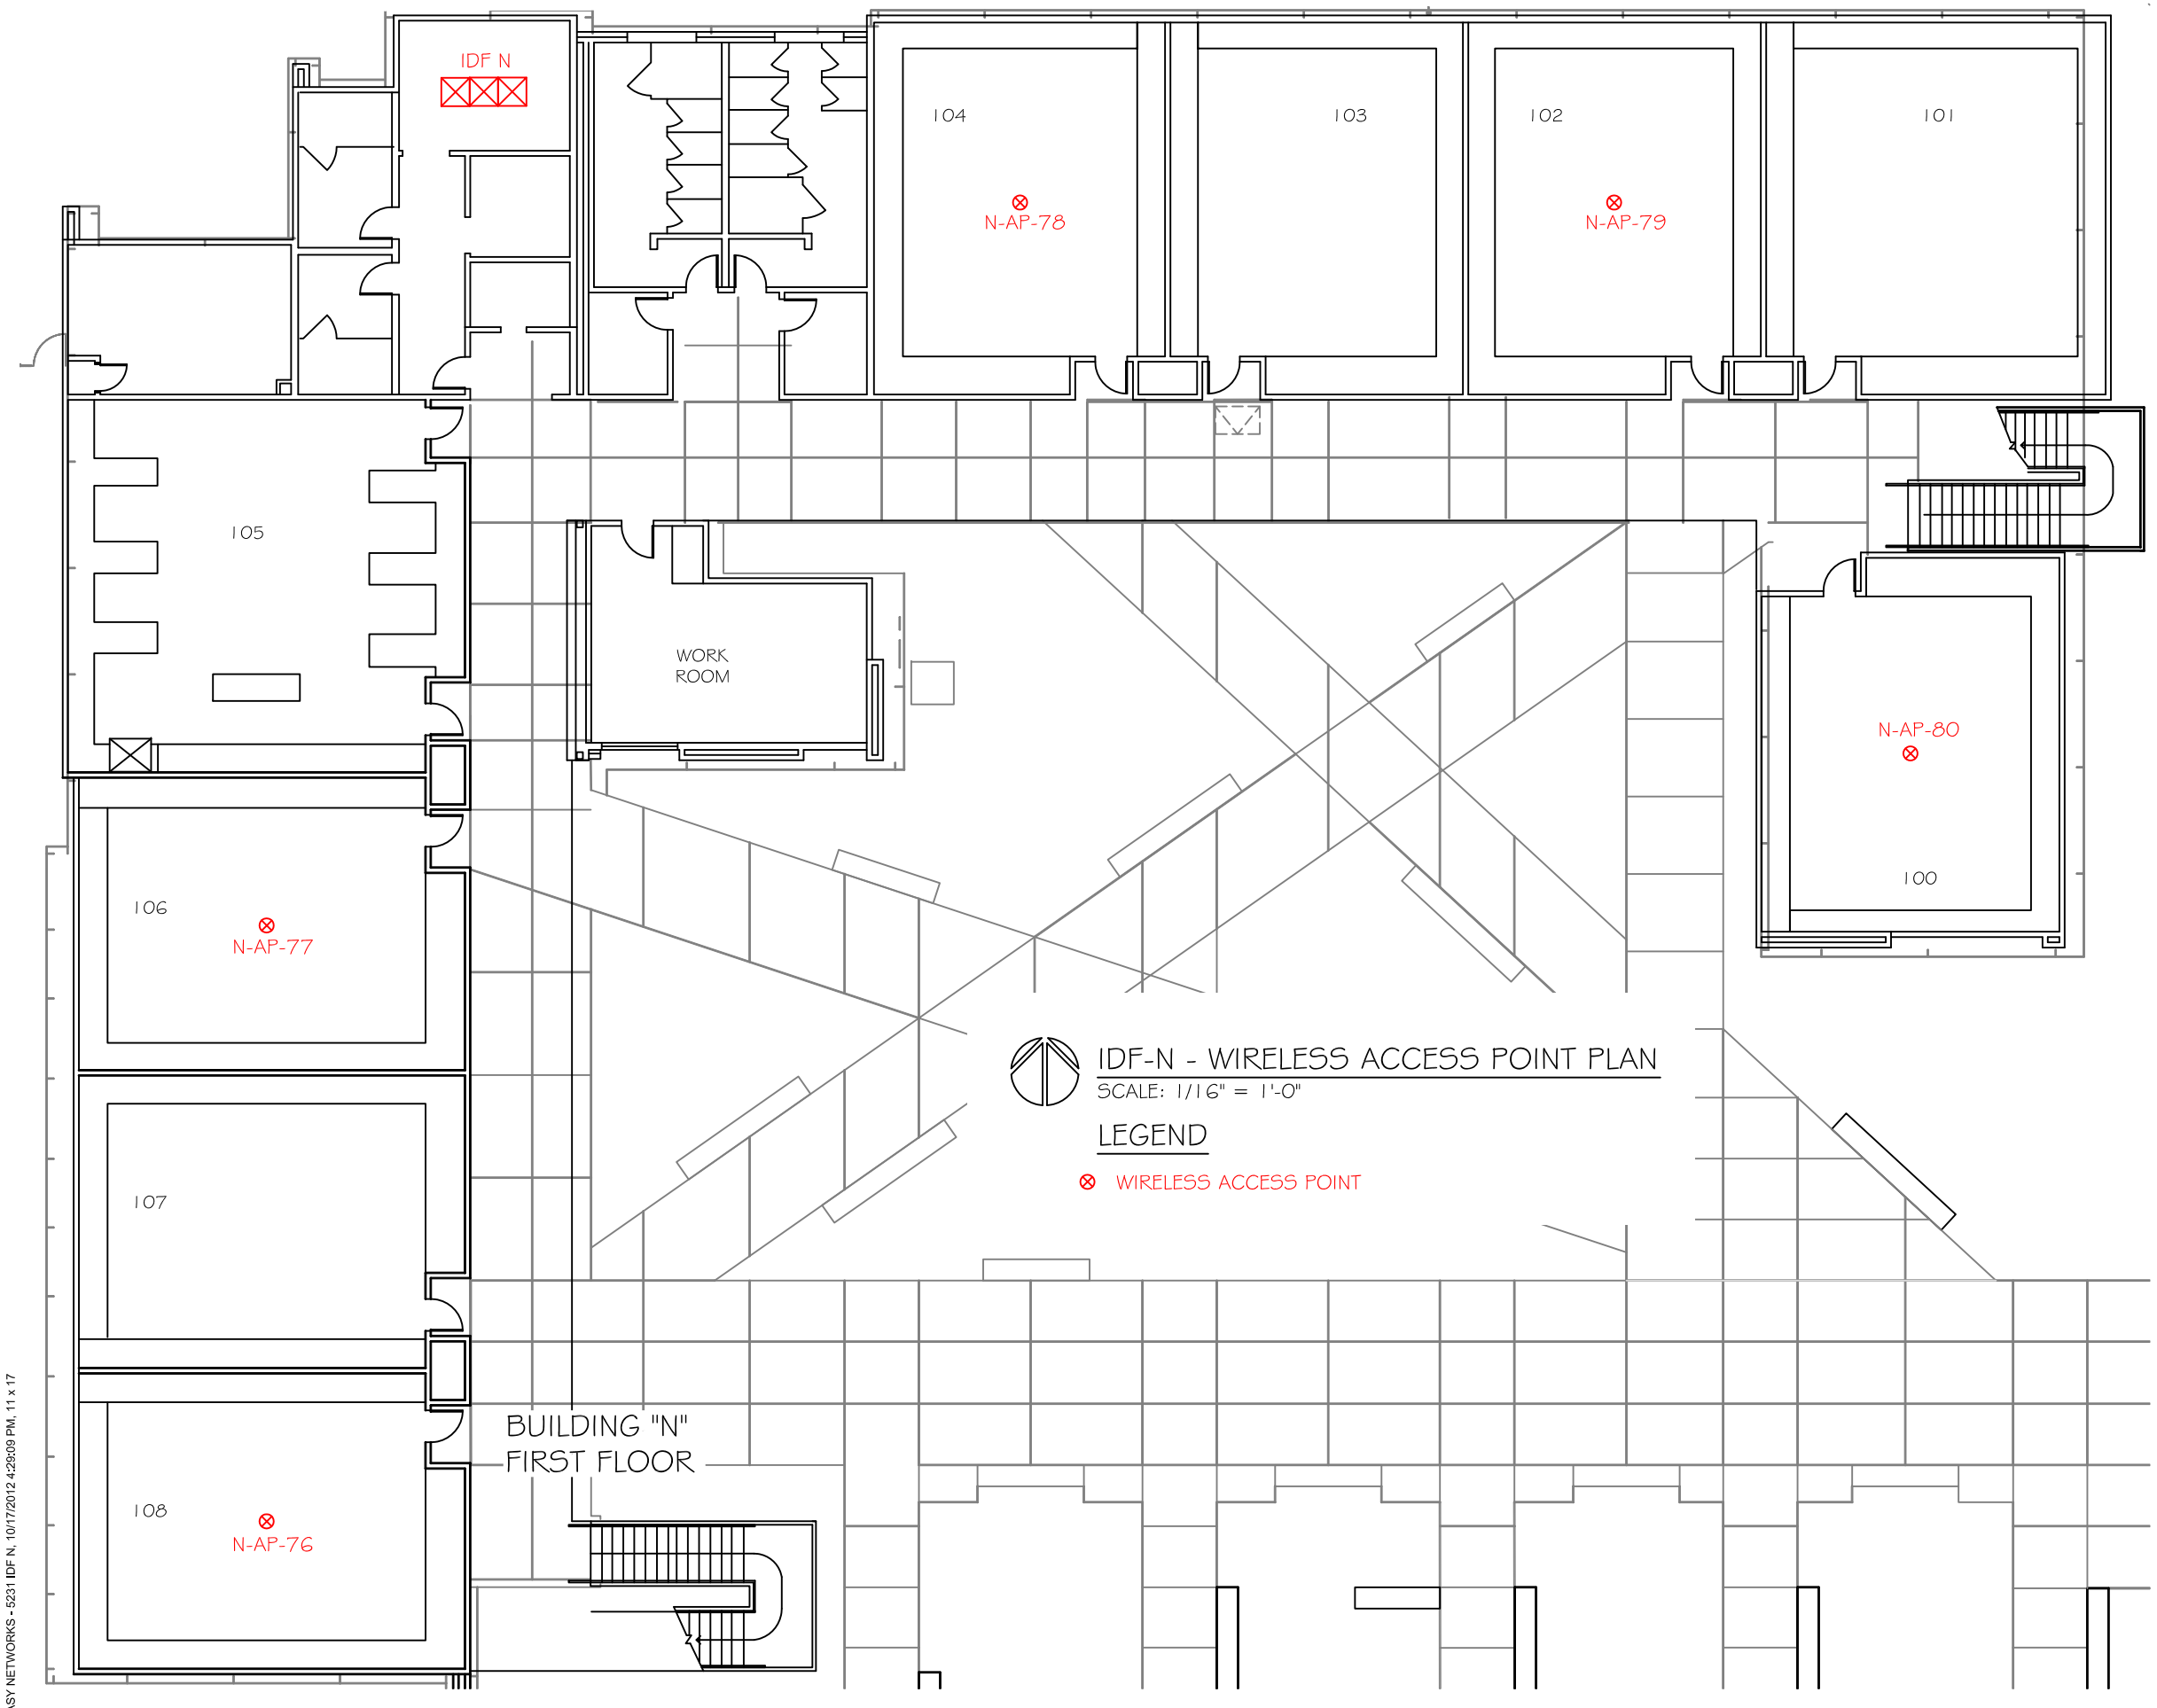


IDF-N - WIRELESS ACCESS POINT PLAN

SCALE: 1/16" = 1'-0"

LEGEND

⊗ WIRELESS ACCESS POINT

KEYMAP
NTS

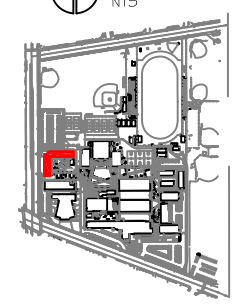

EASYNETWORKS CABLING
3538 SHELLEY WAY
RIVERSIDE, CA. 92503
OFFICE : 951. 742.8119
FAX : 951.742.8125
ST. LIC. # 936770

PREPARED FOR:

EL MONTE UNION HIGH SCHOOL DISTRICT

SITE:

ROSEMEAD HIGH SCHOOL

9063 MISSION DRIVE
ROSEMEAD, CA 91770

AS-BUILT
PROJECT NO. 5231

REVISIONS:

	DATE:	DESCRIPTION:

DRAWN BY:
GERARDO MORALES

DATE: 10/9/12
SCALE: AS SHOWN
SIZE: 11x17

TITLE:

IDF-N WIRELESS ACCESS POINT PLAN


•PROPERTY OF EASY NETWORKS•
•FOR USE BY EASY NETWORK ONLY•

SHEET#:

T14

14 OF 17

EASY NETWORKS - 5231 IDF N, 10/17/2012 4:29:09 PM, 11 x 17

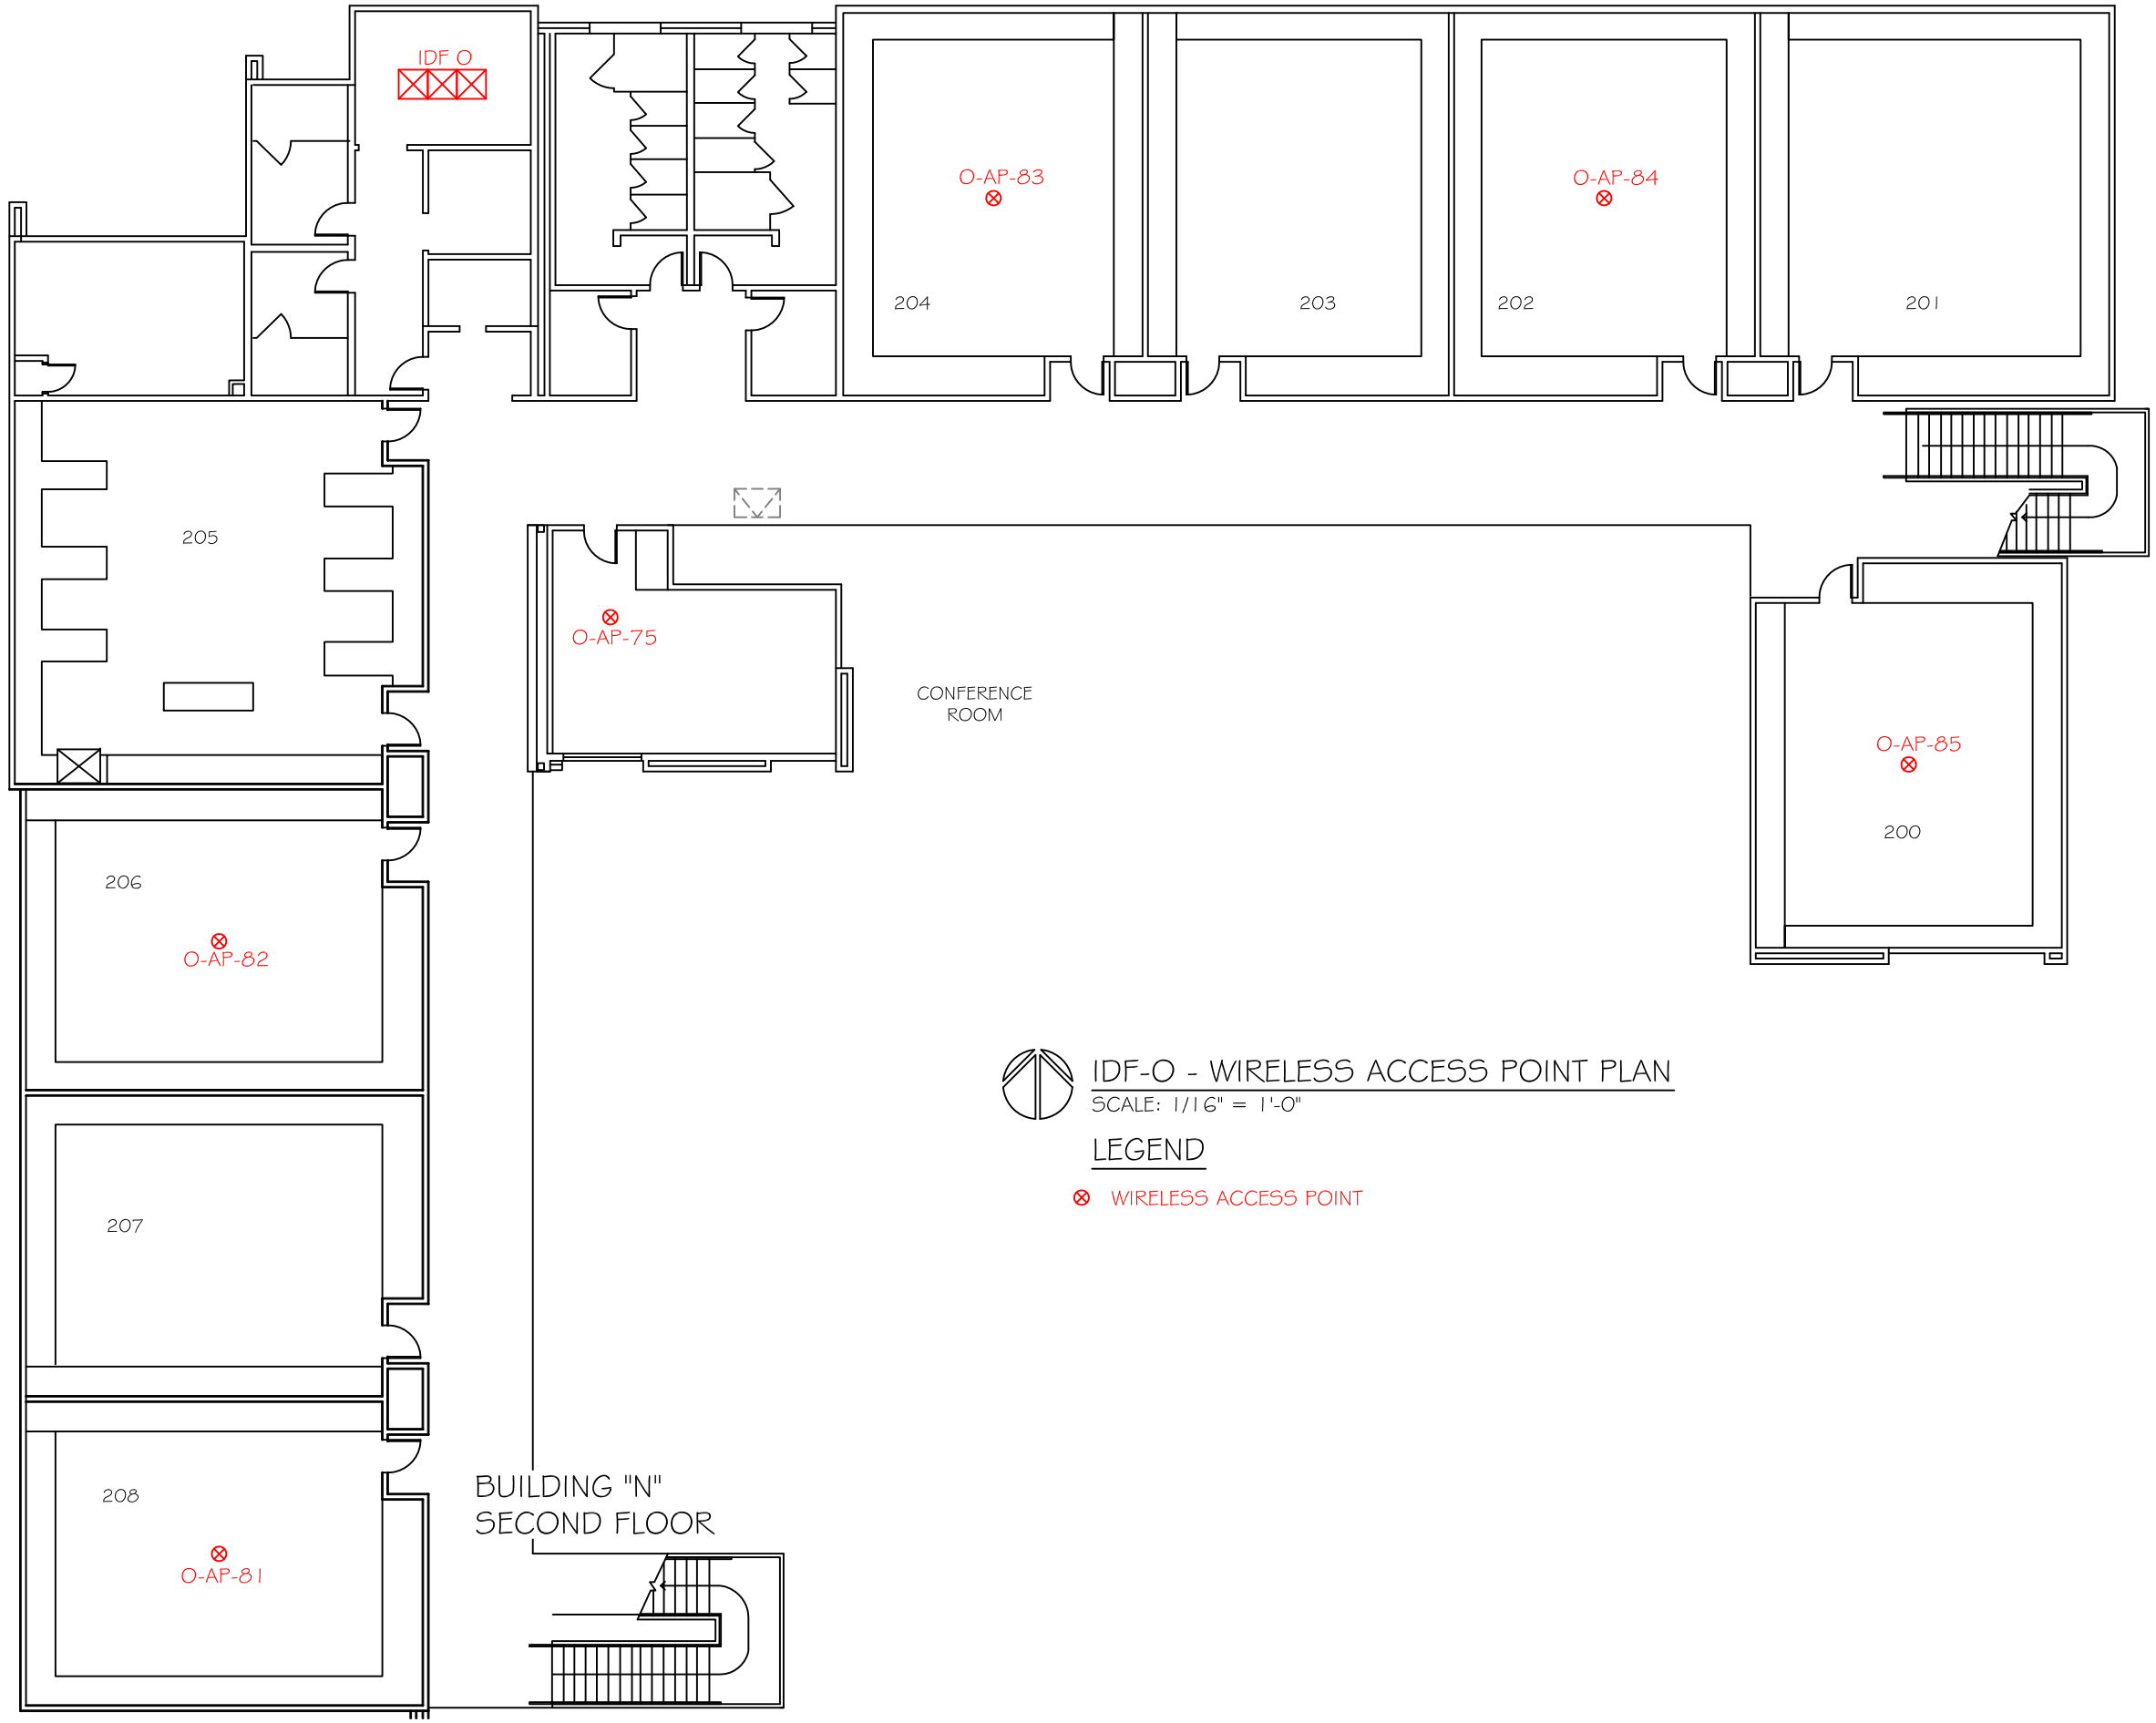


IDF-O - WIRELESS ACCESS POINT PLAN

SCALE: 1/16" = 1'-0"

LEGEND

⊗ WIRELESS ACCESS POINT

KEYMAP
NTS

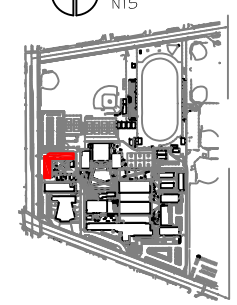

EASYNETWORKS CABLING
3538 SHELLEY WAY
RIVERSIDE, CA. 92503
OFFICE : 951. 742.8119
FAX : 951.742.8125
ST. LIC. # 936770

PREPARED FOR:

EL MONTE UNION HIGH SCHOOL DISTRICT

SITE:

ROSEMEAD HIGH SCHOOL

9063 MISSION DRIVE
ROSEMEAD, CA 91770

AS-BUILT
PROJECT NO. 5231

REVISIONS:

	DATE:	DESCRIPTION:
1		

DRAWN BY: GERARDO MORALES

DATE: 10/9/12
SCALE: AS SHOWN
SIZE: 11x17

TITLE:

IDF-O WIRELESS ACCESS POINT PLAN


•PROPERTY OF EASY NETWORKS•
•FOR USE BY EASY NETWORK ONLY•

SHEET#:

T15

15 OF 17

EASY NETWORKS - 5231 IDF O, 10/17/2012 4:29:26 PM, 11 x 17

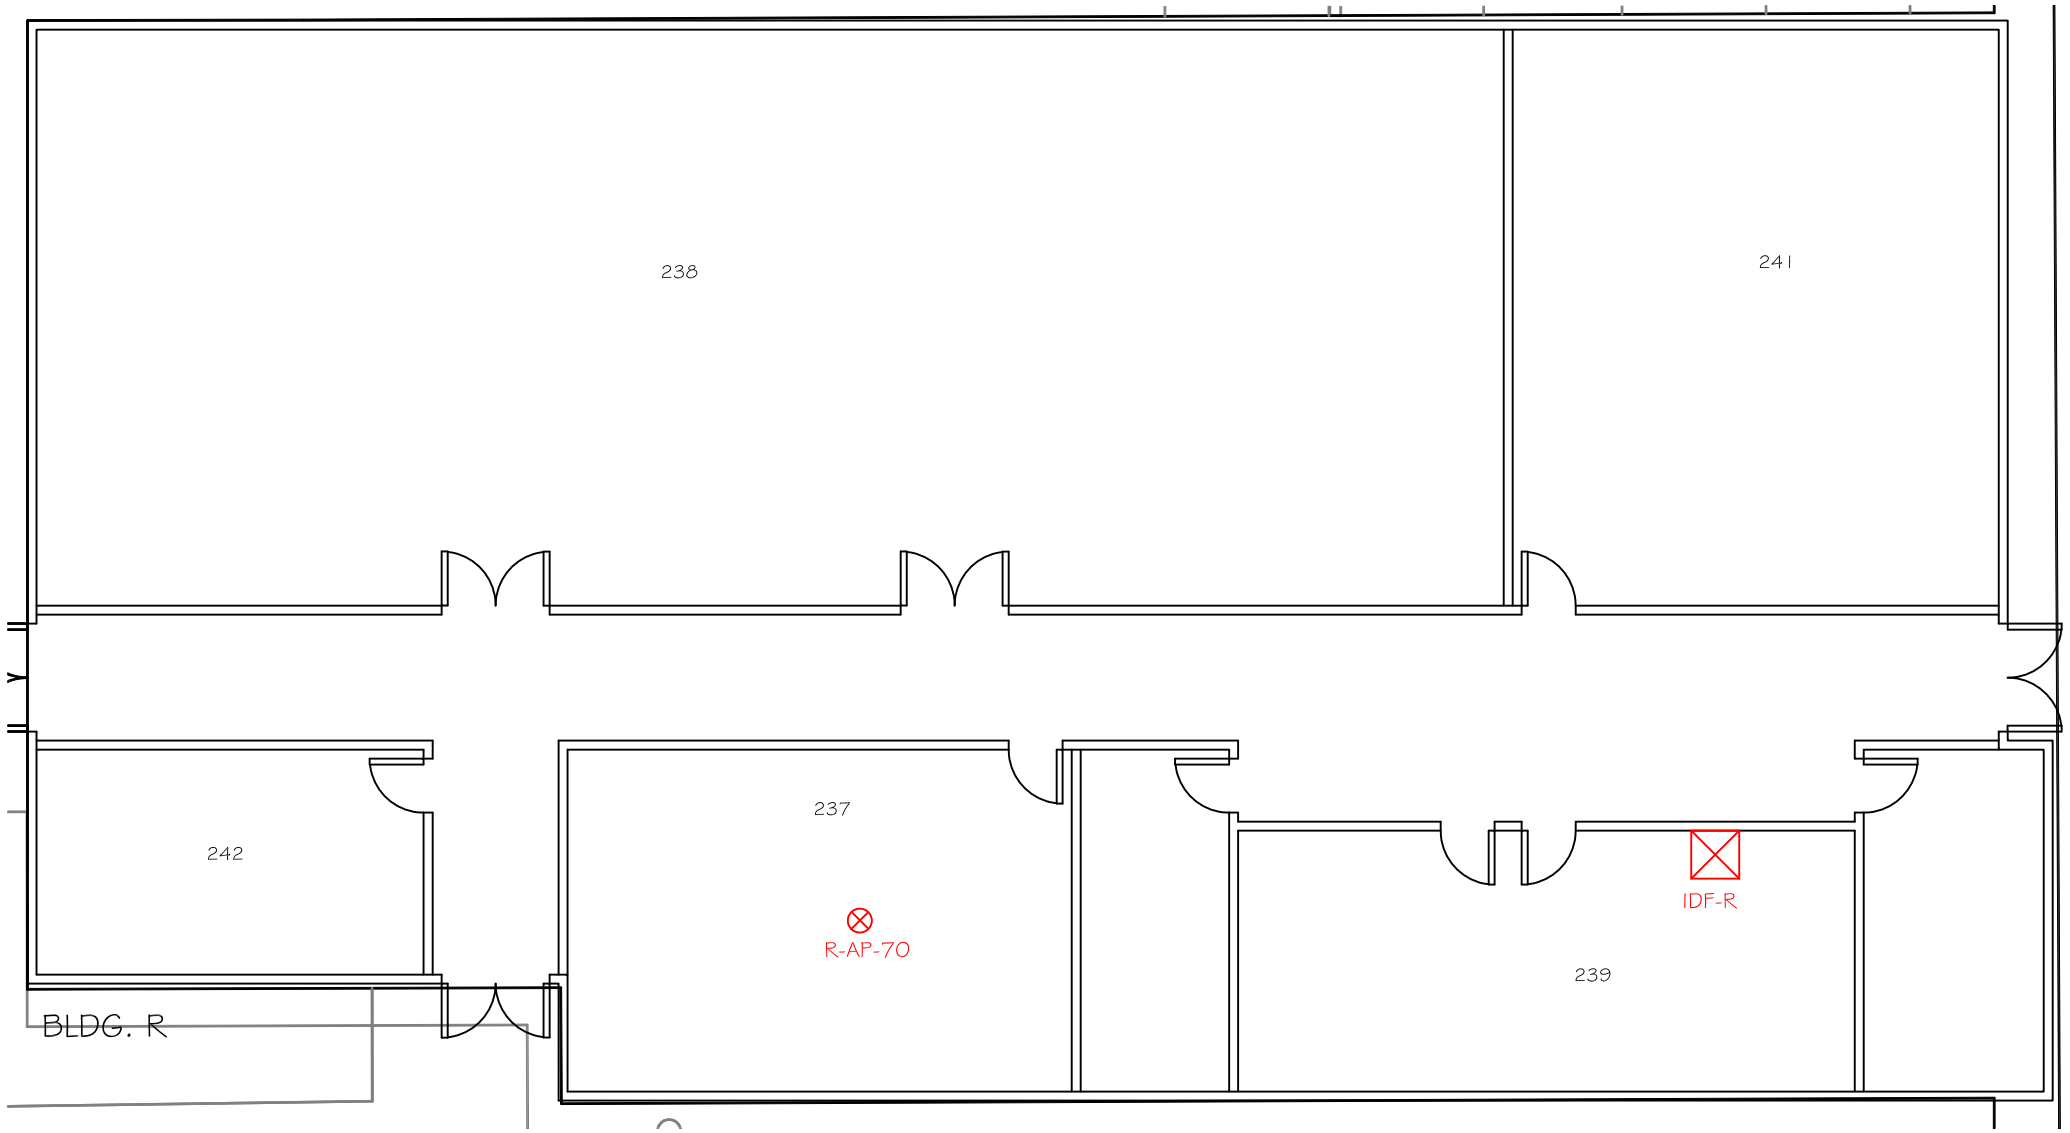


IDF-G - WIRELESS ACCESS POINT PLAN

SCALE: 3/32" = 1'-0"

LEGEND

⊗ WIRELESS ACCESS POINT

KEYMAP
NTS

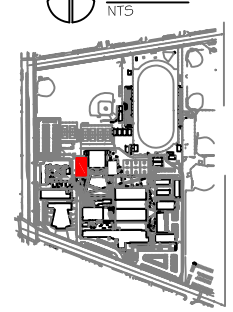

EASYNETWORKS CABLING
3538 SHELLEY WAY
RIVERSIDE, CA. 92503
OFFICE : 951. 742.8119
FAX : 951.742.8125
ST. LIC. # 936770

PREPARED FOR:

EL MONTE UNION HIGH SCHOOL DISTRICT

SITE:

ROSEMEAD HIGH SCHOOL

9063 MISSION DRIVE
ROSEMEAD, CA 91770

AS-BUILT
PROJECT NO. 5231

REVISIONS:

	DATE:	DESCRIPTION:

DRAWN BY:
GERARDO MORALES

DATE: 10/9/12
SCALE: AS SHOWN
SIZE: 11x17

TITLE:

IDF-G WIRELESS ACCESS POINT PLAN


• PROPERTY OF EASY NETWORKS •
• FOR USE BY EASY NETWORK ONLY •

SHEET#:

T16

16 OF 17

EASY NETWORKS - 5231 IDF R, 10/17/2012 4:29:40 PM, 11 x 17

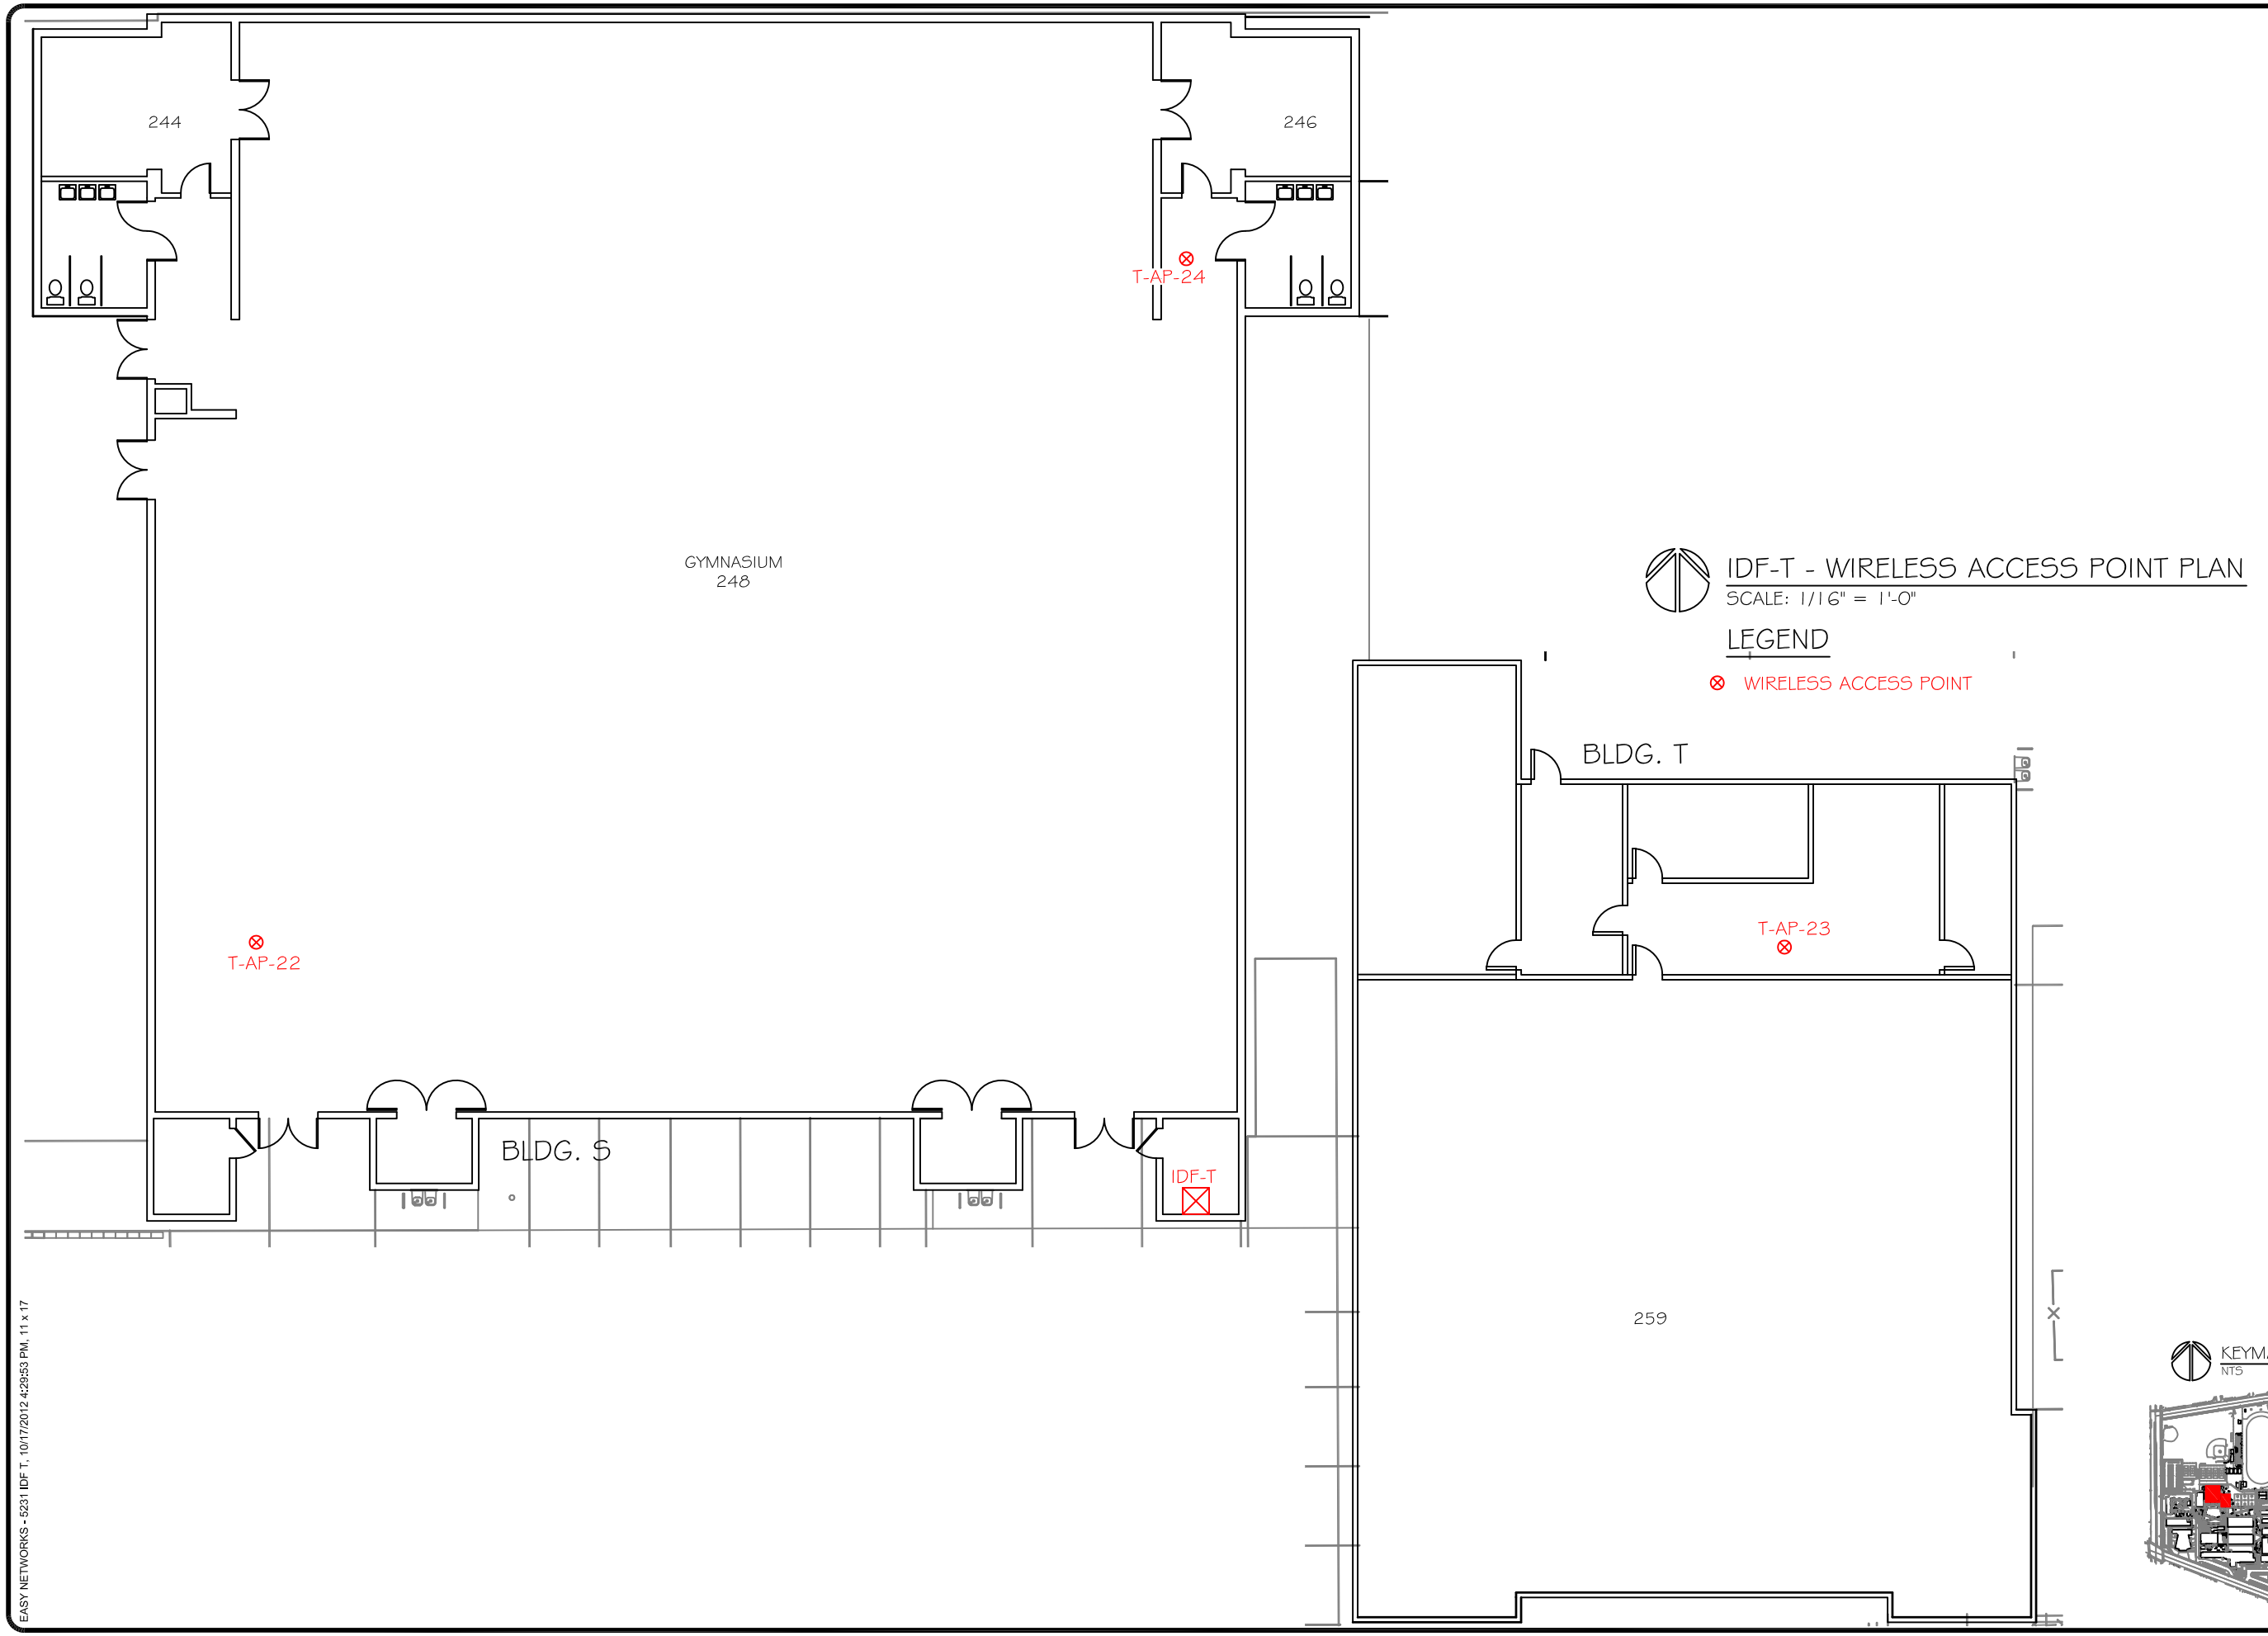

IDF-T - WIRELESS ACCESS POINT PLAN

SCALE: 1/16" = 1'-0"

LEGEND

⊗ WIRELESS ACCESS POINT

KEYMAP NTS

EASYNETWORKS CABLING
3538 SHELLEY WAY
RIVERSIDE, CA. 92503
OFFICE : 951. 742.8119
FAX : 951.742.8125
ST. LIC. # 936770

PREPARED FOR:

EL MONTE UNION HIGH SCHOOL DISTRICT

SITE:

ROSEMEAD HIGH SCHOOL

9063 MISSION DRIVE
ROSEMEAD, CA 91770

AS-BUILT
PROJECT NO. 5231

REVISIONS:

#	DATE:	DESCRIPTION:

DRAWN BY: GERARDO MORALES

DATE: 10/9/12
SCALE: AS SHOWN
SIZE: 11x17

TITLE:

IDF-T WIRELESS ACCESS POINT PLAN


• PROPERTY OF EASY NETWORKS •
• FOR USE BY EASY NETWORK ONLY •

SHEET#:

T17

17 OF 17

EASY NETWORKS - 5231 IDF T, 10/17/2012 4:29:53 PM, 11 x 17

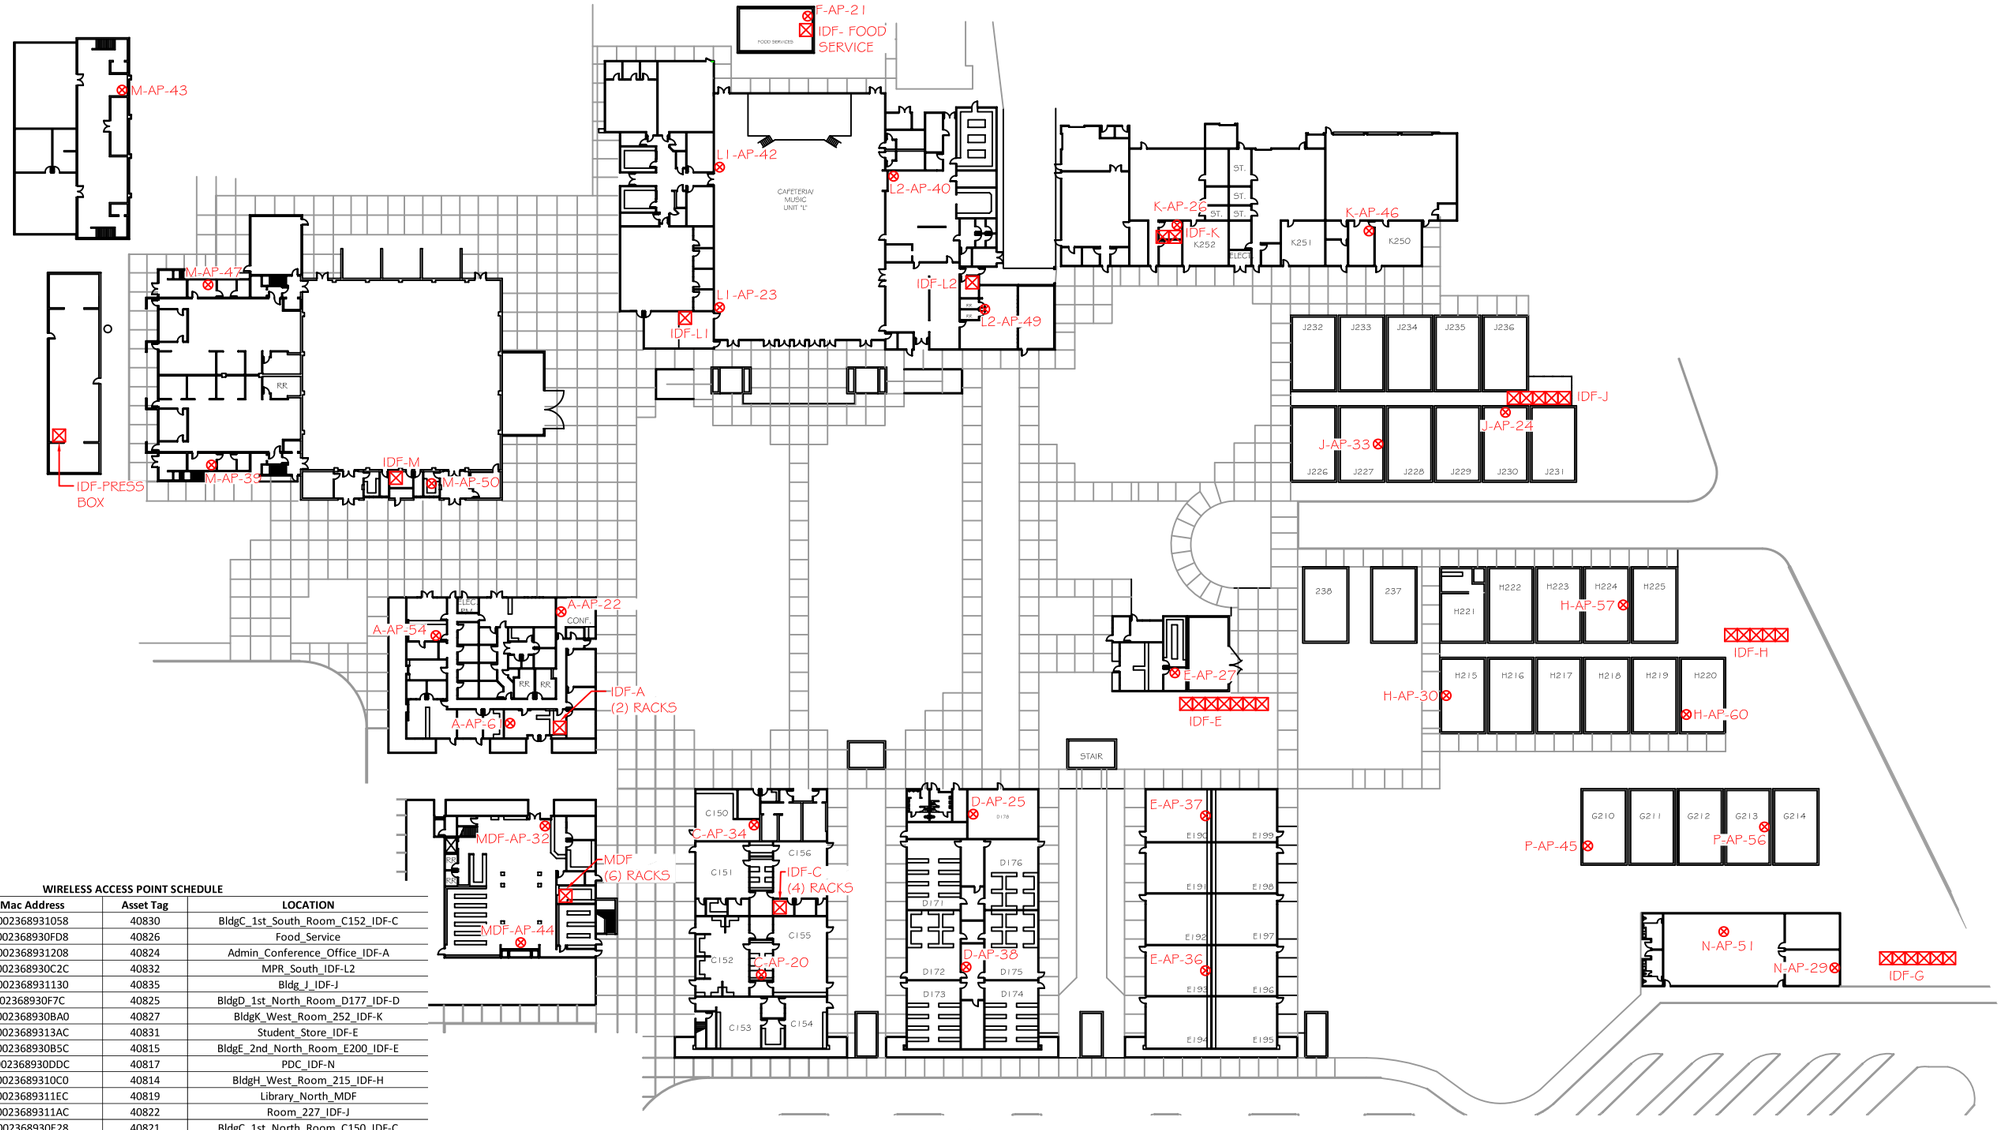

WIRELESS ACCESS POINT PLAN
SCALE: 1" = 80'-0"

LEGEND
⊗ WIRELESS ACCESS POINT

WIRELESS ACCESS POINT SCHEDULE

AP #	Mac Address	Asset Tag	LOCATION
SEM-C.AP_20	002368931058	40830	BldgC_1st_South_Room_C152_IDF-C
SEM-F.AP_21	002368930FD8	40826	Food_Service
SEM-A.AP_22	002368931208	40824	Admin_Conference_Office_IDF-A
SEM-L1.AP_23	002368930C2C	40832	MPR_South_IDF-L2
SEM-J.AP_24	002368931130	40835	Bldg_J_IDF-J
SEM-D.AP_25	02368930F7C	40825	BldgD_1st_North_Room_D177_IDF-D
SEM-K.AP_26	002368930BA0	40827	BldgK_West_Room_252_IDF-K
SEM-E.AP_27	002368931 3AC	40831	Student_Store_IDF-E
SEM-E.AP_28	002368930B5C	40815	BldgE_2nd_North_Room_E200_IDF-E
SEM-N.AP_29	002368930DDC	40817	PDC_IDF-N
SEM-H.AP_30	0023689310C0	40814	BldgH_West_Room_215_IDF-H
SEM-MDF.AP_32	0023689311EC	40819	Library_North_MDF
SEM-J.AP_33	0023689311AC	40822	Room_227_IDF-J
SEM-C.AP_34	002368930E28	40821	BldgC_1st_North_Room_C150_IDF-C
SEM-C.AP_35	002368930EB0	40820	BldgC_2nd_South_Room_C163_IDF-C
SEM-E.AP_36	002368930C4C	40816	BldgE_1st_South_Room_E193_IDF-E
SEM-E.AP_37	002368930674	40823	BldgE_1st_North_Room_E190_IDF-E
SEM-D.AP_38	002368930 66C	40828	BldgD_1st_South_Room_D172_IDF-D
SEM-M.AP_39	002368930A6C	40829	Gym_Boys_Locker_Room_IDF-M
SEM-L2.AP_40	002368461B20	36068	Kitchen_IDF-L1
SEM-D.AP_41	002368931004	36057	BldgD_2nd_South_Room_D185_IDF-D
SEM-L1.AP_42	002368931010	36064	MPR_North_IDF-L2
SEM-M.AP_43	0023688C0E88	36063	Gym_2nd_Floor_IDF-M
SEM-MDF.AP_44	002368931064	36067	Library_South_MDF
SEM-P.AP_45	002368930AB4	36059	BldgG_West_Room_210_IDF-G
SEM-K.AP_46	002368931070	36060	BldgK_Maintanance
SEM-M.AP_47	002368930C64	36065	Gym_North_IDF-M
SEM-D.AP_48	0023688B3CF8	36061	BldgD_2nd_North_Room_D187_IDF-D
SEM-L2.AP_49	0023688B3F88	36062	Teacher_Lounge_IDF-L1
SEM-M.AP_50	002368930A9C	36066	Gym_Room_271_IDF-M
SEM-N.AP_51	002368930CF8	36106	PDC_IDF-N
SEM-C.AP_53	002368461D50	36074	2nd_North_Room_C160_IDF-C
SEM-A.AP_54	002368930BAC	36069	Admin_Guidance_Office_IDF-A
SEM-E.AP_55	0023688C1054	36070	BldgE_2nd_South_Room_E203
SEM-P.AP_56	002368461AF0	36071	Room_213_Bldg_G
SEM-H.AP_57	002368930CD4	36134	BldgH_East_Room_224_IDF-H
SEM-H.AP_60	002368930CFC	36198	Room_220_IDF-H
SEM-A.AP_61	002368931 0EC	41015	Admin_IDF-A

EASYNETWORKS CABLING
3538 SHELLEY WAY
RIVERSIDE, CA. 92503
OFFICE : 951. 742.8119
FAX : 951.742.8125
ST. LIC. # 936770

PREPARED FOR:
EL MONTE UNION HIGH SCHOOL DISTRICT

SITE:
SOUTH EL MONTE HIGH SCHOOL

1001 N. DURFEE AVE.
EL MONTE, CA 91733

AS-BUILT
PROJECT NO. 5231

REVISIONS:

	DATE:	DESCRIPTION:

DRAWN BY:
GERARDO MORALES


DATE: 10/9/12
SCALE: AS SHOWN
SIZE: 11x17

TITLE:
WIRELESS ACCESS POINT PLAN

● PROPERTY OF EASY NETWORKS ●
● FOR USE BY EASY NETWORK ONLY ●

SHEET#:
T1
1 OF 14

EASY NETWORKS - 5231, 10/17/2012 4:19:19 PM, 11 x 17

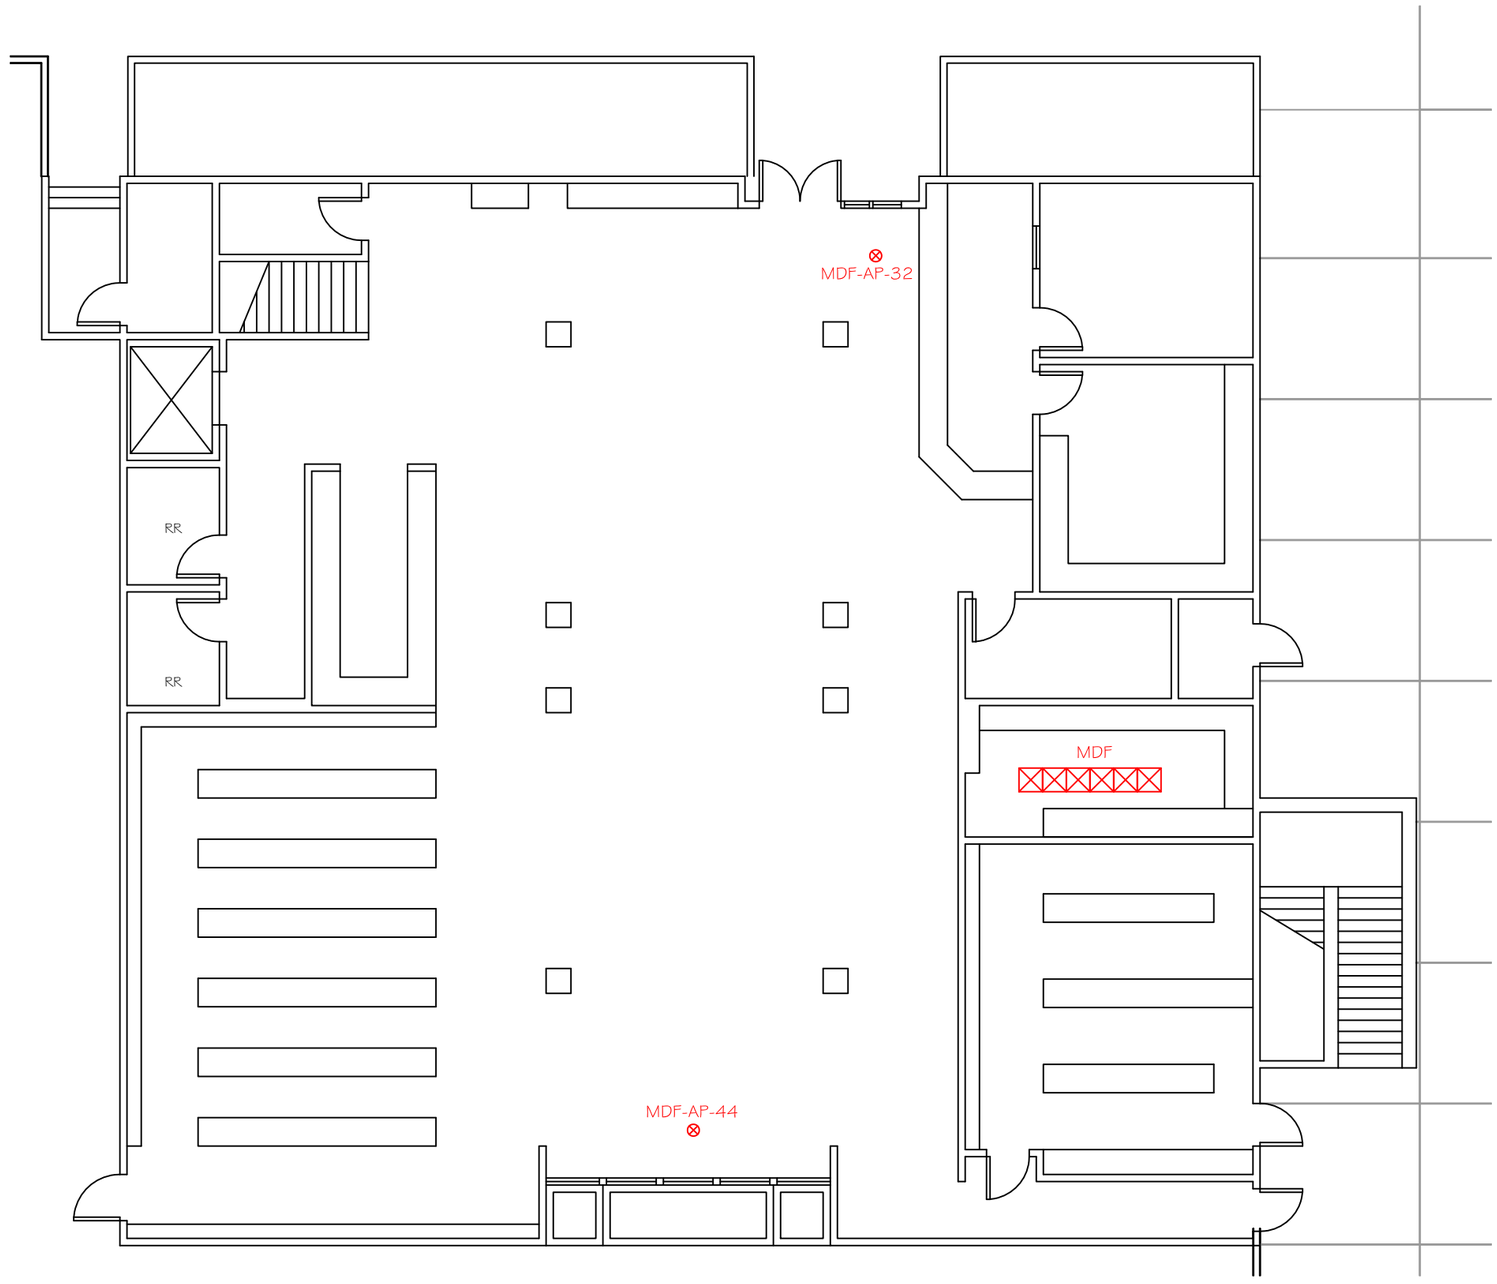


MDF - WIRELESS ACCESS POINT PLAN
SCALE: 3/32" = 1'-0"

LEGEND

⊗ WIRELESS ACCESS POINT

KEYMAP
NTS

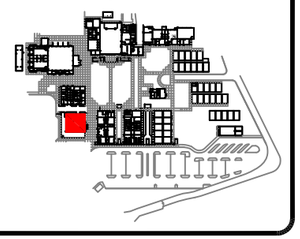

EASYNETWORKS CABLING
3538 SHELLEY WAY
RIVERSIDE, CA. 92503
OFFICE : 951. 742.8119
FAX : 951.742.8125
ST. LIC. # 936770

PREPARED FOR:

EL MONTE UNION HIGH SCHOOL DISTRICT

SITE:

SOUTH EL MONTE HIGH SCHOOL

1001 N. DURFEE AVE.
EL MONTE, CA 91733

AS-BUILT
PROJECT NO. 5231

REVISIONS:

#	DATE:	DESCRIPTION:

DRAWN BY:
GERARDO MORALES

DATE: 10/9/12
SCALE: AS SHOWN
SIZE: 11x17

TITLE:

MDF WIRELESS ACCESS POINT PLAN


• PROPERTY OF EASY NETWORKS •
• FOR USE BY EASY NETWORK ONLY •

SHEET#:

T2

2 OF 14

EASY NETWORKS - 5231 MDF 10/17/2012 4:20:16 PM, 11 x 17

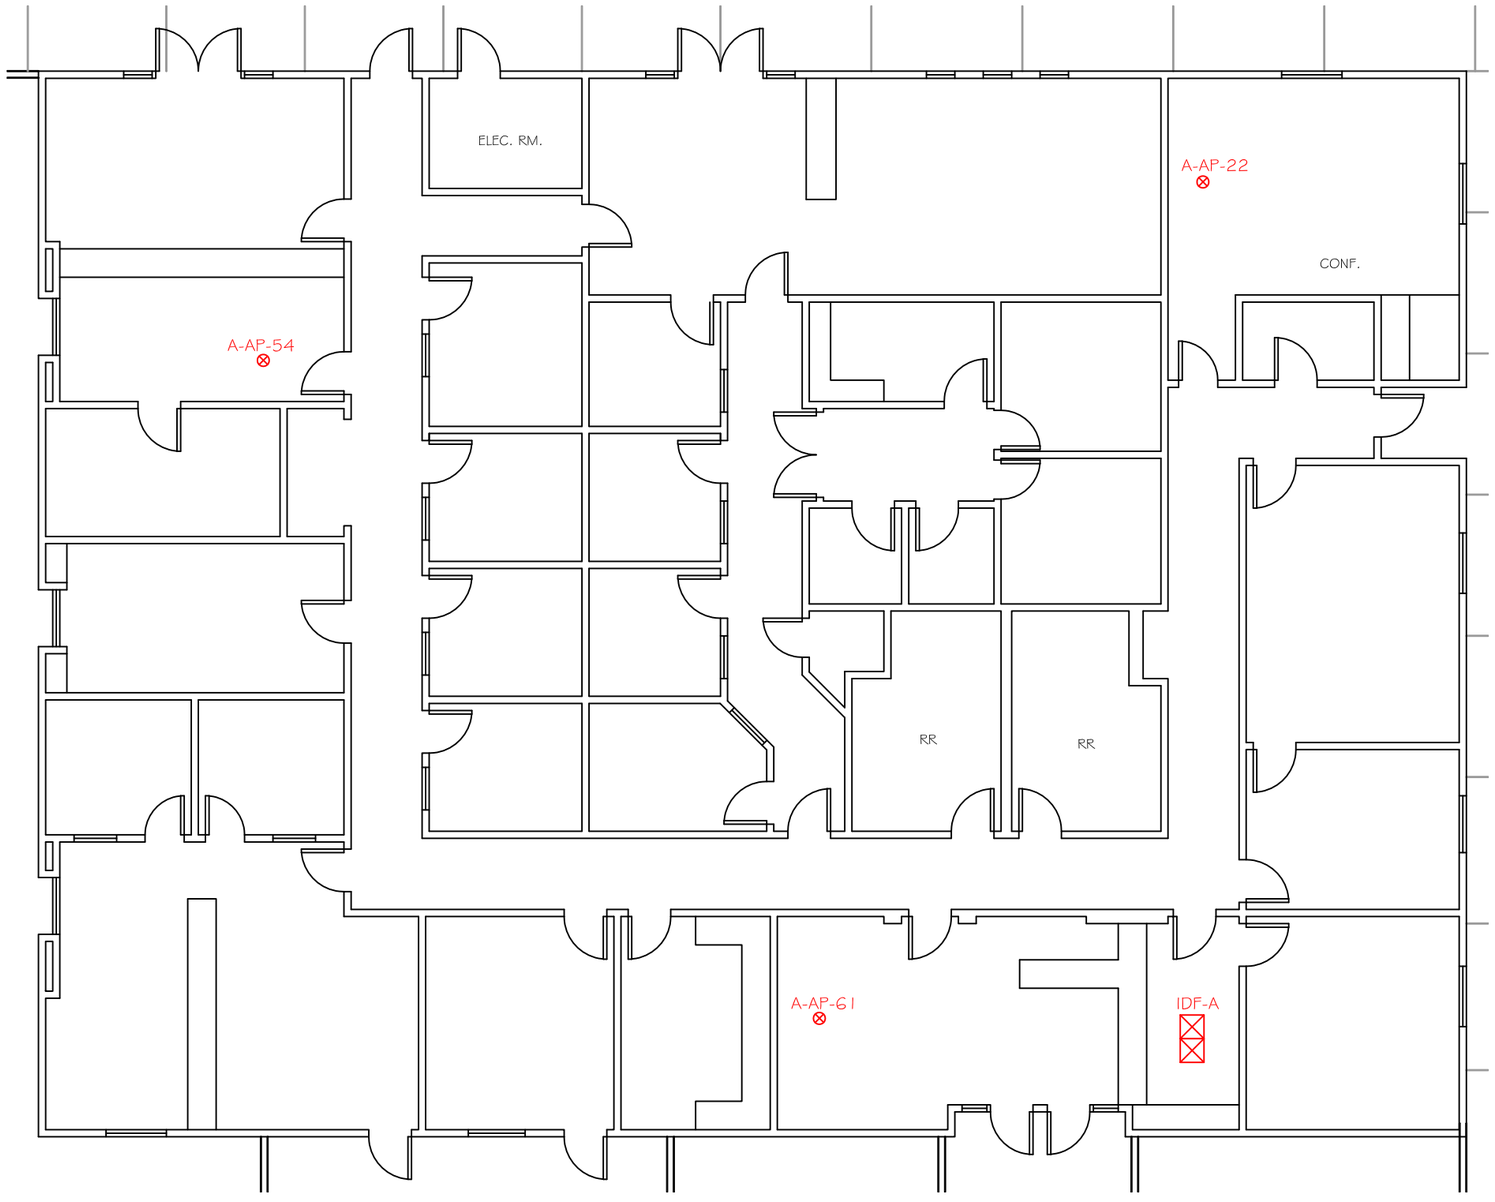


IDF-A - WIRELESS ACCESS POINT PLAN
SCALE: 3/32" = 1'-0"

LEGEND

⊗ WIRELESS ACCESS POINT

KEYMAP
NTS

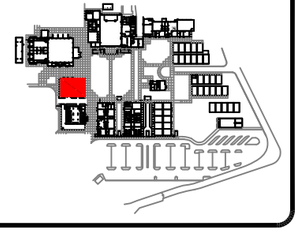

EASYNETWORKS CABLING
3538 SHELLEY WAY
RIVERSIDE, CA. 92503
OFFICE : 951. 742.8119
FAX : 951.742.8125
ST. LIC. # 936770

PREPARED FOR:

EL MONTE UNION HIGH SCHOOL DISTRICT

SITE:

SOUTH EL MONTE HIGH SCHOOL

1001 N. DURFEE AVE.
EL MONTE, CA 91733

AS-BUILT
PROJECT NO. 5231

REVISIONS:

	DATE:	DESCRIPTION:

DRAWN BY:
GERARDO MORALES

DATE: 10/9/12
SCALE: AS SHOWN
SIZE: 11x17

TITLE:

IDF-A WIRELESS ACCESS POINT PLAN


•PROPERTY OF EASY NETWORKS•
•FOR USE BY EASY NETWORK ONLY•

SHEET#:


T3

3 OF 14

EASY NETWORKS - 5231 IDF A, 10/17/2012 4:20:37 PM, 11 x 17

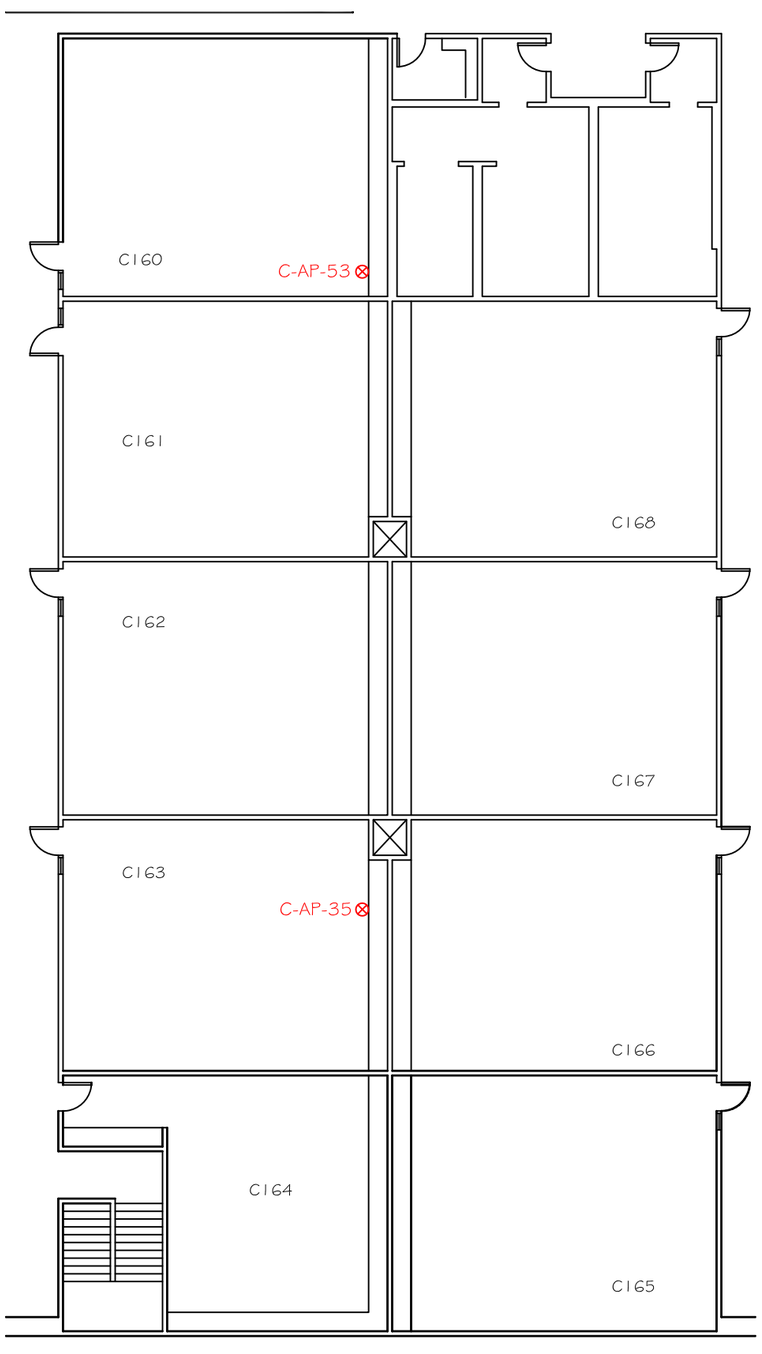

BUILDING C
SECOND FLOOR

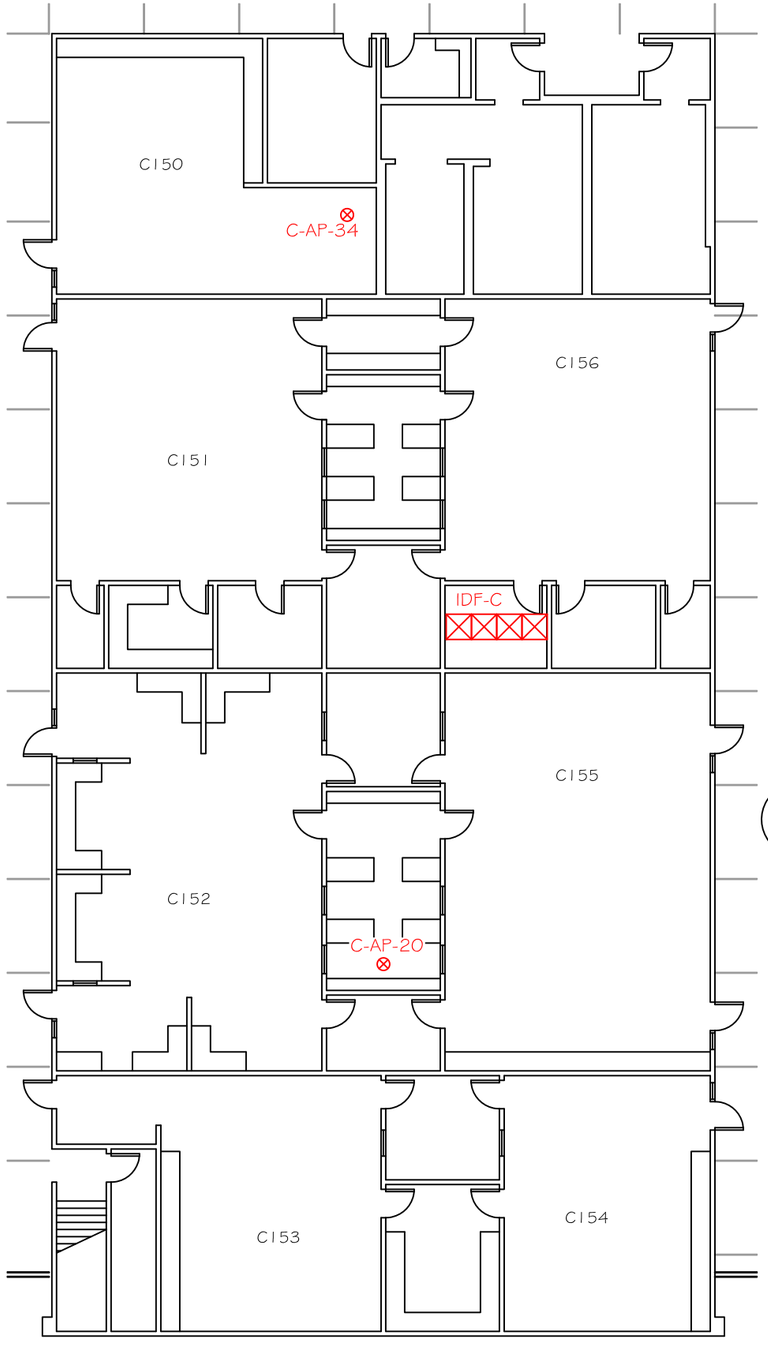

BUILDING C
FIRST FLOOR


IDF-C - WIRELESS ACCESS POINT PLAN

SCALE: 1/16" = 1'-0"

LEGEND

⊗ WIRELESS ACCESS POINT

KEYMAP
NTS

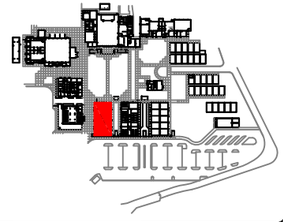

EASYNETWORKS CABLING
3538 SHELLEY WAY
RIVERSIDE, CA. 92503
OFFICE : 951. 742.8119
FAX : 951.742.8125
ST. LIC. # 936770

PREPARED FOR:

EL MONTE UNION HIGH SCHOOL DISTRICT

SITE:

SOUTH EL MONTE HIGH SCHOOL

1001 N. DURFEE AVE.
EL MONTE, CA 91733

AS-BUILT
PROJECT NO. 5231

REVISIONS:

	DATE:	DESCRIPTION:

DRAWN BY:
GERARDO MORALES

DATE: 10/9/12
SCALE: AS SHOWN
SIZE: 11x17

TITLE:

IDF-C WIRELESS ACCESS POINT PLAN


• PROPERTY OF EASY NETWORKS •
• FOR USE BY EASY NETWORK ONLY •

SHEET#:


T4

4 OF 14

EASY NETWORKS - 5231 IDF C, 10/17/2012 4:20:47 PM, 11 x 17

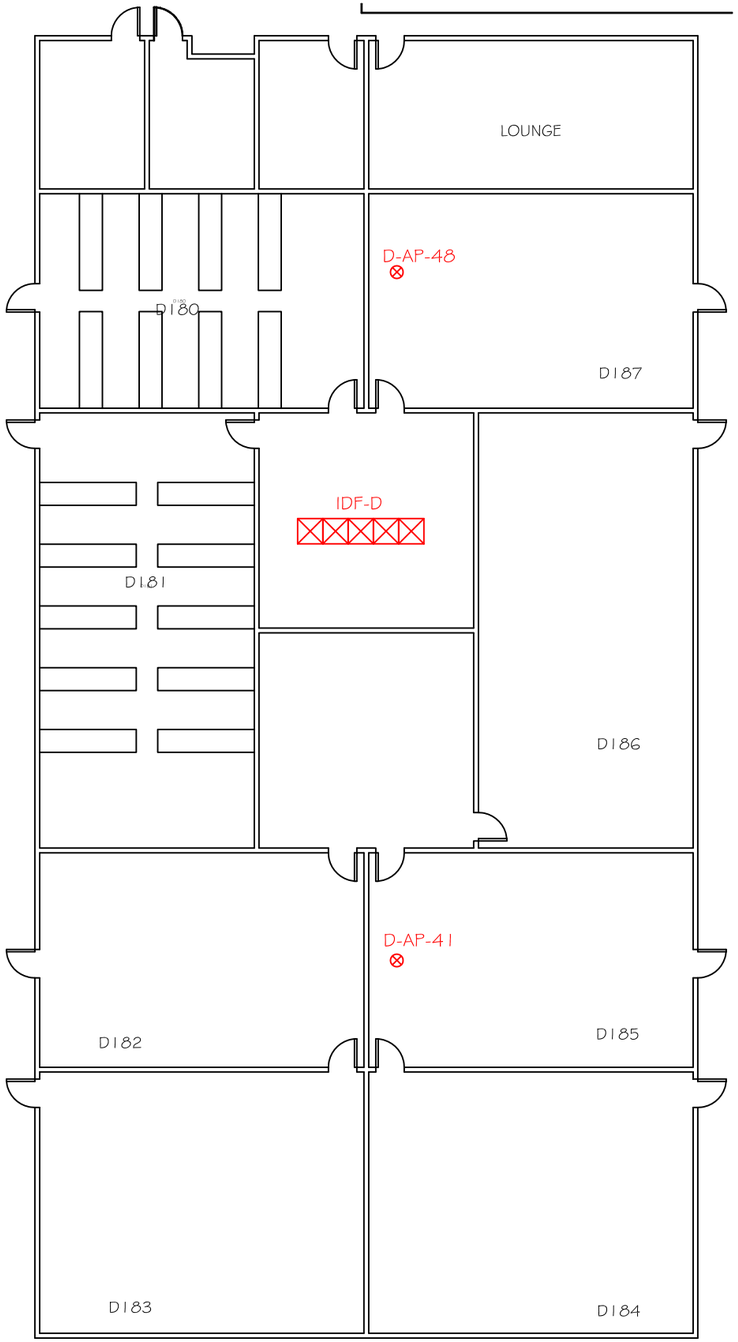

BUILDING D
SECOND FLOOR

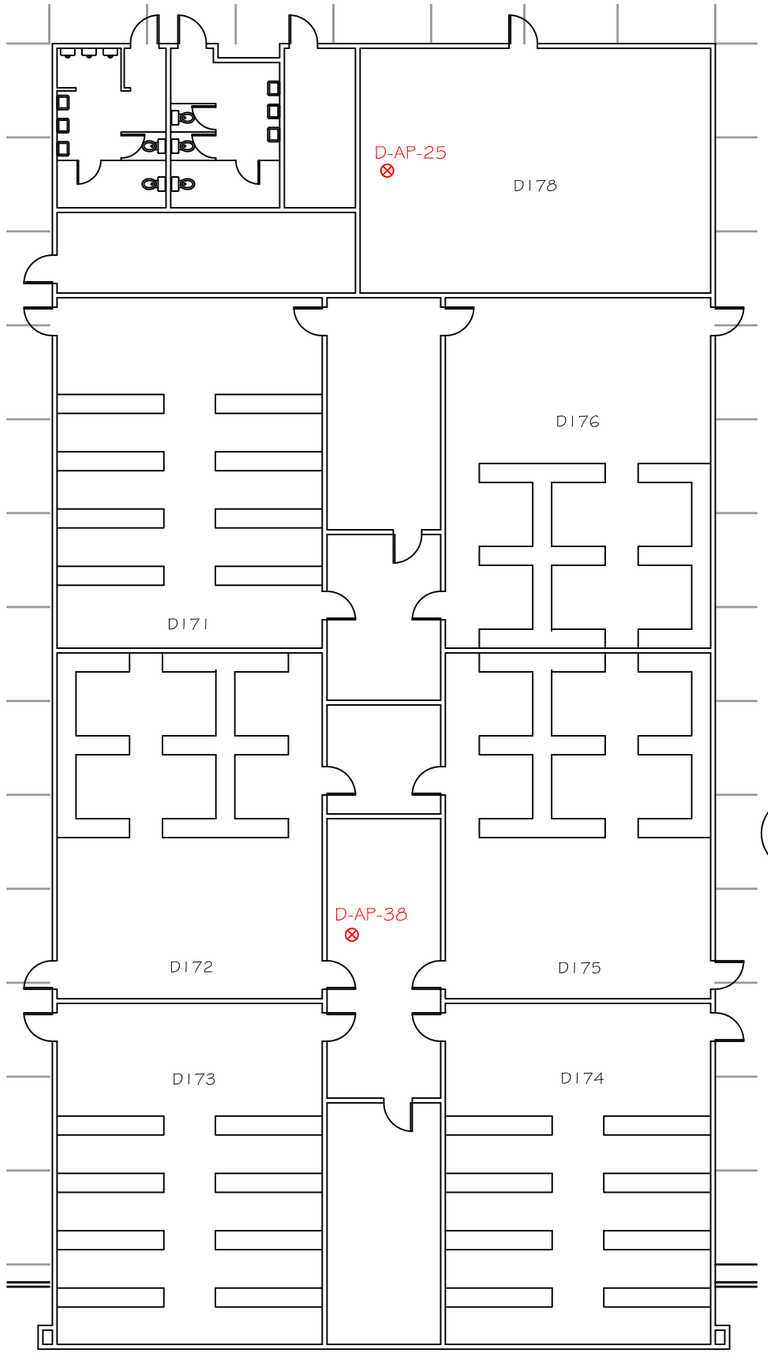

BUILDING D
FIRST FLOOR


IDF-D - WIRELESS ACCESS POINT PLAN

SCALE: 1/16" = 1'-0"

LEGEND

⊗ WIRELESS ACCESS POINT

KEYMAP
NTS

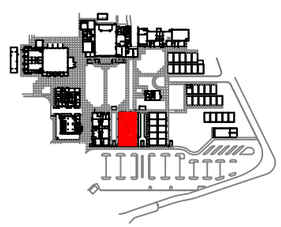

EASYNETWORKS CABLING
3538 SHELLEY WAY
RIVERSIDE, CA. 92503
OFFICE : 951. 742.8119
FAX : 951.742.8125
ST. LIC. # 936770

PREPARED FOR:
EL MONTE UNION HIGH SCHOOL DISTRICT

SITE:
SOUTH EL MONTE HIGH SCHOOL

1001 N. DURFEE AVE.
EL MONTE, CA 91733

AS-BUILT
PROJECT NO. 5231

REVISIONS:

	DATE:	DESCRIPTION:

DRAWN BY:
GERARDO MORALES


DATE: 10/9/12
SCALE: AS SHOWN
SIZE: 11x17


TITLE:
IDF-D WIRELESS ACCESS POINT PLAN

• PROPERTY OF EASY NETWORKS •
• FOR USE BY EASY NETWORK ONLY •

SHEET#:
T5
5 OF 14

EASY NETWORKS - 5231 IDF D, 10/17/2012 4:20:54 PM, 11 x 17

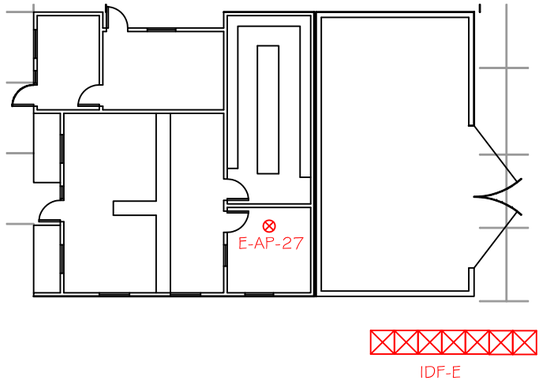

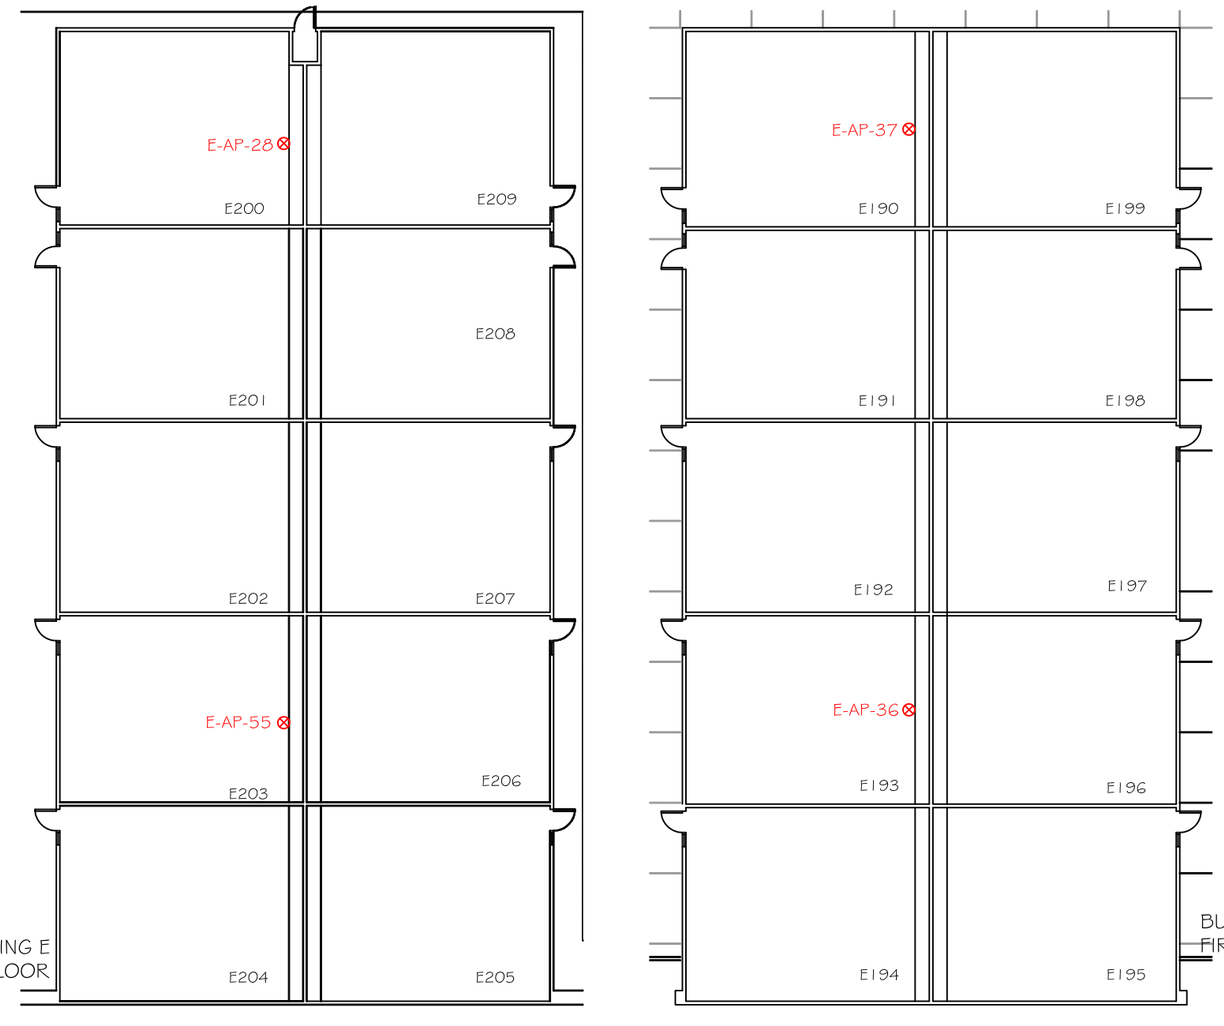


IDF-E - WIRELESS ACCESS POINT PLAN

SCALE: 3/64" = 1'-0"

LEGEND

⊗ WIRELESS ACCESS POINT

KEYMAP
NTS

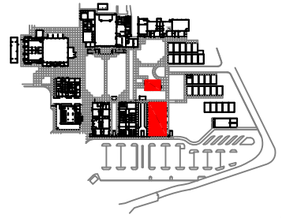

EASYNETWORKS CABLING
3538 SHELLEY WAY
RIVERSIDE, CA. 92503
OFFICE : 951. 742.8119
FAX : 951.742.8125
ST. LIC. # 936770

PREPARED FOR:

EL MONTE UNION HIGH SCHOOL DISTRICT

SITE:

SOUTH EL MONTE HIGH SCHOOL

1001 N. DURFEE AVE.
EL MONTE, CA 91733

AS-BUILT
PROJECT NO. 5231

REVISIONS:

#	DATE:	DESCRIPTION:

DRAWN BY: GERARDO MORALES

DATE: 10/9/12
SCALE: AS SHOWN
SIZE: 11x17

TITLE:

IDF-E WIRELESS ACCESS POINT PLAN

• PROPERTY OF EASY NETWORKS •
• FOR USE BY EASY NETWORK ONLY •

SHEET#:

T6

6 OF 14

EASY NETWORKS - 5231 IDF E, 10/17/2012 4:21:01 PM, 11 x 17




IDF-F - WIRELESS ACCESS POINT PLAN

SCALE: 1/16" = 1'-0"

LEGEND

⊗ WIRELESS ACCESS POINT

KEYMAP
NTS

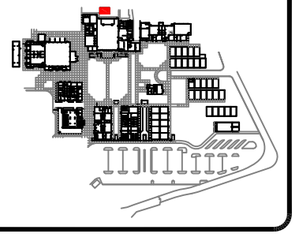

EASYNETWORKS CABLING
3538 SHELLEY WAY
RIVERSIDE, CA. 92503
OFFICE : 951. 742.8119
FAX : 951.742.8125
ST. LIC. # 936770

PREPARED FOR:

EL MONTE UNION HIGH SCHOOL DISTRICT

SITE:

SOUTH EL MONTE HIGH SCHOOL

1001 N. DURFEE AVE.
EL MONTE, CA 91733

AS-BUILT
PROJECT NO. 5231

REVISIONS:

#	DATE:	DESCRIPTION:

DRAWN BY:
GERARDO MORALES

DATE: 10/9/12
SCALE: AS SHOWN
SIZE: 11x17

TITLE:

IDF-F WIRELESS ACCESS POINT PLAN

● PROPERTY OF EASY NETWORKS ●
● FOR USE BY EASY NETWORK ONLY ●

SHEET#:

T7

7 OF 14

EASY NETWORKS - 5231 IDF F, 10/17/2012 4:21:16 PM, 11 x 17




IDF-H - WIRELESS ACCESS POINT PLAN

SCALE: 1/16" = 1'-0"

LEGEND

⊗ WIRELESS ACCESS POINT

KEYMAP
NTS

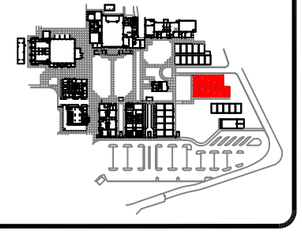

EASYNETWORKS CABLING
3538 SHELLEY WAY
RIVERSIDE, CA. 92503
OFFICE : 951. 742.8119
FAX : 951.742.8125
ST. LIC. # 936770

PREPARED FOR:

EL MONTE UNION HIGH SCHOOL DISTRICT

SITE:

SOUTH EL MONTE HIGH SCHOOL

1001 N. DURFEE AVE.
EL MONTE, CA 91733

AS-BUILT
PROJECT NO. 5231

REVISIONS:

	DATE:	DESCRIPTION:

DRAWN BY:
GERARDO MORALES

DATE: 10/9/12
SCALE: AS SHOWN
SIZE: 11x17

TITLE:

IDF-H WIRELESS ACCESS POINT PLAN


● PROPERTY OF EASY NETWORKS ●
● FOR USE BY EASY NETWORK ONLY ●

SHEET#:

T8

8 OF 14

EASY NETWORKS - 5231 IDF H, 10/17/2012 4:21:30 PM, 11 x 17

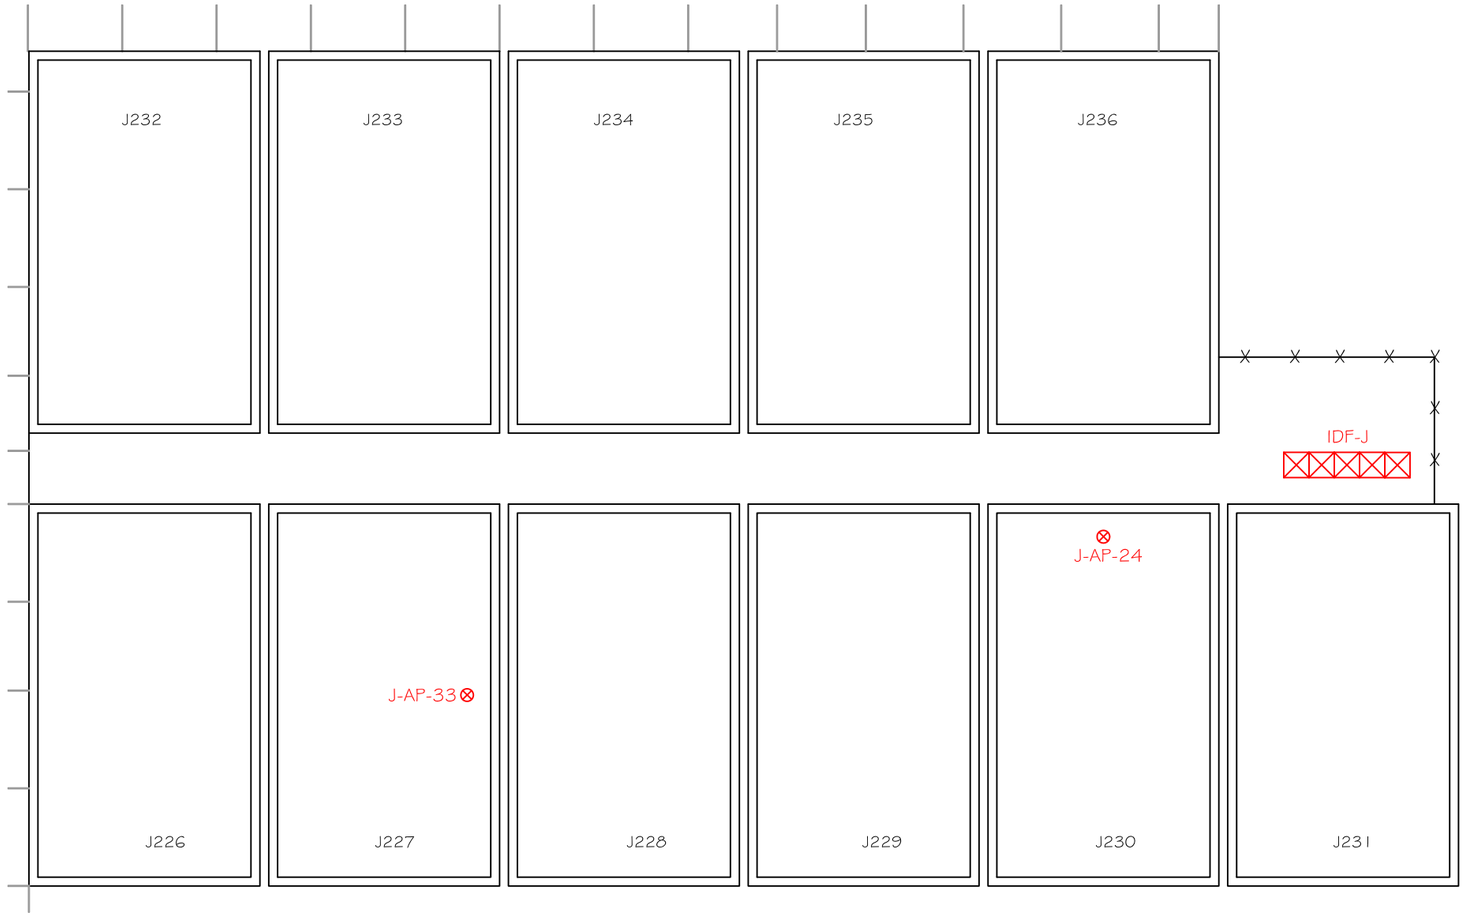

IDF-J - WIRELESS ACCESS POINT PLAN

SCALE: 1/16" = 1'-0"

LEGEND


⊗ WIRELESS ACCESS POINT

H218

H-AP-60 ⊗

IDF-H

KEYMAP
NTS

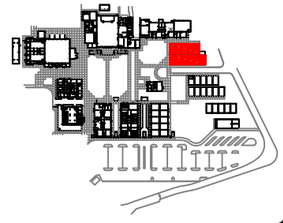

EASYNETWORKS CABLING
3538 SHELLEY WAY
RIVERSIDE, CA. 92503
OFFICE : 951. 742.8119
FAX : 951.742.8125
ST. LIC. # 936770

PREPARED FOR:

EL MONTE UNION HIGH SCHOOL DISTRICT

SITE:

SOUTH EL MONTE HIGH SCHOOL

1001 N. DURFEE AVE.
EL MONTE, CA 91733

AS-BUILT
PROJECT NO. 5231

REVISIONS:

	DATE:	DESCRIPTION:

DRAWN BY: GERARDO MORALES

DATE: 10/9/12
SCALE: AS SHOWN
SIZE: 11x17

TITLE:


IDF-J WIRELESS ACCESS POINT PLAN

● PROPERTY OF EASY NETWORKS ●
● FOR USE BY EASY NETWORK ONLY ●

SHEET#:

T9

9 OF 14

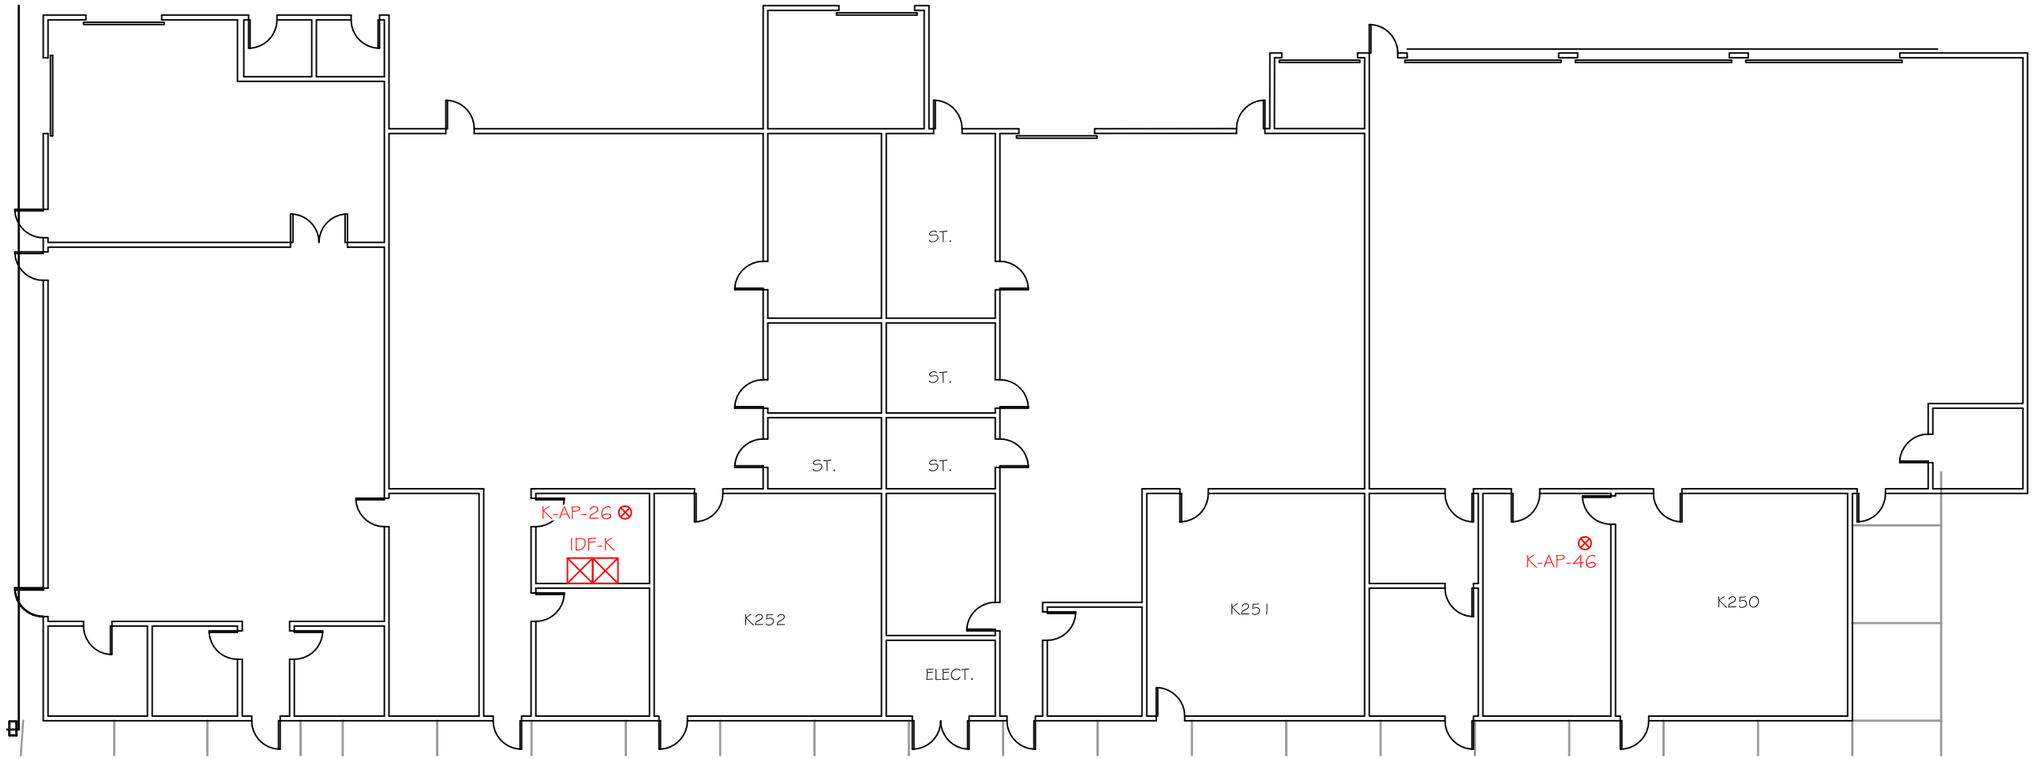

IDF-K - WIRELESS ACCESS POINT PLAN

SCALE: 1/16" = 1'-0"

LEGEND

⊗ WIRELESS ACCESS POINT

KEYMAP
NTS



EASYNETWORKS CABLING
3538 SHELLEY WAY
RIVERSIDE, CA. 92503
OFFICE : 951. 742.8119
FAX : 951.742.8125
ST. LIC. # 936770

PREPARED FOR:

EL MONTE UNION HIGH SCHOOL DISTRICT

SITE:

SOUTH EL MONTE HIGH SCHOOL

1001 N. DURFEE AVE.
EL MONTE, CA 91733

AS-BUILT
PROJECT NO. 5231

REVISIONS:

	DATE:	DESCRIPTION:

DRAWN BY:
GERARDO MORALES

DATE: 10/9/12
SCALE: AS SHOWN
SIZE: 11x17

TITLE:

IDF-K WIRELESS ACCESS POINT PLAN


• PROPERTY OF EASY NETWORKS •
• FOR USE BY EASY NETWORK ONLY •

SHEET#:

T10

10 OF 14

EASY NETWORKS - 5231 IDF K, 10/17/2012 4:21:50 PM, 11 x 17

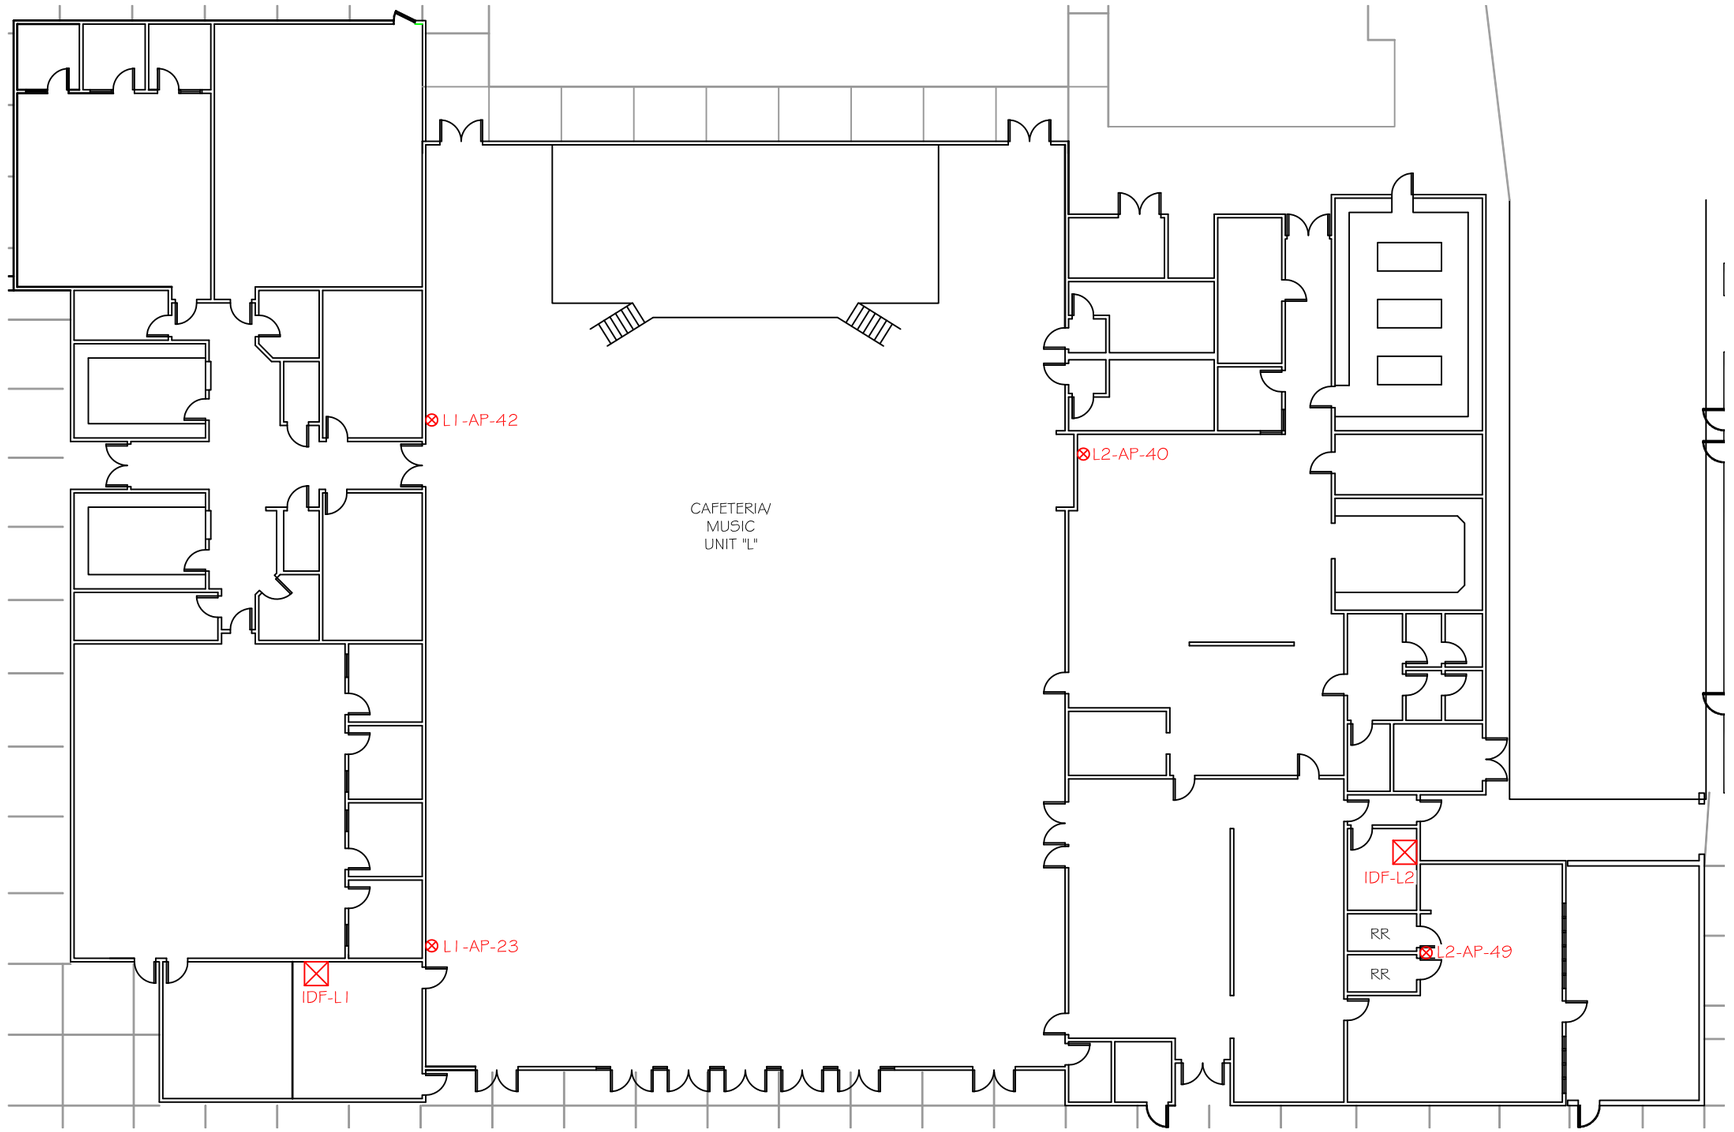


IDF-L1 & L2 - WIRELESS ACCESS POINT PLAN

SCALE: 1/16" = 1'-0"

LEGEND

⊗ WIRELESS ACCESS POINT

KEYMAP
NTS

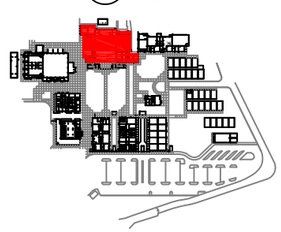

EASYNETWORKS CABLING

3538 SHELLEY WAY
RIVERSIDE, CA. 92503
OFFICE : 951. 742.8119
FAX : 951.742.8125
ST. LIC. # 936770

PREPARED FOR:

EL MONTE UNION HIGH SCHOOL DISTRICT

SITE:

SOUTH EL MONTE HIGH SCHOOL

1001 N. DURFEE AVE.
EL MONTE, CA 91733

AS-BUILT
PROJECT NO. 5231

REVISIONS:

#	DATE:	DESCRIPTION:

DRAWN BY:
GERARDO MORALES

DATE: 10/9/12
SCALE: AS SHOWN
SIZE: 11x17

TITLE:

IDF-L1 & L2 WIRELESS ACCESS POINT PLAN

• PROPERTY OF EASY NETWORKS •
• FOR USE BY EASY NETWORK ONLY •

SHEET#:

T11

11 OF 14

EASY NETWORKS - 5231 IDF L1 & L2, 10/17/2012 4:22:02 PM, 11 x 17




IDF-M - WIRELESS ACCESS POINT PLAN

SCALE: 1/16" = 1'-0"

LEGEND

⊗ WIRELESS ACCESS POINT

KEYMAP NTS

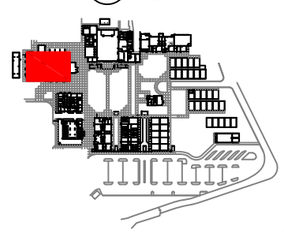

EASYNETWORKS CABLING
3538 SHELLEY WAY
RIVERSIDE, CA. 92503
OFFICE : 951. 742.8119
FAX : 951.742.8125
ST. LIC. # 936770

PREPARED FOR:

EL MONTE UNION HIGH SCHOOL DISTRICT

SITE:

SOUTH EL MONTE HIGH SCHOOL

1001 N. DURFEE AVE.
EL MONTE, CA 91733

AS-BUILT
PROJECT NO. 5231

REVISIONS:

#	DATE:	DESCRIPTION:

DRAWN BY: GERARDO MORALES

DATE: 10/9/12
SCALE: AS SHOWN
SIZE: 11x17

TITLE:

IDF-M WIRELESS ACCESS POINT PLAN


● PROPERTY OF EASY NETWORKS ●
● FOR USE BY EASY NETWORK ONLY ●

SHEET#:

T12

12 OF 14

EASY NETWORKS - 5231 IDF M, 10/17/2012 4:22:10 PM, 11 x 17

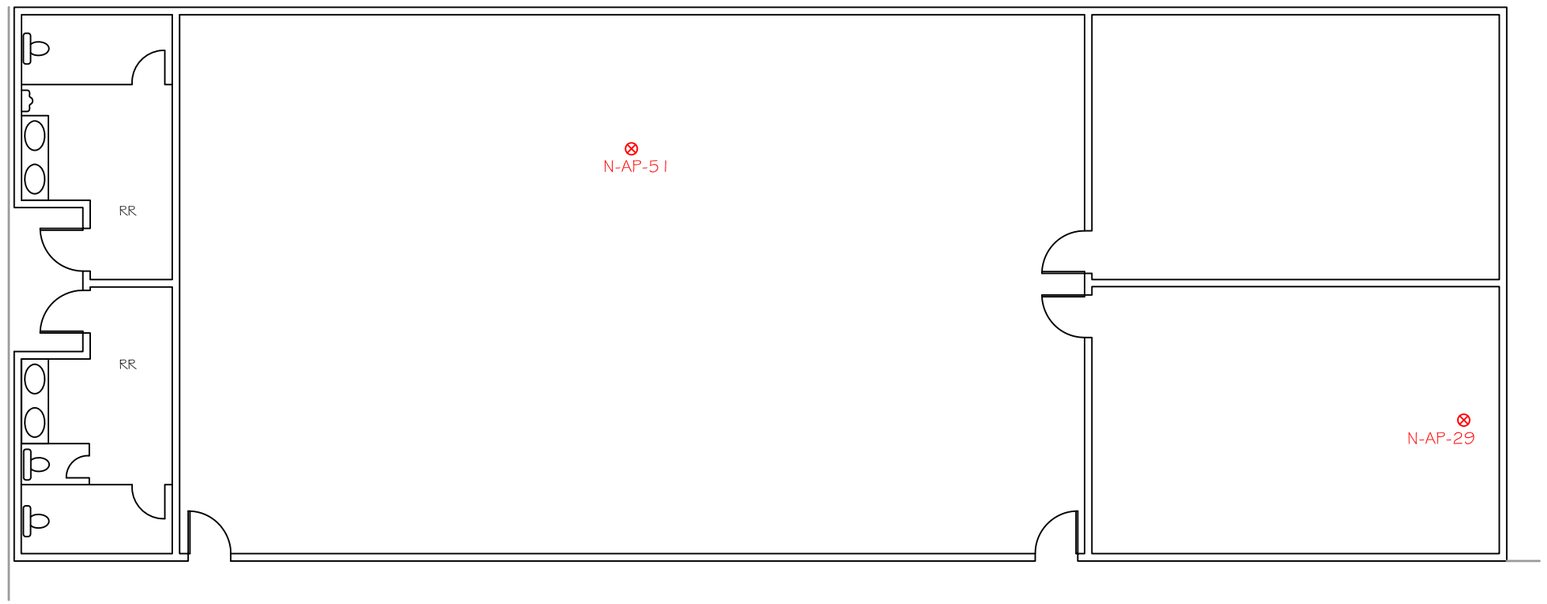


IDF-N - WIRELESS ACCESS POINT PLAN

SCALE: 3/32" = 1'-0"

LEGEND

⊗ WIRELESS ACCESS POINT

KEYMAP
NTS

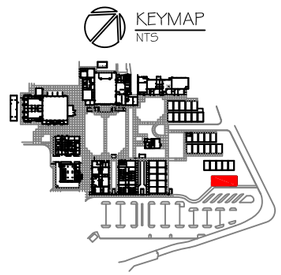

EASYNETWORKS CABLING
3538 SHELLEY WAY
RIVERSIDE, CA. 92503
OFFICE : 951. 742.8119
FAX : 951.742.8125
ST. LIC. # 936770

PREPARED FOR:

EL MONTE UNION HIGH SCHOOL DISTRICT

SITE:

SOUTH EL MONTE HIGH SCHOOL

1001 N. DURFEE AVE.
EL MONTE, CA 91733

AS-BUILT
PROJECT NO. 5231

REVISIONS:

	DATE:	DESCRIPTION:

DRAWN BY:
GERARDO MORALES

DATE: 10/9/12
SCALE: AS SHOWN
SIZE: 11x17

TITLE:

IDF-N WIRELESS ACCESS POINT PLAN


• PROPERTY OF EASY NETWORKS •
• FOR USE BY EASY NETWORK ONLY •

SHEET#:

T13

13 OF 14

EASY NETWORKS - 5231 IDF N, 10/17/2012 4:22:20 PM, 11 x 17

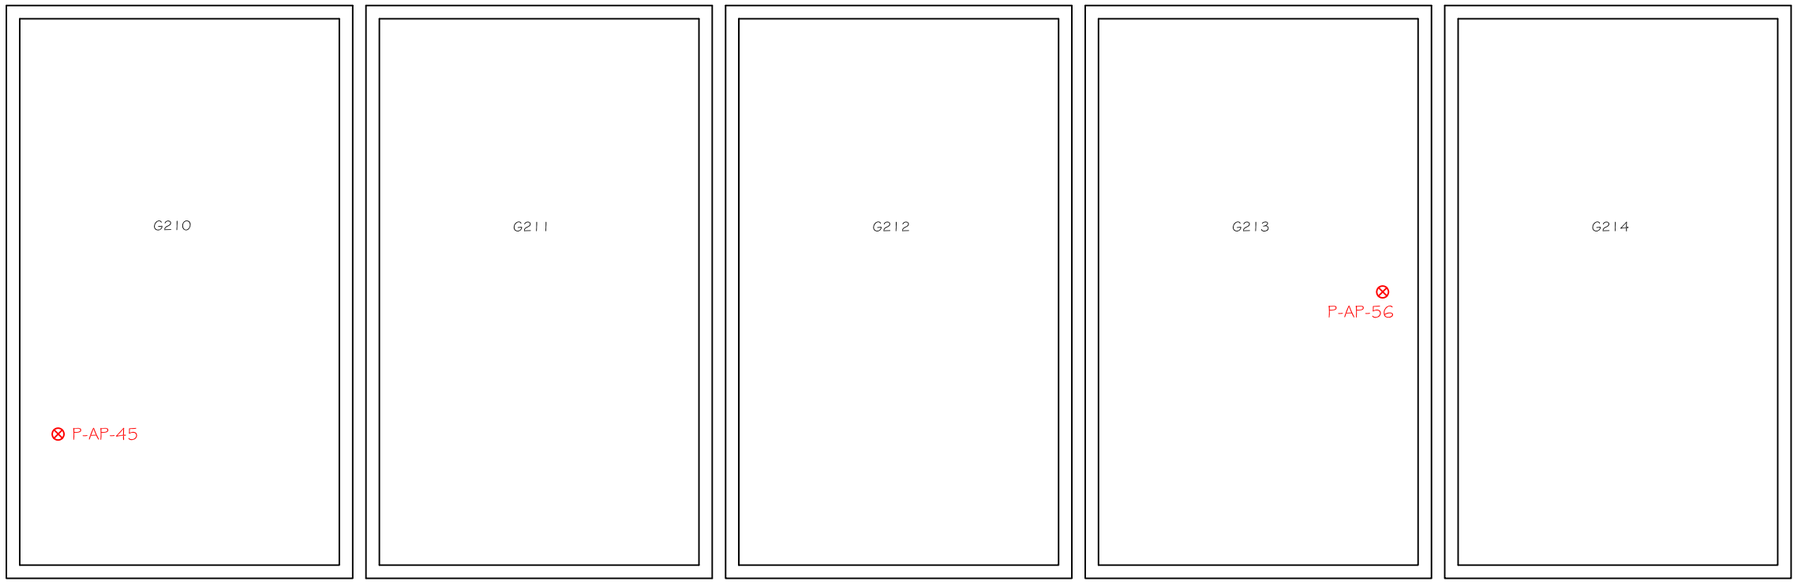


IDF-P - WIRELESS ACCESS POINT PLAN

SCALE: 3/32" = 1'-0"

LEGEND

⊗ WIRELESS ACCESS POINT

KEYMAP
NTS

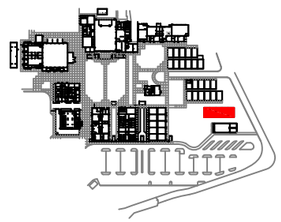

EASYNETWORKS CABLING
3538 SHELLEY WAY
RIVERSIDE, CA. 92503
OFFICE : 951. 742.8119
FAX : 951.742.8125
ST. LIC. # 936770

PREPARED FOR:

EL MONTE UNION HIGH SCHOOL DISTRICT

SITE:

SOUTH EL MONTE HIGH SCHOOL

1001 N. DURFEE AVE.
EL MONTE, CA 91733

AS-BUILT
PROJECT NO. 5231

REVISIONS:

	DATE:	DESCRIPTION:

DRAWN BY:
GERARDO MORALES

DATE: 10/9/12
SCALE: AS SHOWN
SIZE: 11x17

TITLE:

IDF-N WIRELESS ACCESS POINT PLAN

• PROPERTY OF EASY NETWORKS •
• FOR USE BY EASY NETWORK ONLY •

SHEET#:

T14

14 OF 14

EASY NETWORKS - 5231 IDF P., 10/17/2012 4:22:31 PM, 11 x 17

WIRELESS ACCESS POINT SCHEDULE			
AP #	**Mac Address**	**Asset Tag**	**LOCATION**
WHS-C.AP_31	002368930BB8	40773	Busdrive_Warehouse
WHS-B.AP_52	002368930BCC	36073	Warehouse
WHS-MDF.AP_58	002368930BC4	36133	New_Warehouse_Maintenance_BreakRoom



SECOND FLOOR - WIRELESS ACCESS POINT PLAN

SCALE: 1/32" = 1'-0"



FIRST FLOOR - WIRELESS ACCESS POINT PLAN

SCALE: 1/32" = 1'-0"

LEGEND

EASYNETWORKS CABLING

3538 SHELLEY WAY
RIVERSIDE, CA. 92503
OFFICE : 951. 742.8119
FAX : 951.742.8125
ST. LIC. # 936770

PREPARED FOR:

EL MONTE UNION HIGH SCHOOL DISTRICT

SITE:

MAINTENANCE FACILITIES

1003 N. DURFEE AVE.
EL MONTE, CA 91733

AS-BUILT
PROJECT No. 5231

REVISIONS:

#	DATE:	DESCRIPTION:

DRAWN BY: GERARDO MORALES

DATE: 10/25/12
SCALE: AS SHOWN
SIZE: 11x17

TITLE:

WIRELESS ACCESS POINT PLAN

• PROPERTY OF EASY NETWORKS •
• FOR USE BY EASY NETWORK ONLY •

SHEET#:

T1

1 OF 1

EASY NETWORK - 5231, 10/25/2012 11:52:42 AM, 11 x 17